

Optical Fibre & 4 Quad Cable Route Plan

(GONDA-BASTI)

NER


Submitted by:

M/s Karan Singh & Sons

84/22, Anand Vihar, Bagambari Road, Bharadhwaj Puram


Allahabad (U.P.)

Ph: (0532)-2503566, FAX: (0532)-2508241

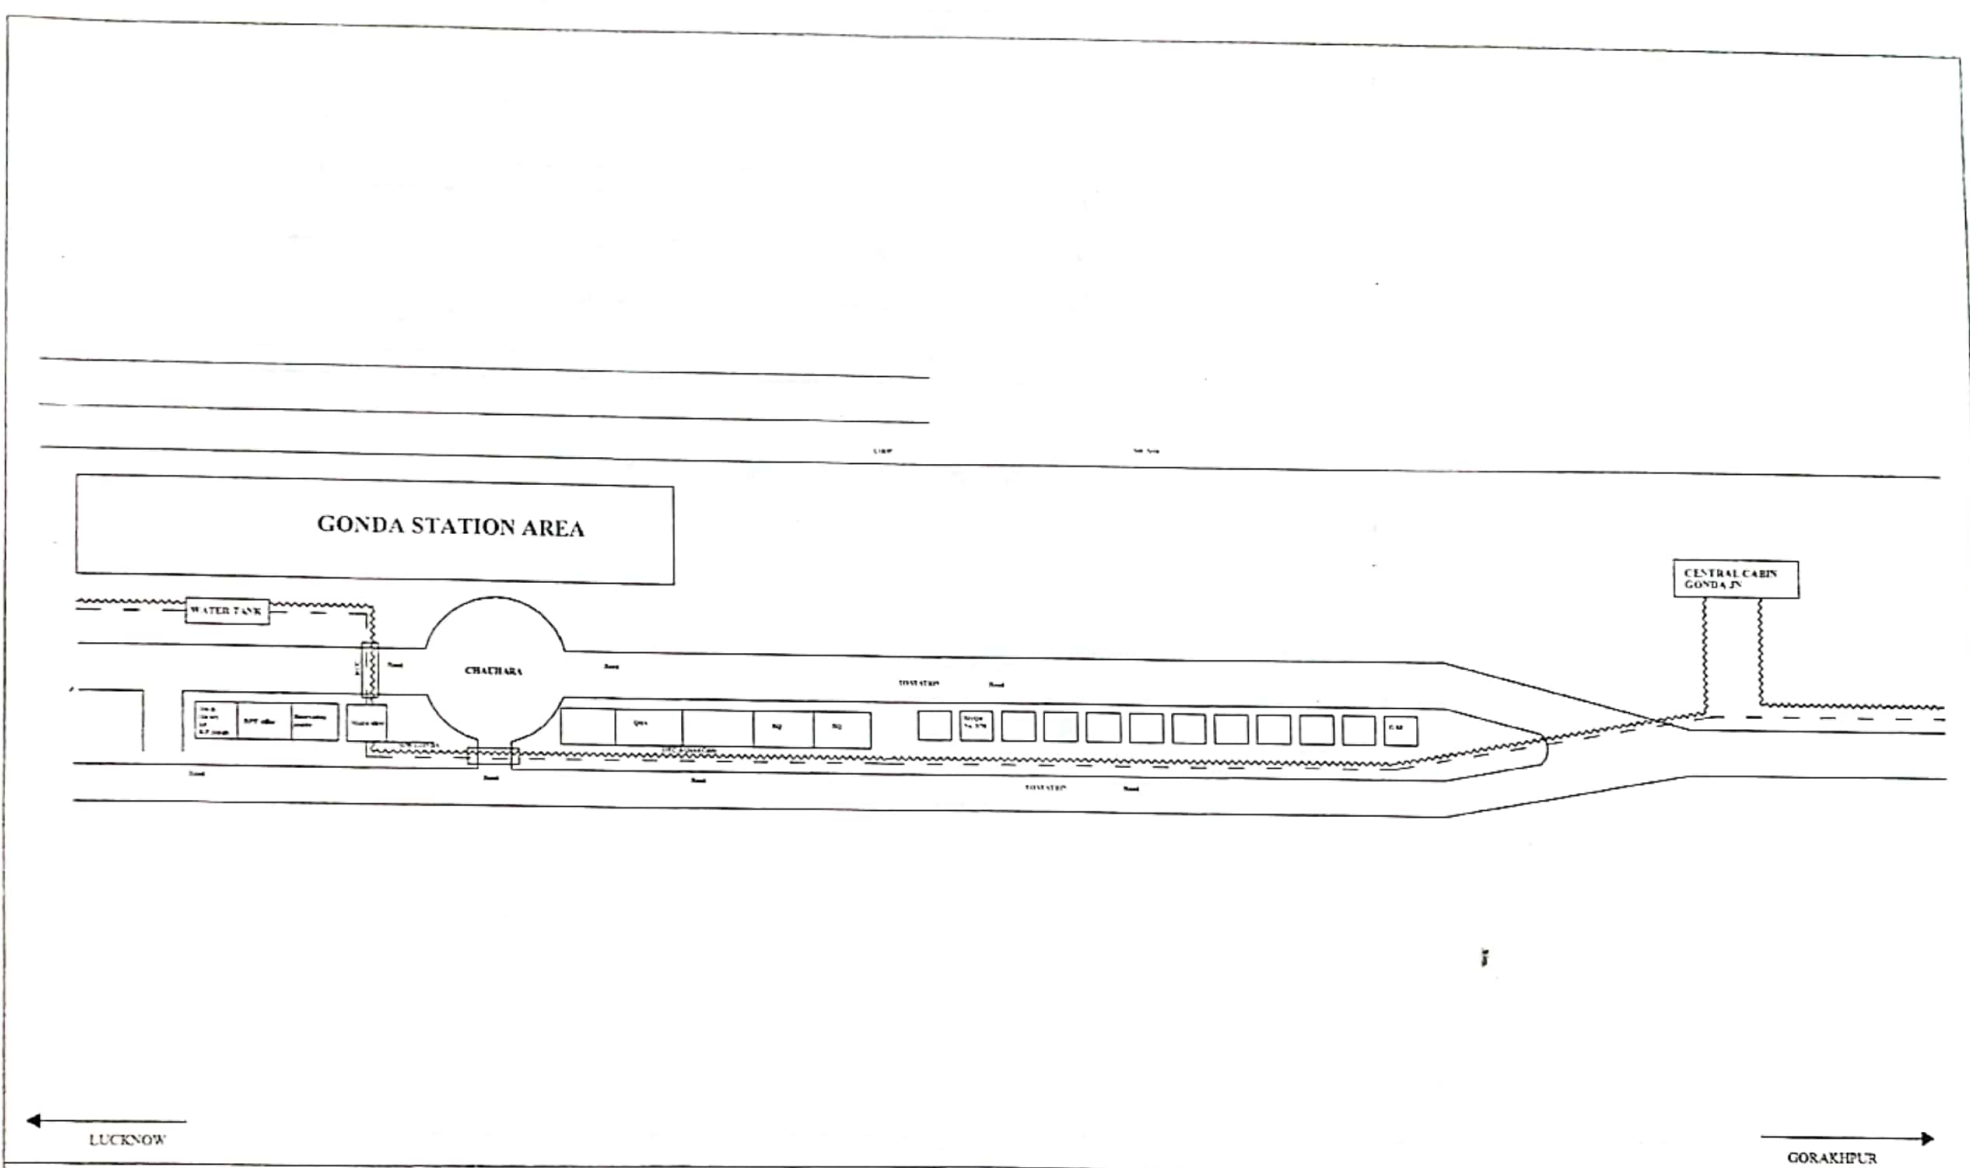

LEGENDS:

1. OFC Route :
2. 4 Quad Route :
3. Telecom Post :
4. G I/RCC Pipe :
5. Horizontal Dist. of OFC Route from Railway track :
6. Emergency Post :
7. OFC Joint :

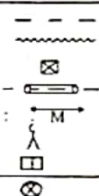

Sign - *SE/Con/S & T/NER*

Sign - *ASTE/Con/S & T/NER*

Sign - *Dy. CSTE (W)/Con/S & T/NER*


M s Karan Singh & Sons
Allahabad

(Sign of Contractor)

OFC Route Plan for Gonda - Basti Section of
NER

Sheet No. - 1 of 40

2. ST. THRU QD. JOINT

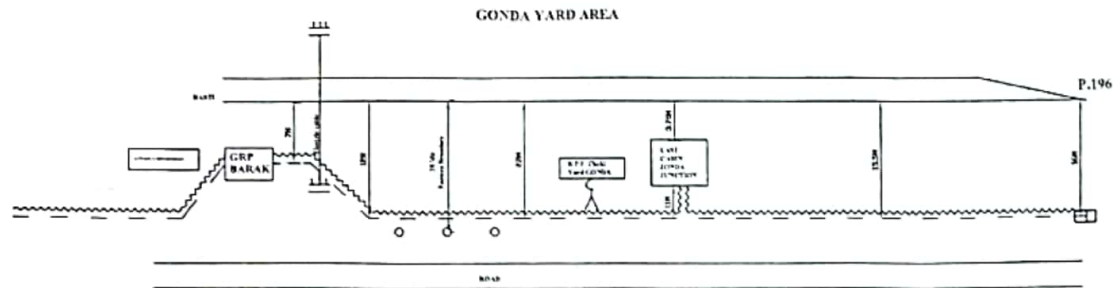



← LUCKNOW

→ GORAKHPUR

LEGENDS:

1. OFC Route :
2. 4 Quad Route :
3. Telecom Post :
4. G.I. RCC Pipe :
5. Horizontal Dist. of OFC Route from Railway track :
6. Emergency Post :
7. OFC Joint :

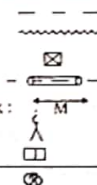

Sign - SE/Con/S & T/NER

Sign - ASTE/Con/S & T/NER

Sign - Dy. CSTE (W) Con/S & T/NER





M/s Karan Singh & Sons
Allahabad

(Sign of Contractor)

OFC Route Plan for Gonda - Basti Section of
NER

Sheet No. - 1 of 40

8. ST. THRU AD. JOINT.

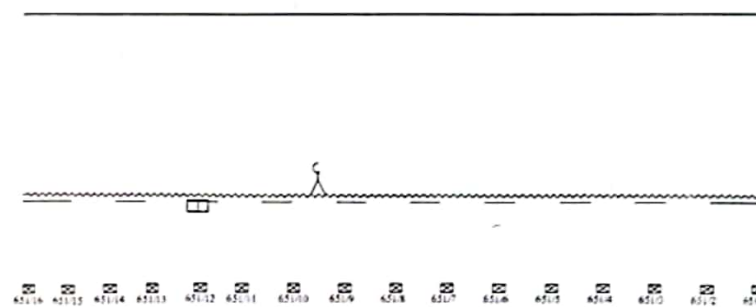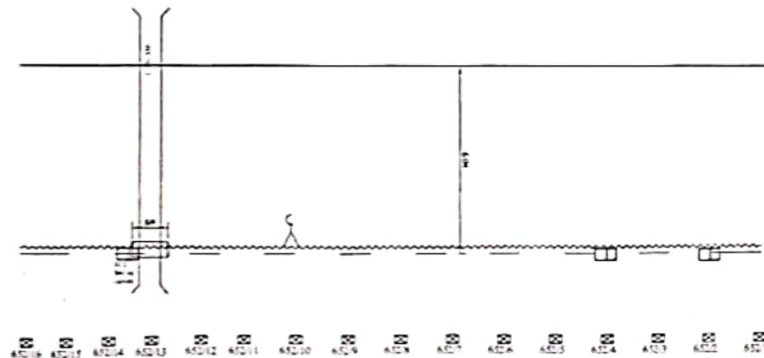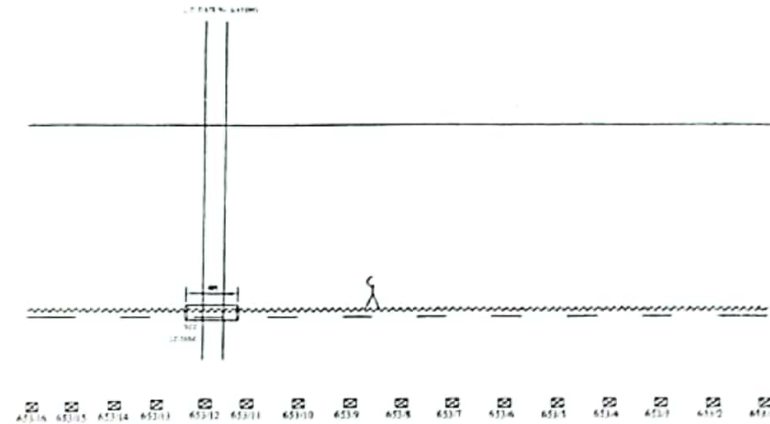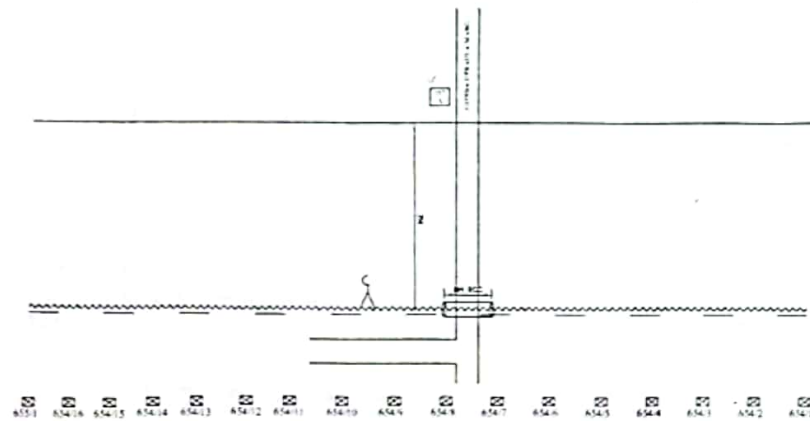


← LUCKNOW

→ GORAKHPUR

LEGENDS:

1. OFC Route :
2. 4 Quad Route :
3. Telecom Post :
4. G.I./RCC Pipe :
5. Horizontal Dist. of OFC Route from Railway track :
6. Emergency Post :
7. OFC Joint :

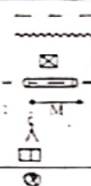

Sign - SE/Con S & T.NER

Sign - ASTE/Con S & T.NER

Sign - Dy. CSTE (W) Con S & T.NER


M/s Karan Singh & Sons
Allahabad

(Sign of Contractor)

OFC Route Plan for Gonda - Basti Section of
NER

Sheet No. - 2 of 40

8 ST THRU GD, JOINT.

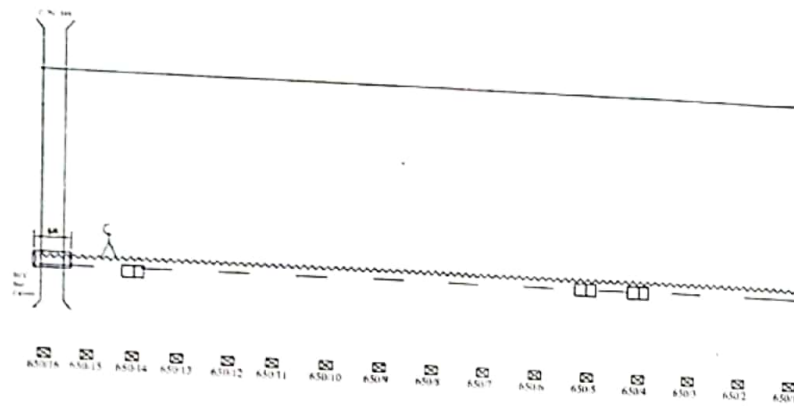


← LUCKNOW

→ GORAKHPUR

LEGENDS:

1. OFC Route :
2. 4 Quad Route :
3. Telecom Post :
4. GI / RCC Pipe :
5. Horizontal Dist. of OFC Route from Railway track :
6. Emergency Post :
7. OFC Joint :

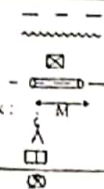

Sign - SE/Con/S & T/NER

Sign - ASTE/Con/S & T/NER

Sign - Dy. CSTE (W) Con/S & T/NER





M/s Karan Singh & Sons
Allahabad

(Sign of Contractor)

OFC Route Plan for Gonda - Basti Section of
NER

Sheet No. - 3 of 40

8. ST THRU QD JOINT.

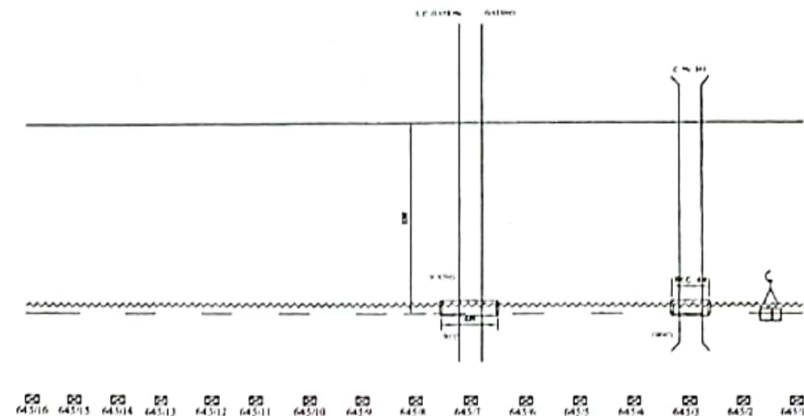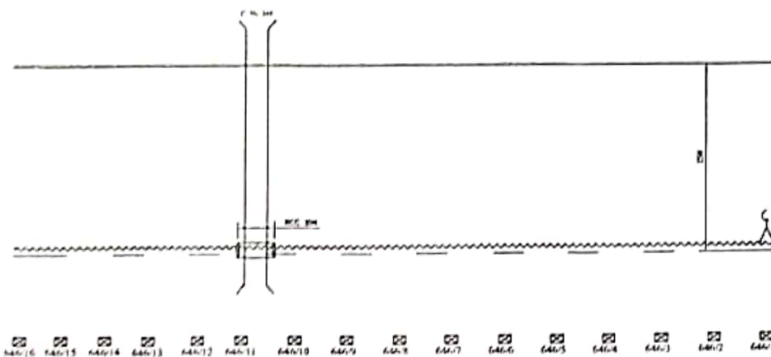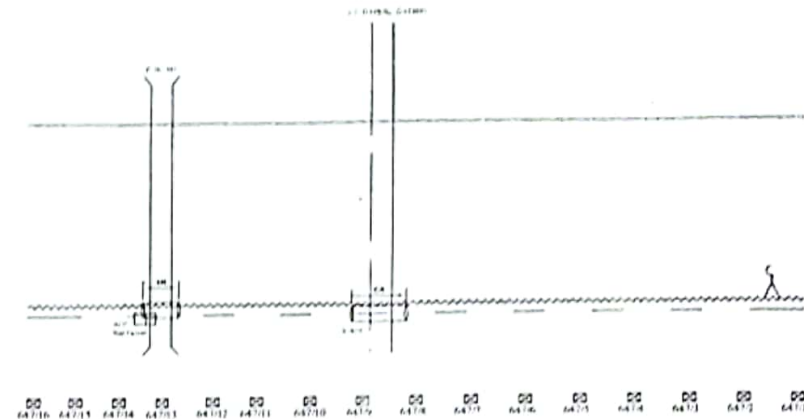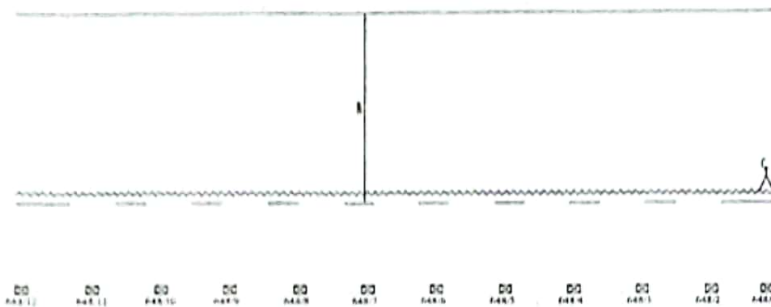


← LUCKNOW

→ GORAKHPUR

LEGENDS:

1. OFC Route :
2. 4 Quad Route :
3. Telecom Post :
4. G.I./RCC Pipe :
5. Horizontal Dist. of OFC Route from Railway track :
6. Emergency Post :
7. OFC Joint :

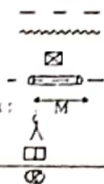

Sign - BE/Con/S & T/NER

Sign - ASTE/Con/S & T/NER



Sign - Dy. CSTE (W)/Con/S & T/NER

M/s Karan Singh & Sons
Allahabad
(Sign of Contractor)

OFC Route Plan for Gonda - Basti Section of
NER

Sheet No. - 5 of 40

8. ST. THRU Q.D. JOINT.

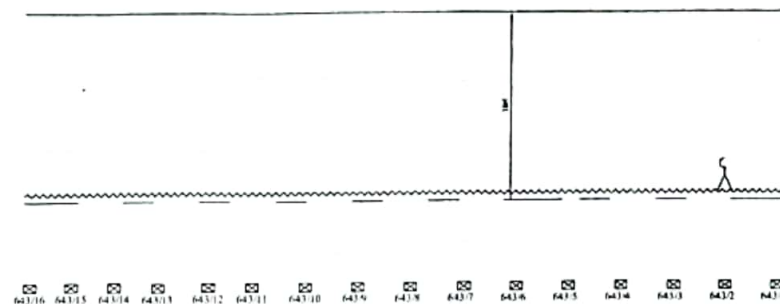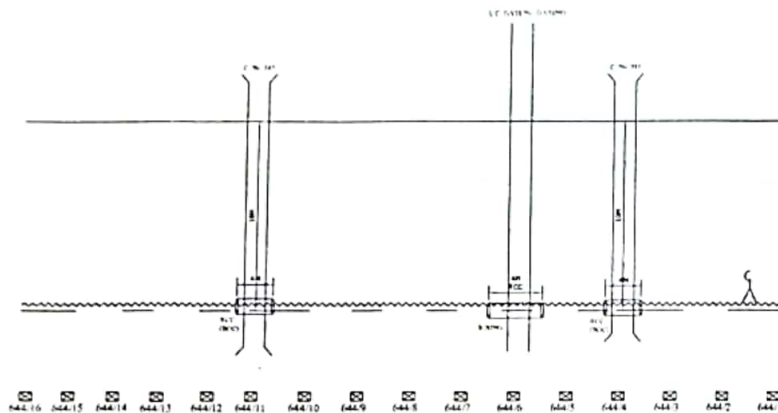


642/16 642/15 642/14 642/13

← LUCKNOW

→ GORAKHPUR

LEGENDS:

1. OFC Route :
2. 4 Quad Route :
3. Telecom Post :
4. G.L./RCC Pipe :
5. Horizontal Dist. of OFC Route from Railway track :
6. Emergency Post :
7. OFC Joint :

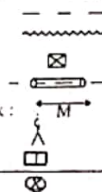

Sign - SE/Con/S & T/NER

Sign - ASTE/Con/S & T/NER

Sign - Dy. CSTE (W) Con/S & T/NER


M/s Karan Singh & Sons
Allahabad

(Sign of Contractor)

OFC Route Plan for Gonda - Basti Section of
NER

Sheet No. - 6 of 40

8- ST-THRU QD-JOINT.

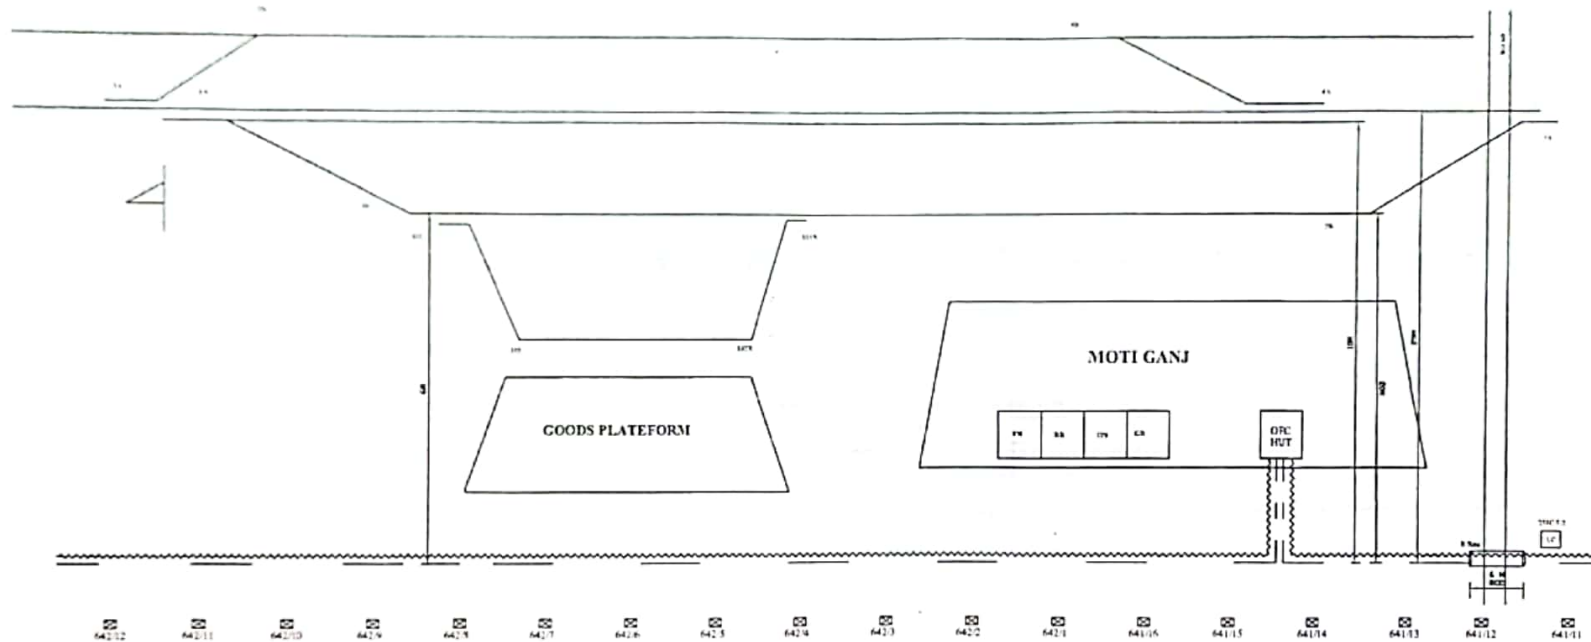


LUCKNOW

GORAKHPUR

LEGENDS:

1. OFC Route :
2. 4 Quad Route :
3. Telecom Post :
4. G.I./RCC Pipe :
5. Horizontal Dist. of OFC Route from Railway track :
6. Emergency Post :
7. OFC Joint :

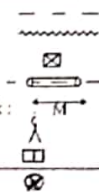

Sign - SE/Con/S & T/NER

Sign - ASTE/Con/S & T/NER

Sign - Dy. CSTE (W)/Con/S & T/NER





M/s Karan Singh & Sons
Allahabad

(Sign of Contractor)

OFC Route Plan for Gonda - Basti Section of
NER

Sheet No. - 7 of 40

8. ST. THRU QD. JOINT.

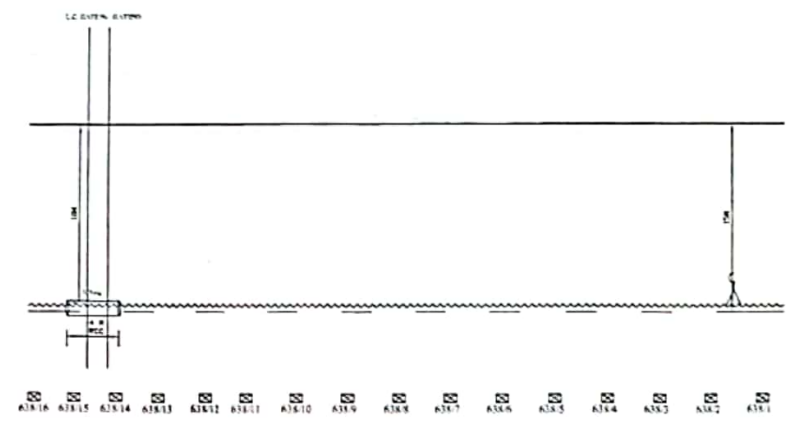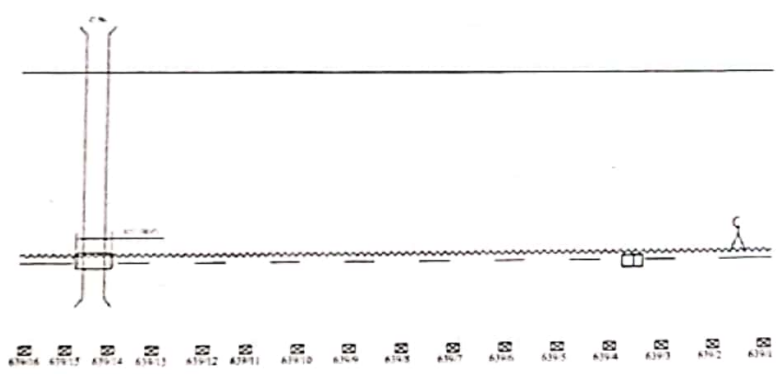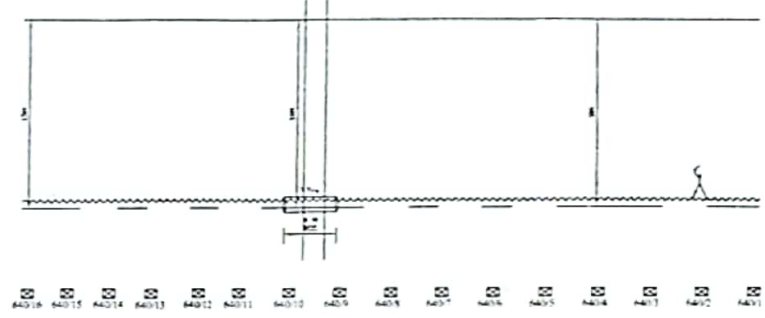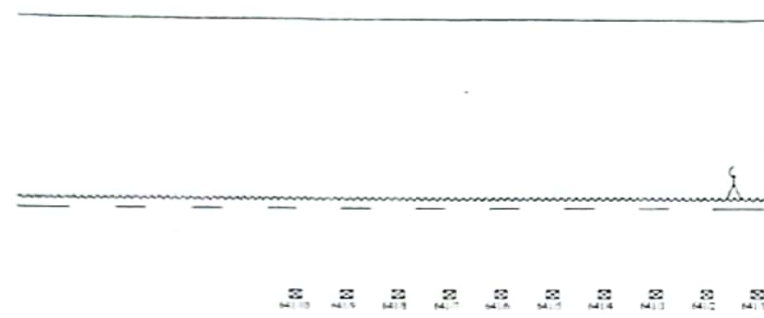


← LUCKNOW

→ GORAKHPUR

LEGENDS:

1. OFC Route :
2. 4 Quad Route :
3. Telecom Post :
4. G.I./RCC Pipe :
5. Horizontal Dist. of OFC Route from Railway track :
6. Emergency Post :
7. OFC Joint :

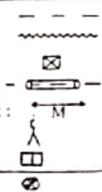

Sign - SE/Con/S & T/NER

Sign - ASTE/Con/S & T/NER

Sign - Dy. CSTE (W) Con/S & T/NER




M/s Karan Singh & Sons
Allahabad

(Sign of Contractor)

OFC Route Plan for Gonda - Basti Section of
NER

Sheet No. - 8 of 40

B. ST. THRU QD JOINT

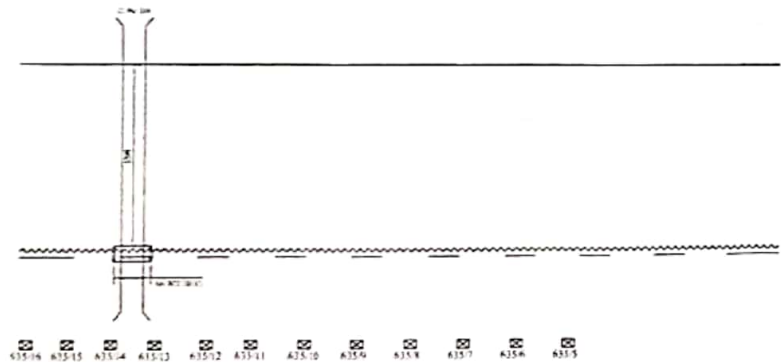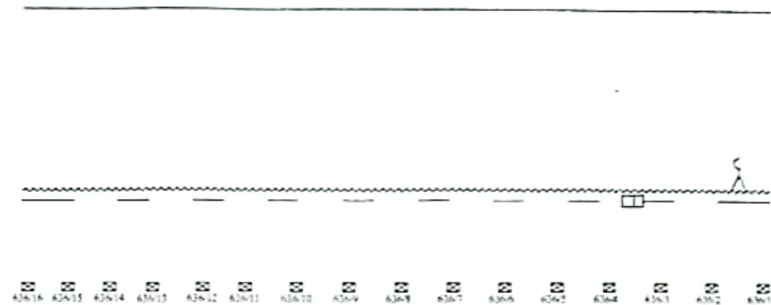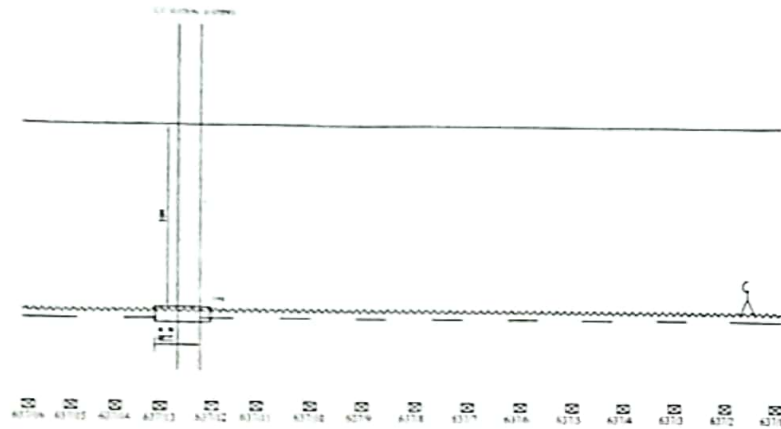


LUCKNOW

GORAKHPUR

LEGENDS:

1. OFC Route :
2. 4 Quad Route :
3. Telecom Post :
4. G.I./RCC Pipe :
5. Horizontal Dist. of OFC Route from Railway track :
6. Emergency Post :
7. OFC Joint :

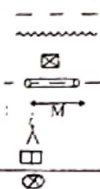

Sign - SE/Con/S & T/NER

Sign - ASTE/Con/S & T/NER

Sign - Dy. CSTE (W)/Con/S & T/NER


M/s Karan Singh & Sons
Allahabad

(Sign of Contractor)

OFC Route Plan for Gonda - Basti Section of
NER

Sheet No. - 9 of 40

8. ST. THRU QD. JOINT.

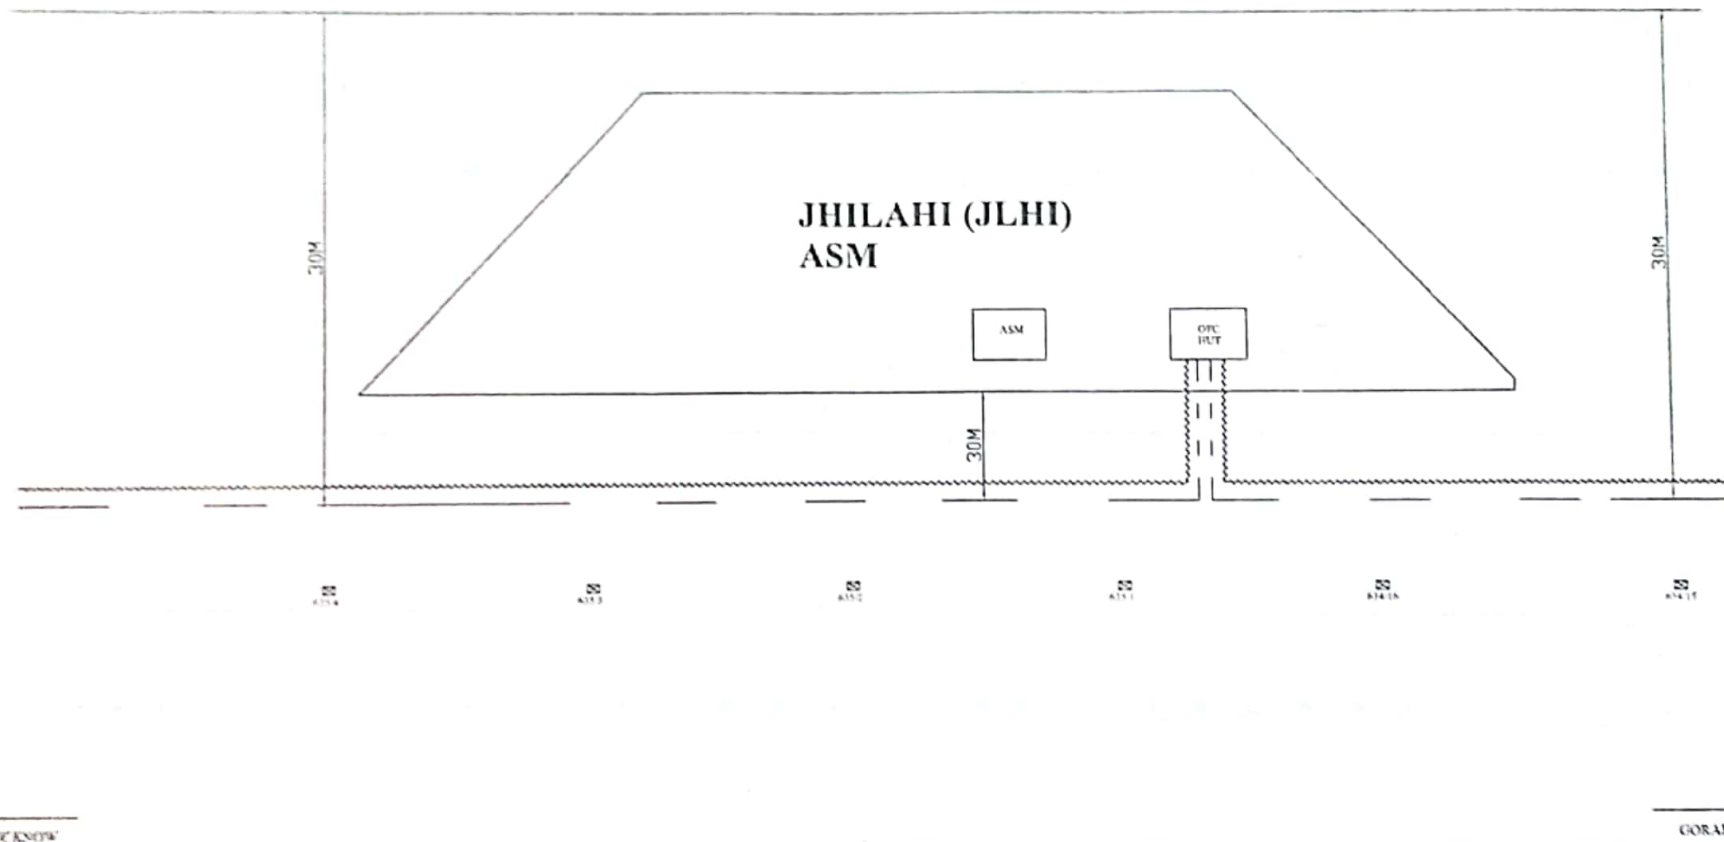

LEGENDS:

1. OFC Route :
2. 4 Quad Route :
3. Telecom Post :
4. GI/RCC Pipe :
5. Horizontal Dist. of OFC Route from Railway track :
6. Emergency Post :
7. OFC Joint :



Sign - SE/Con S & T/NER

Sign - ASTE/Con S & T/NER

Sign - Dy. CSTE (W) Con S & T/NER





M/s Karan Singh & Sons
Allahabad

(Sign of Contractor)

OFC Route Plan for Gonda - Basti Section of
NER

Sheet No. - 10 of 40

8. ST THRU GD JOINT.

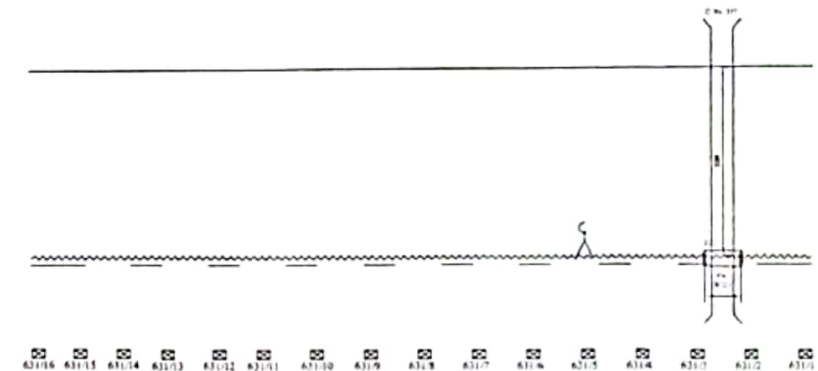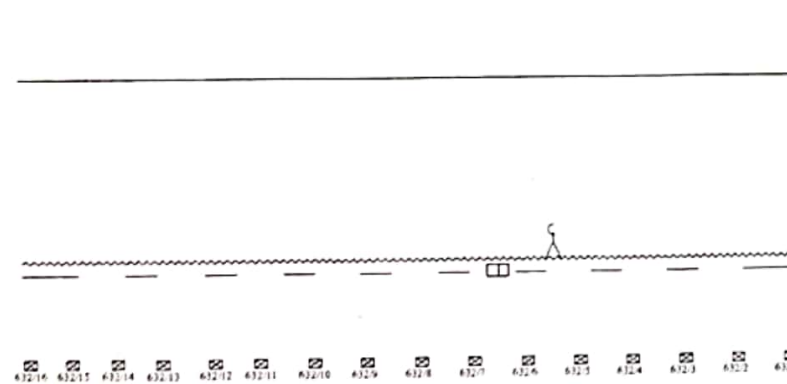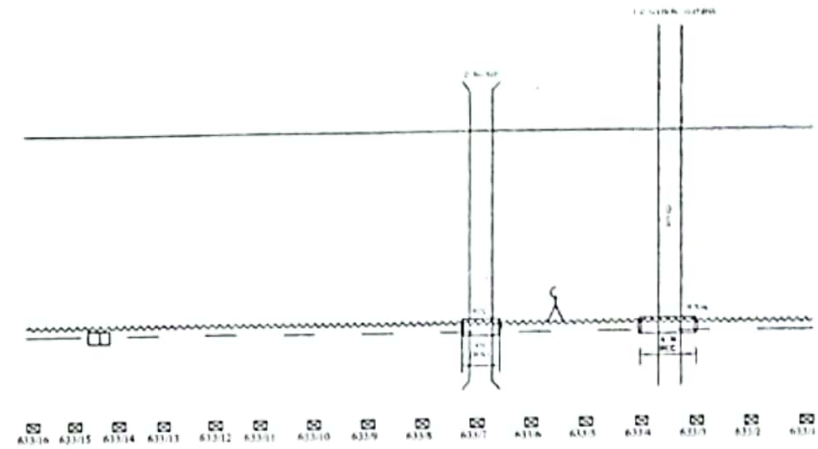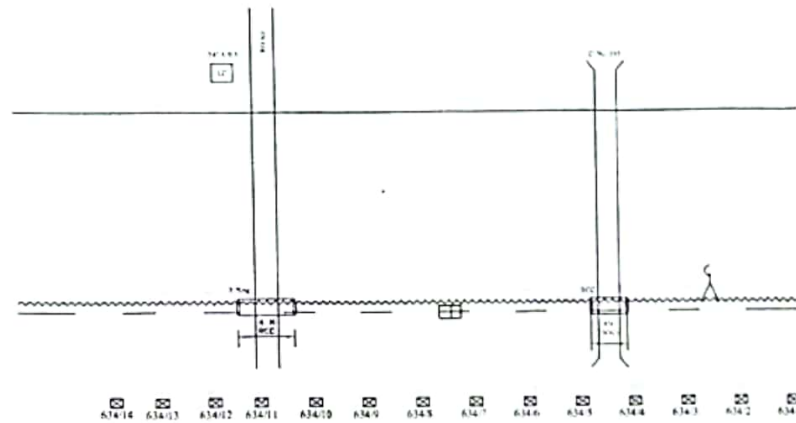


← LUCKNOW

→ GORAKHPUR

LEGENDS:

1. OFC Route :
2. 4 Quad Route :
3. Telecom Post :
4. G.I./RCC Pipe :
5. Horizontal Dist. of OFC Route from Railway track :
6. Emergency Post :
7. OFC Joint :

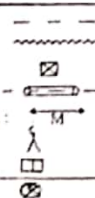

Sign - 5 H/Con/S & T/NER


Sign - ASTE/Con/S & T/NER





Sign - Dy. CSTE (W) Con/S & T/NER

M/s Karan Singh & Sons
Allahabad
(Sign of Contractor)

OFC Route Plan for Gonda - Basti Section of
NER
Sheet No. - 11 of 40

2- ST. THRU JOINT

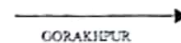

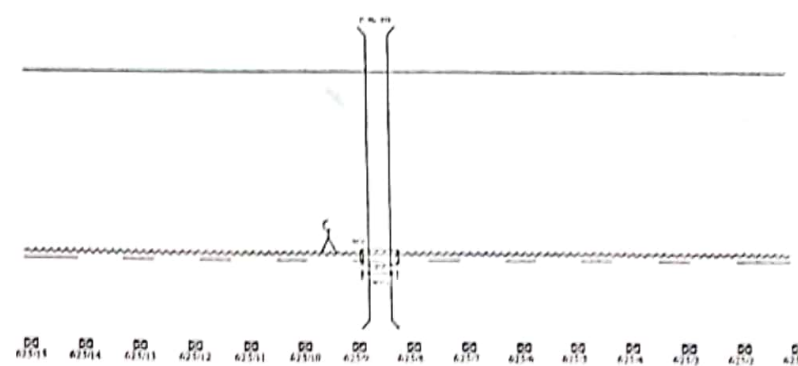
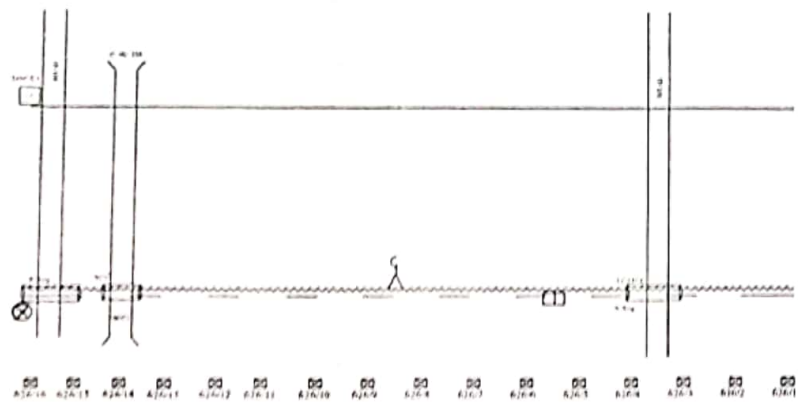
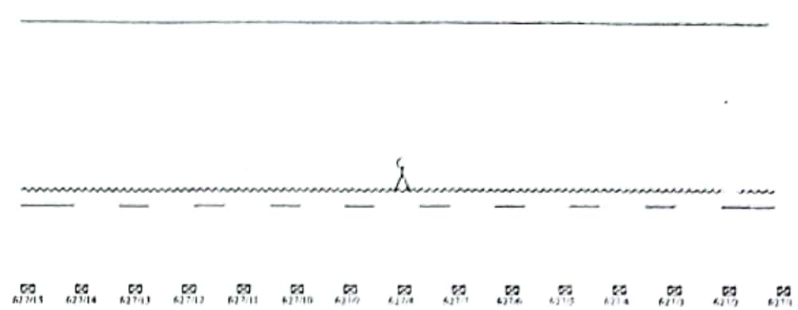
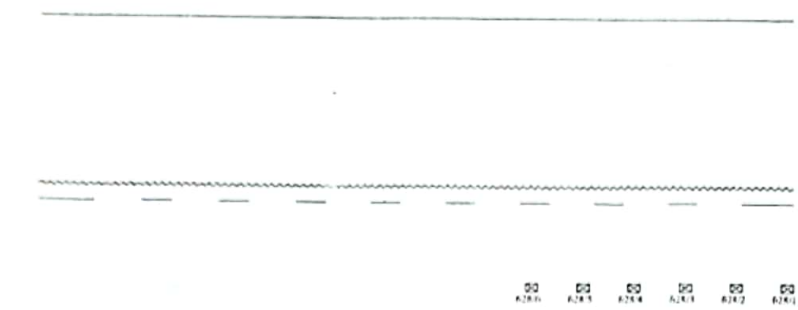


← LUCKNOW

→ GORAKHPUR

LEGENDS:

1. OFC Route :
2. 4 Quad Route :
3. Telecom Post :
4. O.I./RCC Pipe :
5. Horizontal Dist. of OFC Route from Railway track :
6. Emergency Post :
7. OFC Joint :

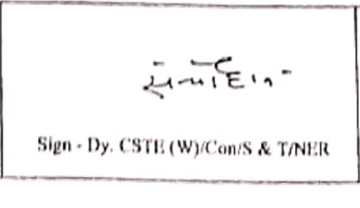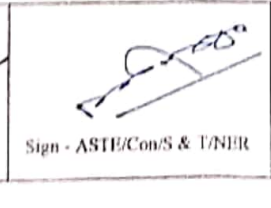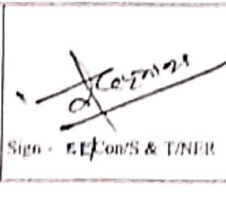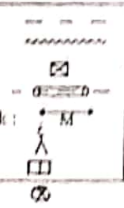


M/s Karan Singh & Sons
Allahabad

(Sign of Contractor)

OFC Route Plan for Gonda - Basti Section of
NER

Sheet No. - 14 of 40

AT THRO. JOINT

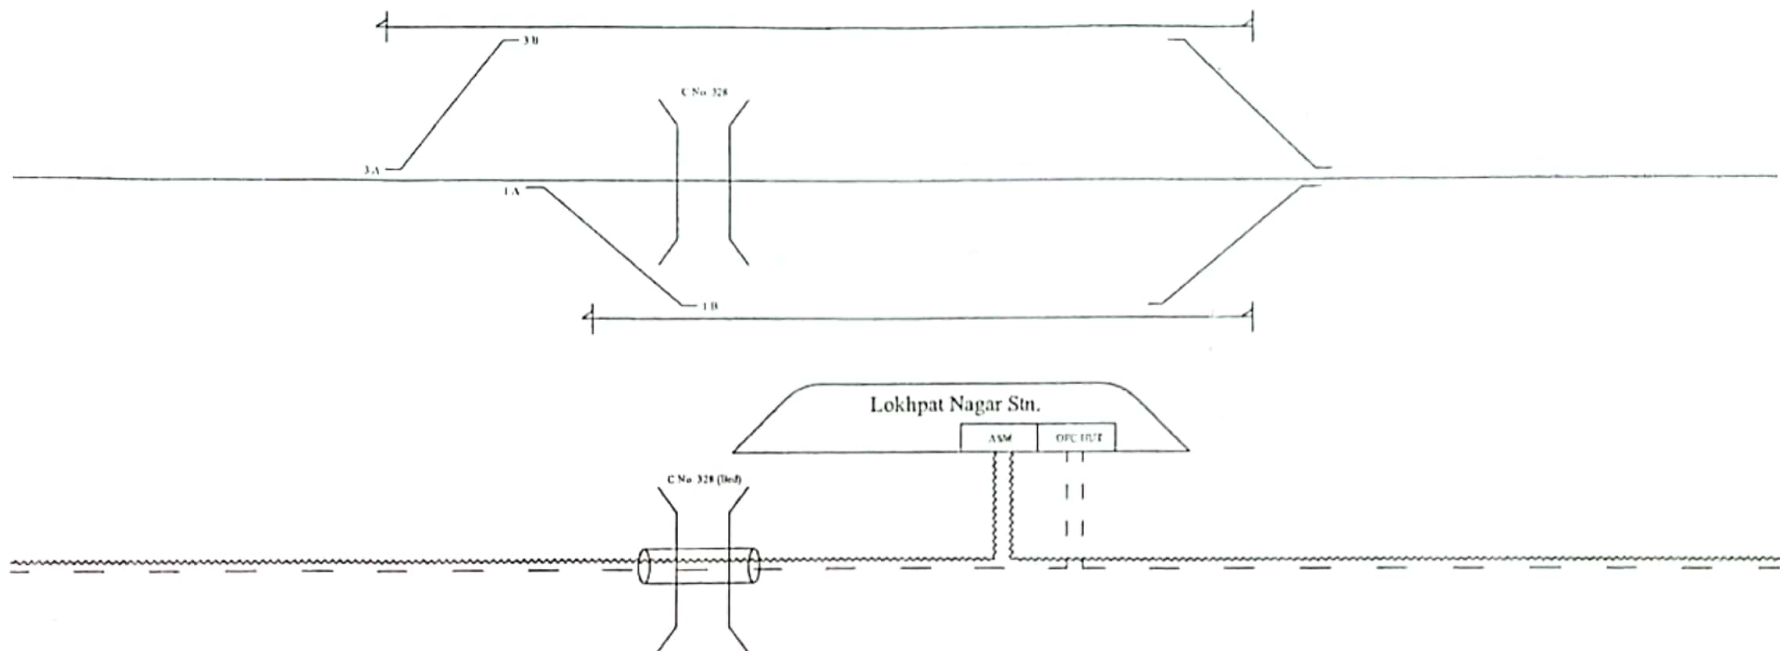

624/15 624/14 624/13 624/12 624/11 624/10 624/9 624/8 624/7 624/6 624/5 624/4 624/3 624/2 624/1 623/15 623/14 623/13 623/12 623/11 623/10

← LUCKNOW

→ GORAKHPUR

LEGENDS:

1. OFC Route :
2. 4 Quad Route :
3. Telecom Post :
4. G.I./RCC Pipe :
5. Horizontal Dist. of OFC Route from Railway track :
6. Emergency Post :
7. OFC Joint :



Sign - S.K. Con/S & T/NER

Sign - ASTE/Con/S & T/NER

Sign - Dy. CSTE (W) Con/S & T/NER


M/s Karan Singh & Sons
Allahabad

(Sign of Contractor)

OFC Route Plan for Gonda - Basti Section of
NER


Sheet No. - 16 of 40

8. ST THRU QD JOINT

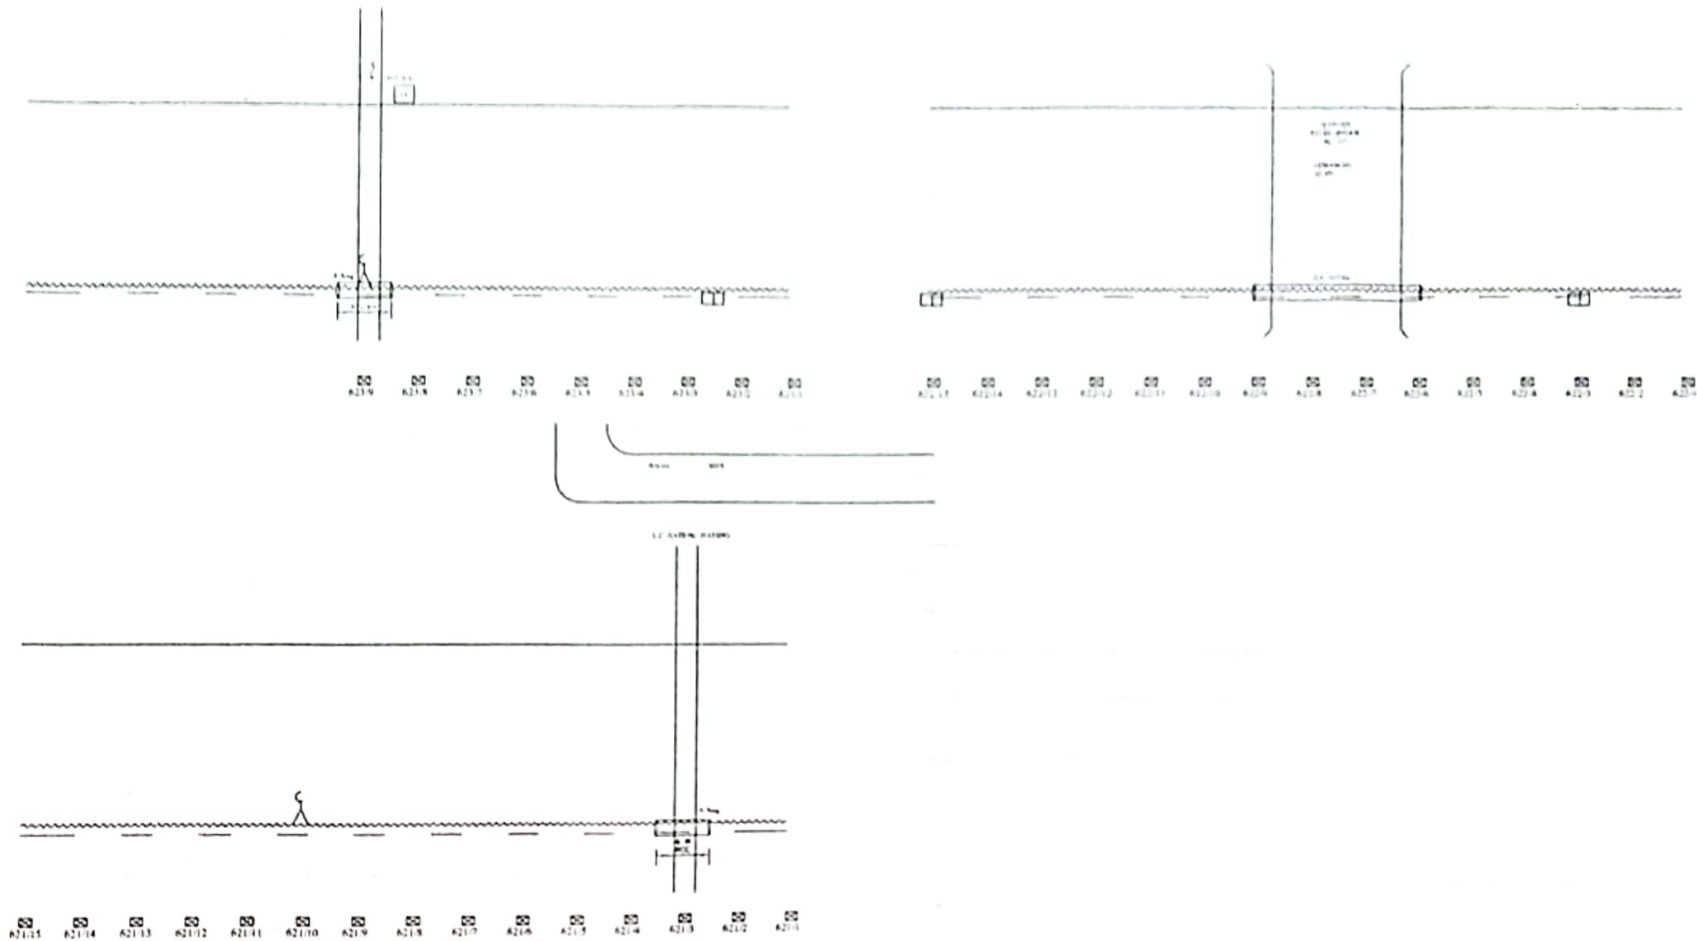

LEGENDS:

1. OFC Route :
2. 4 Quad Route :
3. Telecom Post :
4. G.I./RCC Pipe :
5. Horizontal Dist. of OFC Route from Railway track :
6. Emergency Post :
7. OFC Joint :

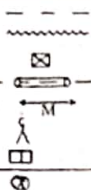

Sign - SE / Con'S & T/NER

Sign - ASTE/Con'S & T/NER

Sign - Dy. CSTE (W)-Con'S & T/NER



M/s Karan Singh & Sons
Allahabad

(Sign of Contractor)

OFC Route Plan for Gonda - Basti Section of
NER

Sheet No. - 17 of 40

B-ST. THRU QD. JOINT.

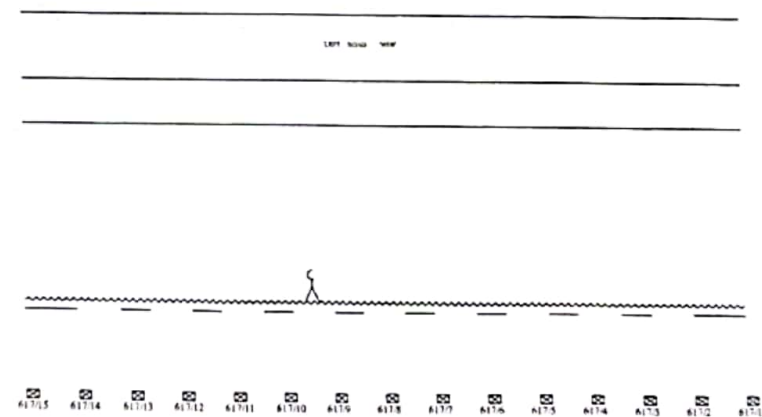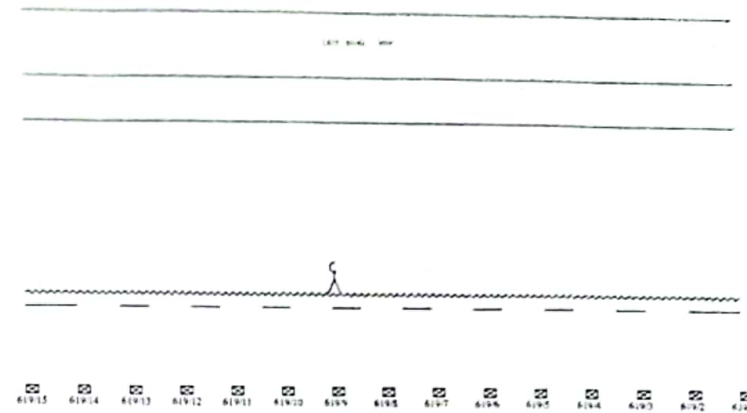

GORAKHPUR


Sign - ASTE/Cen/S & T/NER

M/s Karan Singh & Sons
Allahabad

(Sign of Contractor)


Sheet No. - 18 of 40

B. ST. THRU @D. JOINT.

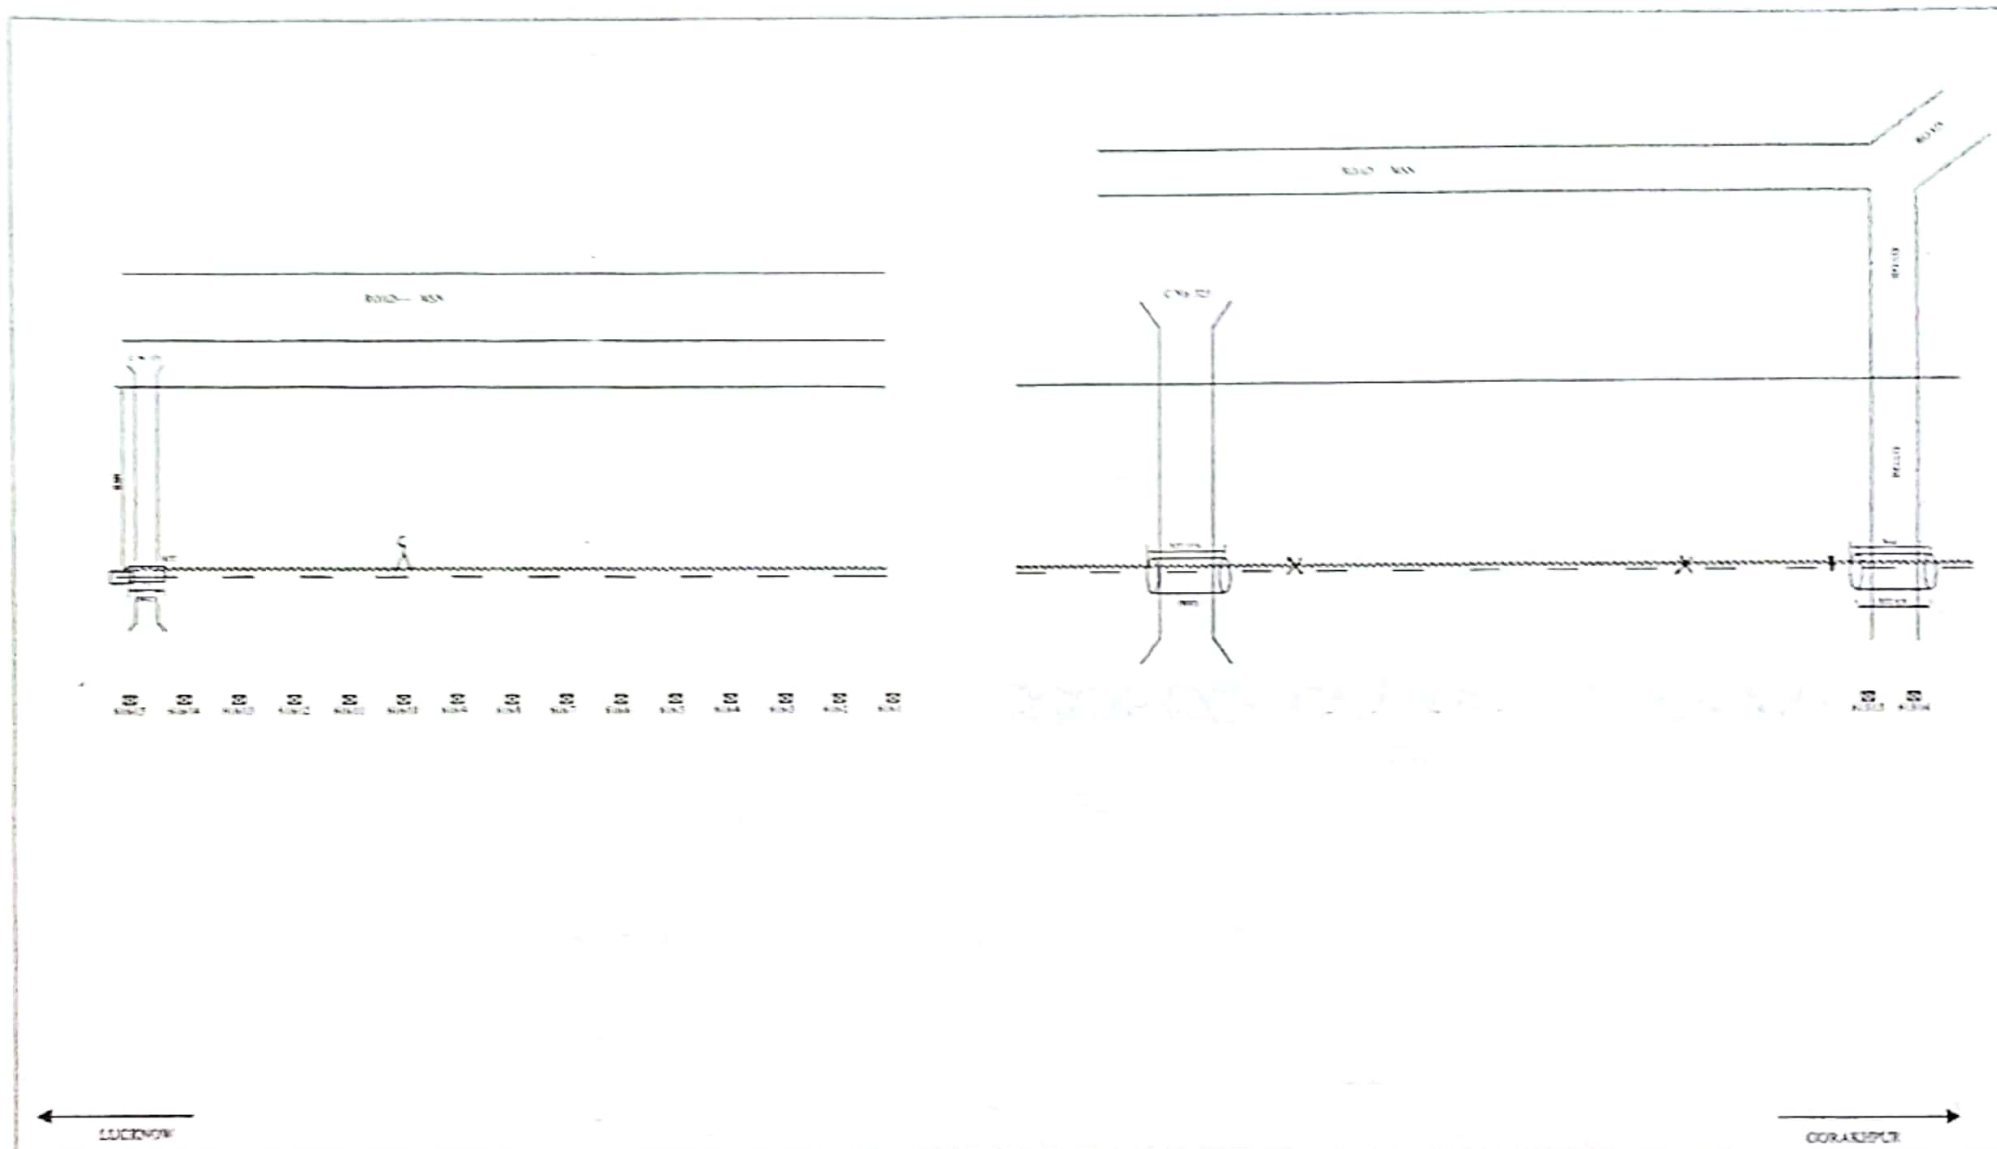

LEGENDS:

1. OFC Route :
2. 4 Quad Route :
3. Telecom Post :
4. G.I./RCC Pipe :
5. Horizontal Dist. of OFC Route from Railway track :
6. Emergency Post :
7. OFC Joint :
8. ST. THROUGH JOINT :

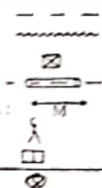

Sign - SE/Con/S & T/NER

Sign - ASTE/Con/S & T/NER


Sign - Dy. CSTE (W) Con/S & T/NER

M's Karan Singh & Sons
Allahabad

(Sign of Contractor)


OFC Route Plan for Gonda - Basti Section of
NER

Sheet No. - 19 of 40

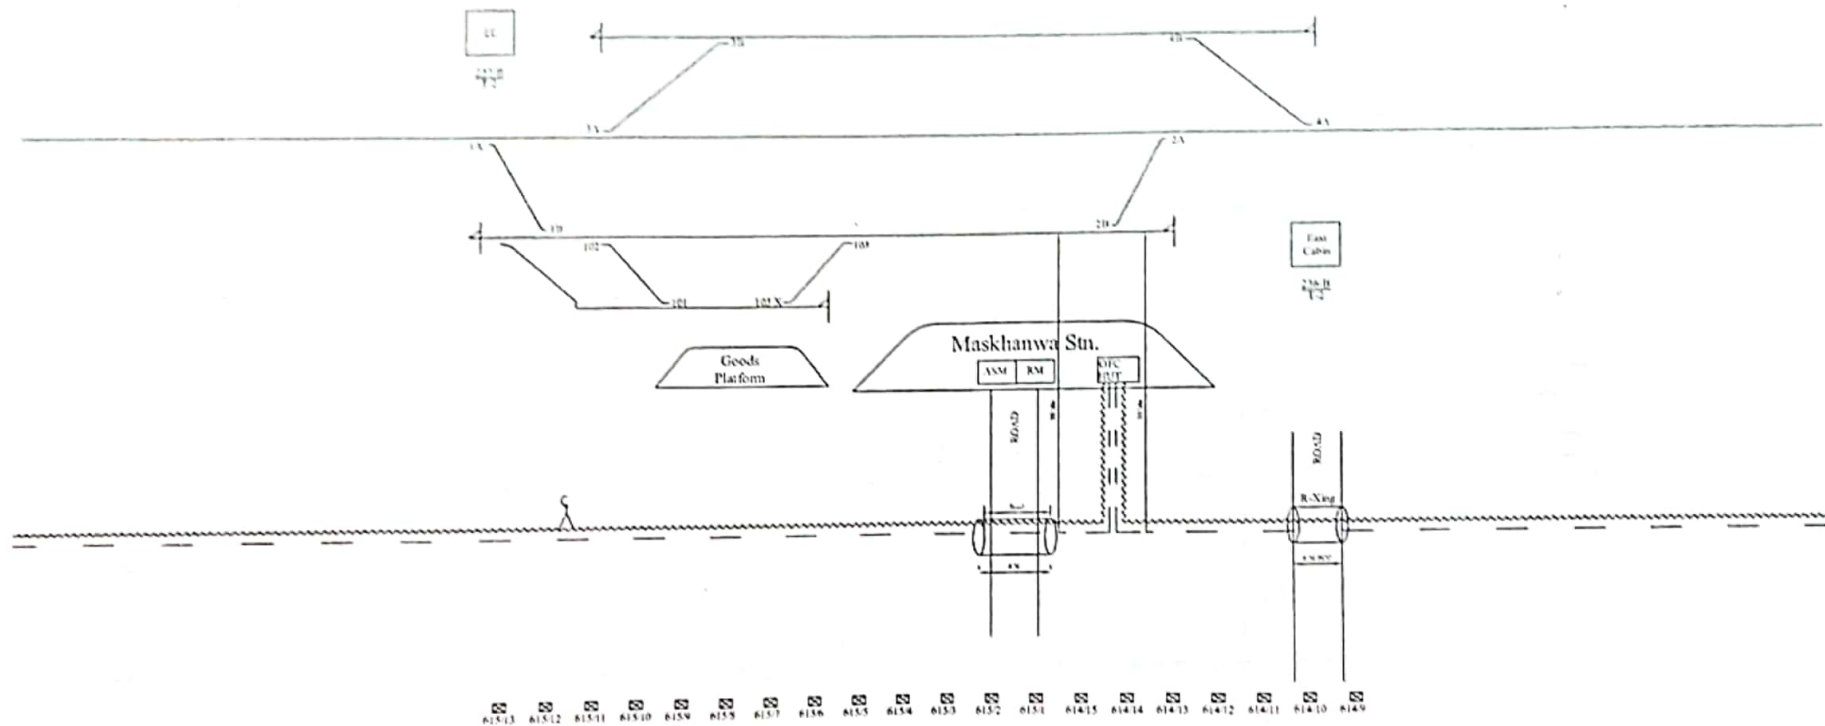

LEGENDS:

1. OFC Route :
2. 4 Quad Route :
3. Telecom Post :
4. G.I./RCC Pipe :
5. Horizontal Dist. of OFC Route from Railway track :
6. Emergency Post :
7. OFC Joint :

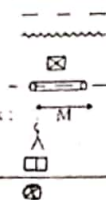

Sign - SE/Con/S & T/NER

Sign - ASTE/Con/S & T/NER

Sign - Dy. CSTE (W) Con/S & T/NER


(Sign of Contractor)

M/s Karan Singh & Sons
Allahabad


OFC Route Plan for Gonda - Basti Section of
NER

Sheet No. - 20 of 40


8. ST. THRU QD. JOINT.

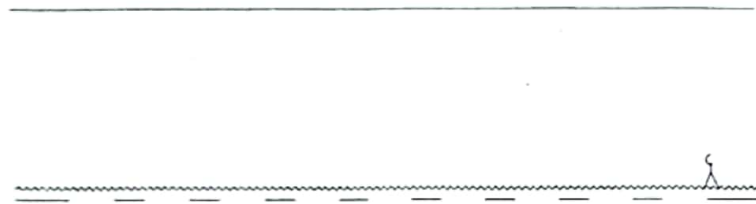


6143 6144 6145 6146 6147 6148 6149 6150

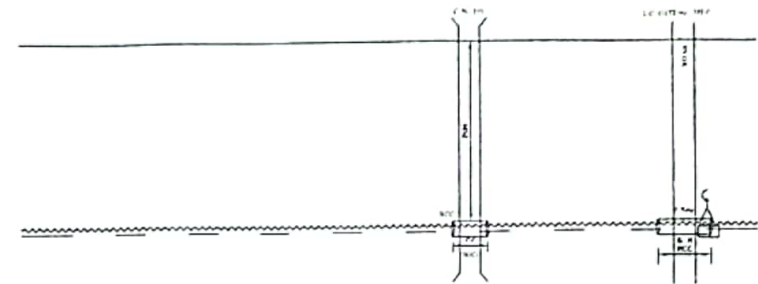

6131 6132 6133 6134 6135 6136 6137 6138 6139 6140 6141 6142 6143 6144 6145 6146 6147 6148 6149 6150

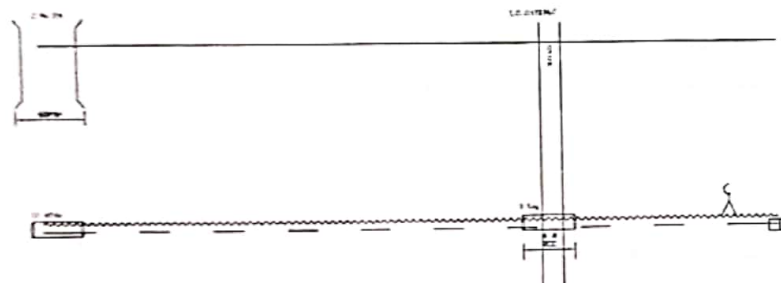

6121 6122 6123 6124 6125 6126 6127 6128 6129 6130 6131 6132 6133 6134 6135 6136 6137 6138 6139 6140

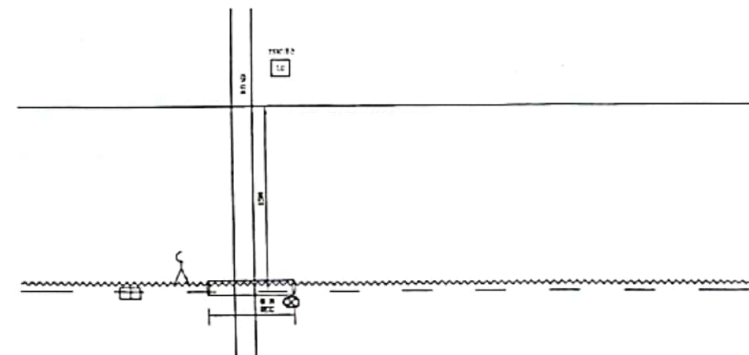


6111 6112 6113 6114 6115 6116 6117 6118 6119 6120 6121 6122 6123 6124 6125 6126 6127 6128 6129 6130

LUCKNOW

GORAKHPUR

LEGENDS:

1. OFC Route :
2. 4 Quad Route :
3. Telecom Post :
4. G.I./RCC Pipe :
5. Horizontal Dist. of OFC Route from Railway track :
6. Emergency Post :
7. OFC Joint :

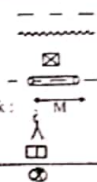

Sign - SE/Con/S & T/NER

Sign - ASTE/Con/S & T/NER

Sign - Dy. CSTE (W)/Con/S & T/NER


M/s Karan Singh & Sons
Allahabad

(Sign of Contractor)





OFC Route Plan for Gonda - Basti Section of
NER

Sheet No. - 21 of 40

8- ST. THRU GP JOINT.

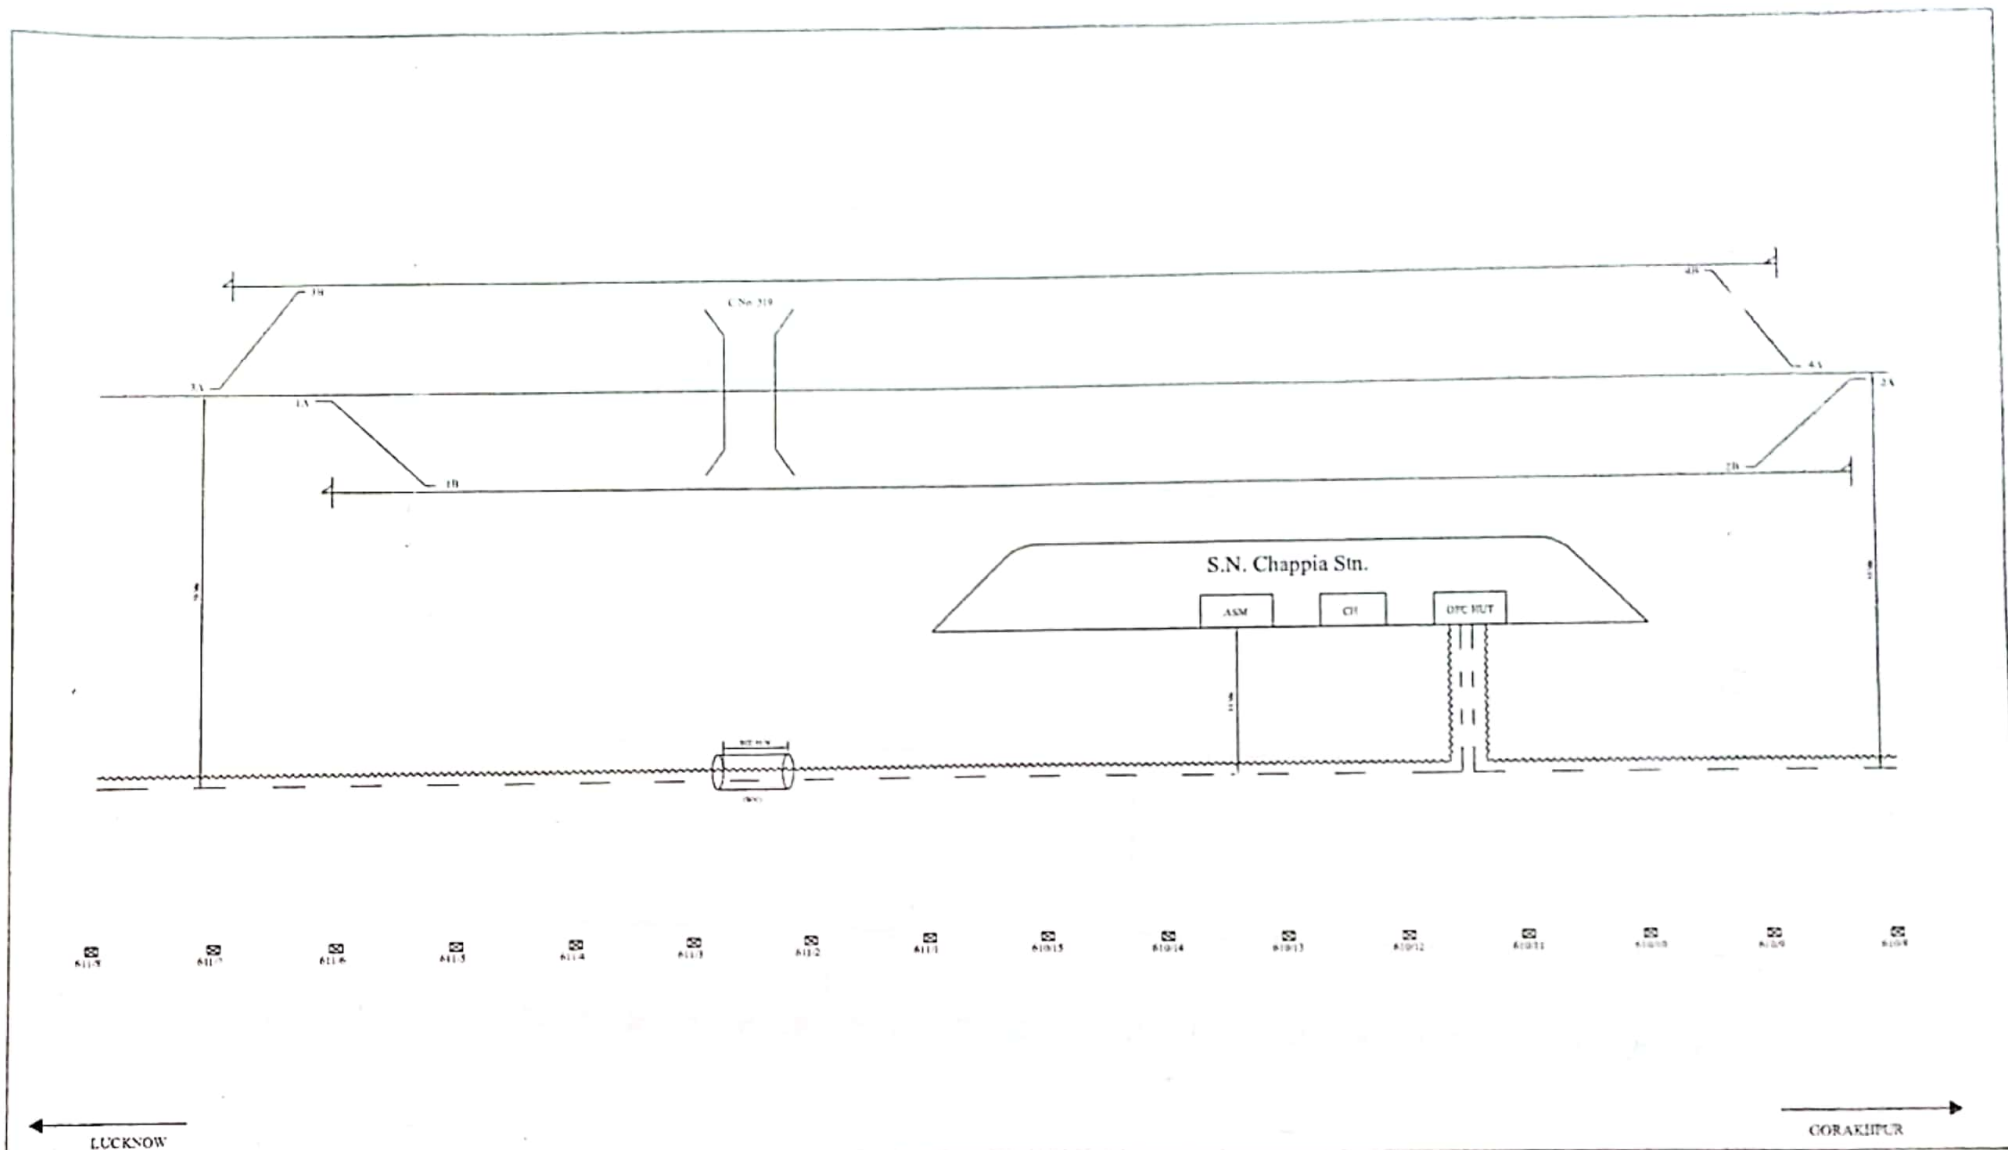

LEGENDS: 1. OFC Route : 2. 4 Quad Route : 3. Telecom Post : 4. G.I./RCC Pipe : 5. Horizontal Dist. of OFC Route from Railway track : 6. Emergency Post : 7. OFC Joint : 8. ST. THRU OD. JOINT.		 	 Sign - SE/Con/S & T/NER	 Sign - ASTE/Con/S & T/NER	 Sign - Dy. CSTE (W) Con/S & T/NER	M/s Karan Singh & Sons Allahabad (Sign of Contractor)	OFC Route Plan for Gonda - Basti Section of NER Sheet No. - 22 of 40
---	--	--------------------------	-----------------------------	-------------------------------	---------------------------------------	---	--

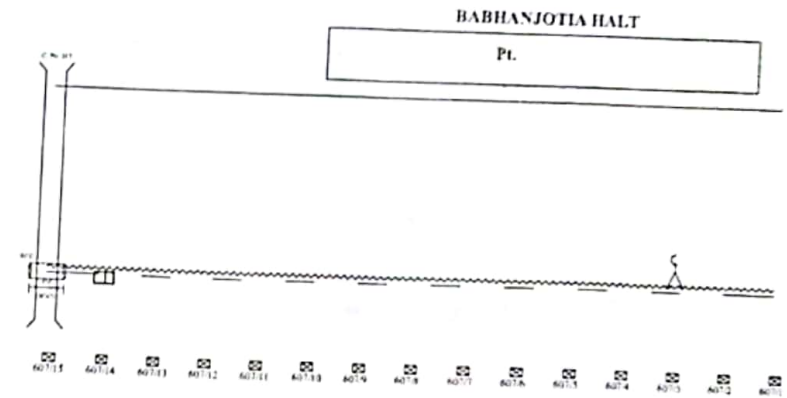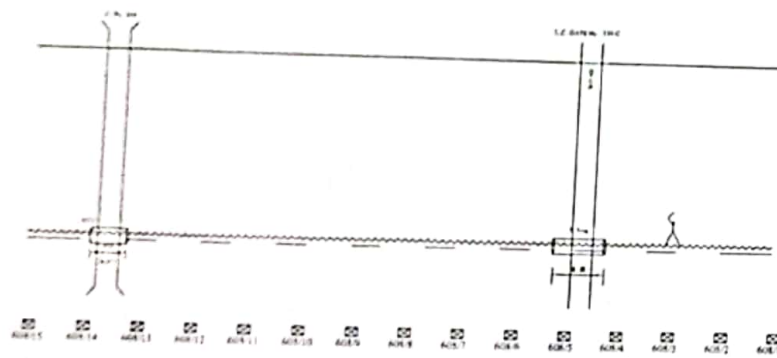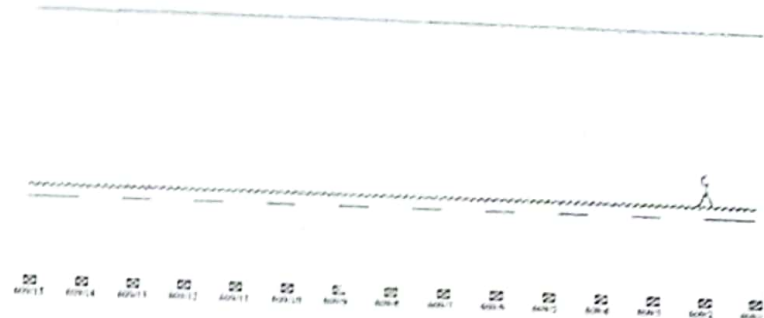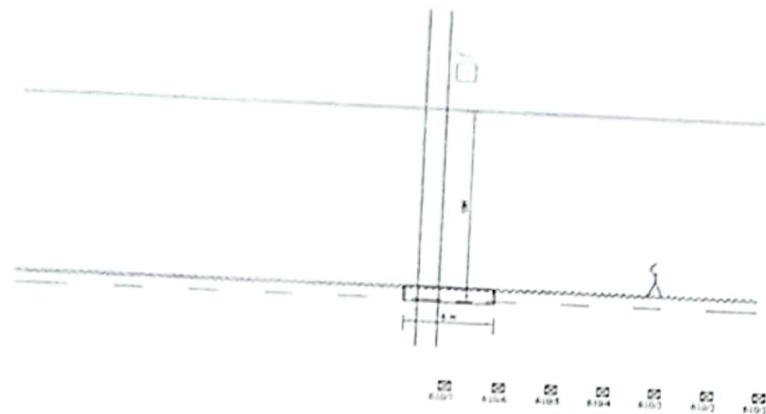

BABHANJOTIA HALT

PL

LUCKNOW

GORAKHPUR

LEGENDS:

1. OFC Route :
2. 4 Quad Route :
3. Telecom Post :
4. G.I./RCC Pipe :
5. Horizontal Dist. of OFC Route from Railway track :
6. Emergency Post :
7. OFC Joint :



Sign - SE/Con/S & T/NER





Sign - ASTE/Con/S & T/NER

Sign - Dy. CSTE (W)/Con/S & T/NER

M/s Karan Singh & Sons
Allahabad
(Sign of Contractor)

OFC Route Plan for Gonda - Basti Section of
NER
Sheet No. - 23 of 40

8. ST. THRU QD. JOINT.

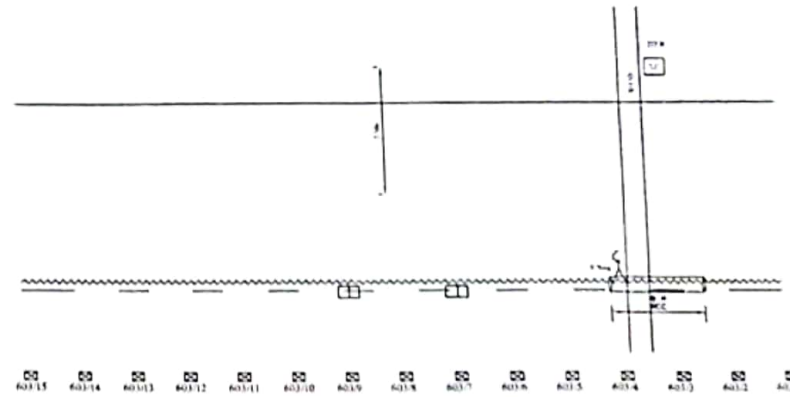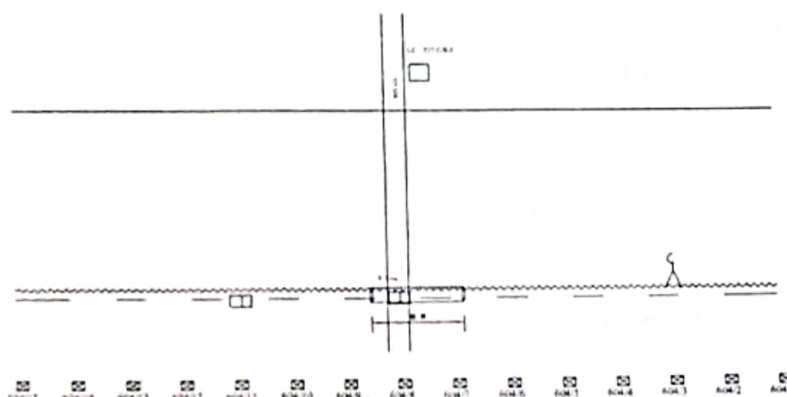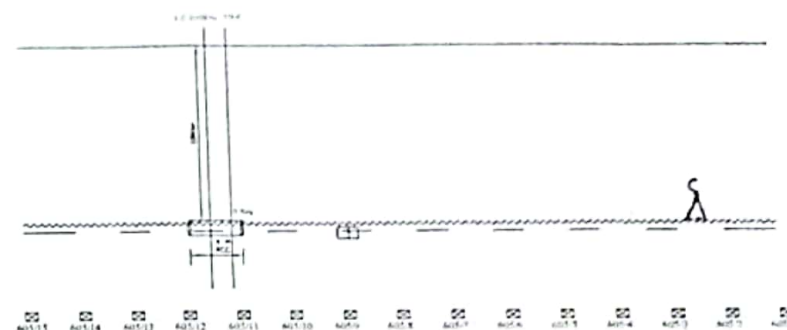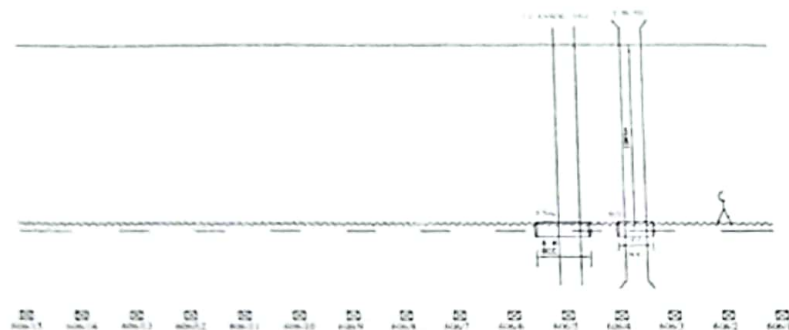

PARASA
HALT

LUCKNOW

GORAKHPUR

LEGENDS:

1. OFC Route :
2. 4 Quad Route :
3. Telecom Post :
4. G.I./RCC Pipe :
5. Horizontal Dist. of OFC Route from Railway track :
6. Emergency Post :
7. OFC Joint :



Sign - SE/Con/S & T/NER

Sign - ASTE/Con/S & T/NER

Sign - Dy. CSTE (W) Con/S & T/NER





M/s Karan Singh & Sons
Allahabad

(Sign of Contractor)

OFC Route Plan for Gonda - Basti Section of
NER

Sheet No. - 24 of 40

8. ST. THRU RD. POINT.

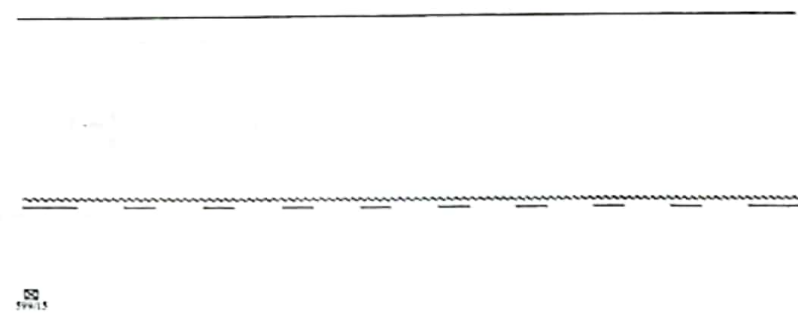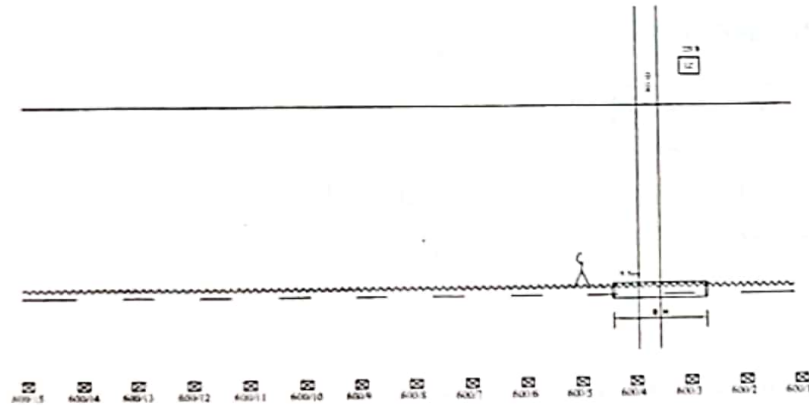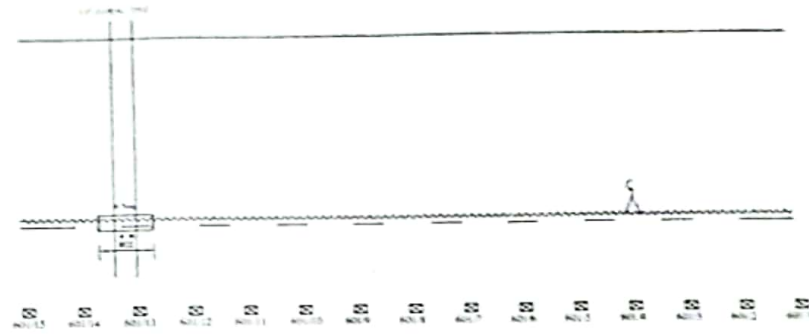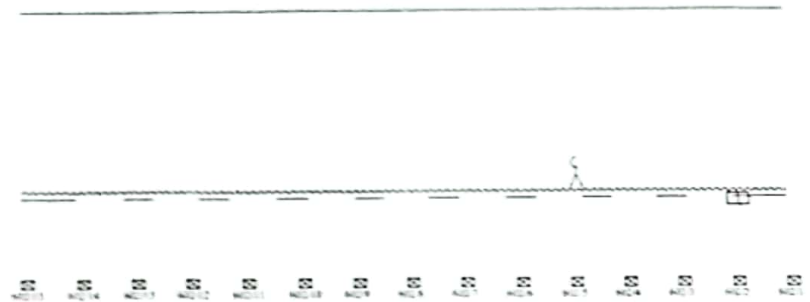


← LUCKNOW

→ GORAKHPUR

LEGENDS:

1. OFC Route :
2. 4 Quad Route :
3. Telecom Post :
4. G.I./RCC Pipe :
5. Horizontal Dist. of OFC Route from Railway track :
6. Emergency Post :
7. OFC Joint

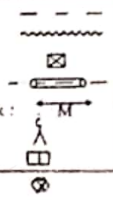

Sign - SE/Con/S & T/NER

Sign - ASTE/Con/S & T/NER

Sign - Dy. CSTE (W) Con/S & T/NER


M/s Karan Singh & Sons
Allahabad

(Sign of Contractor)

OFC Route Plan for Gonda - Basti Section of NER


Sheet No. - 25 of 40

B. ST. THRU CO. JOINT.

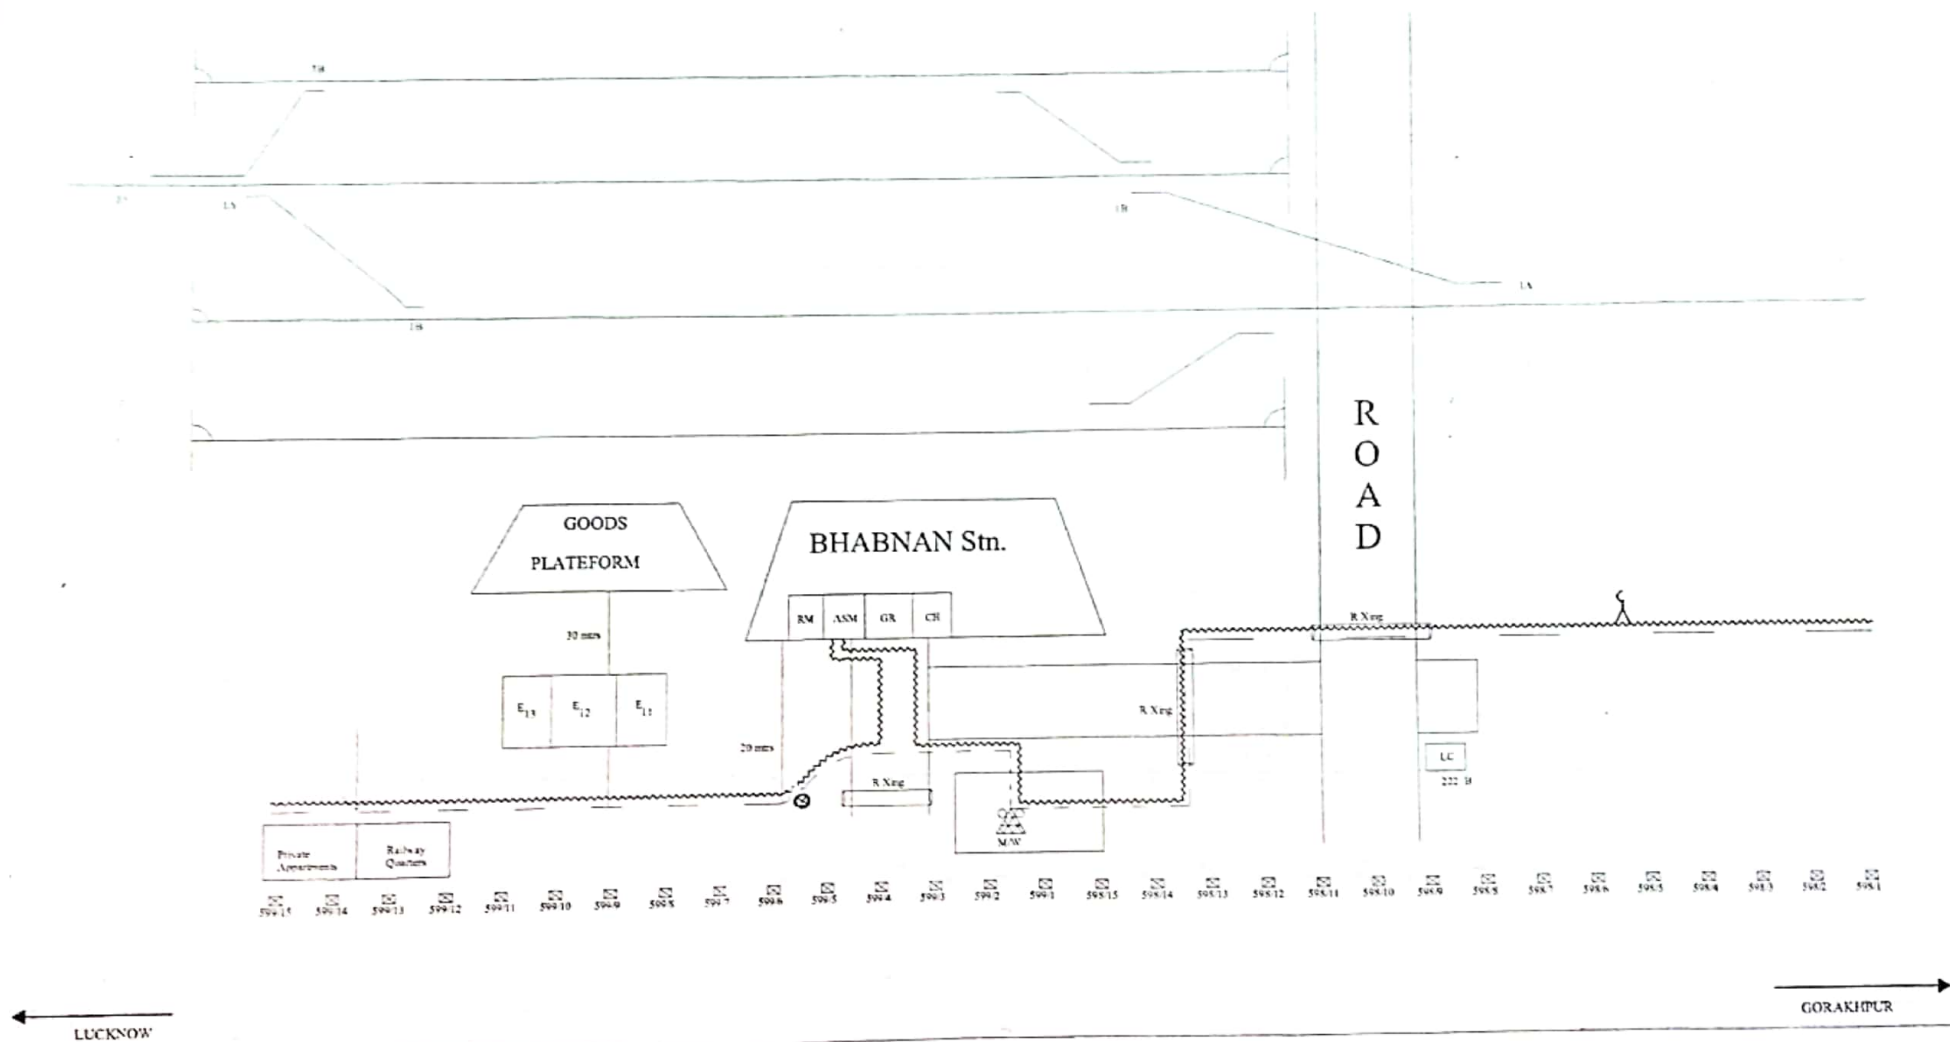

LEGENDS:

1. OFC Route :
2. 4 Quad Route :
3. Telecom Post :
4. G.I./RCC Pipe :
5. Horizontal Dist. of OFC Route from Railway track :
6. Emergency Post :
7. OFC Joint :

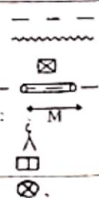

Sign - SE/Con/S & T/NER

Sign - ASTE/Con/S & T/NER

Sign - Dy. CSTE (W)/Con/S & T/NER





M/s Karan Singh & Sons
Allahabad

(Sign of Contractor)

OFC Route Plan for Gondia - Basti Section of
NER

Sheet No. - 26 of 40

B. ST. THRU QD. JOINT.

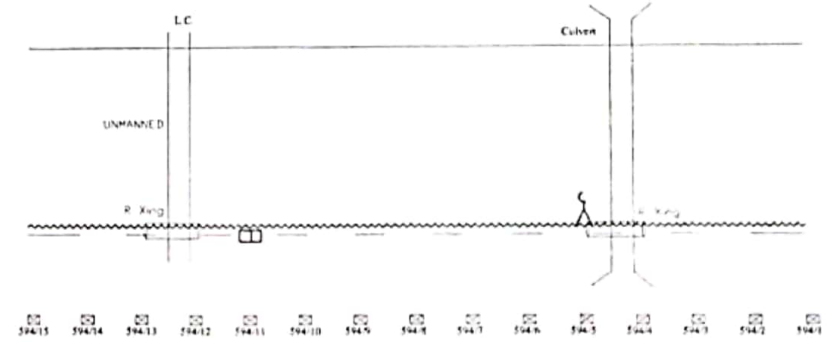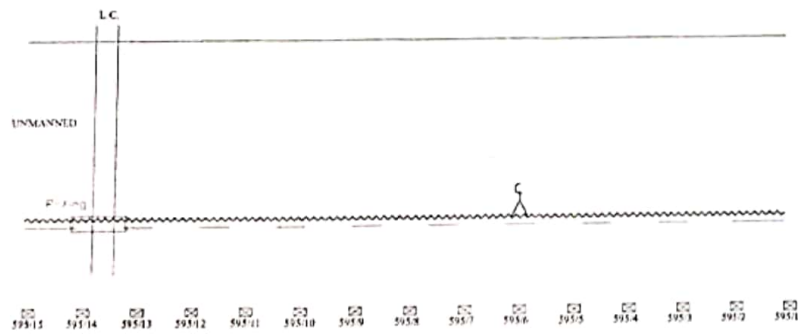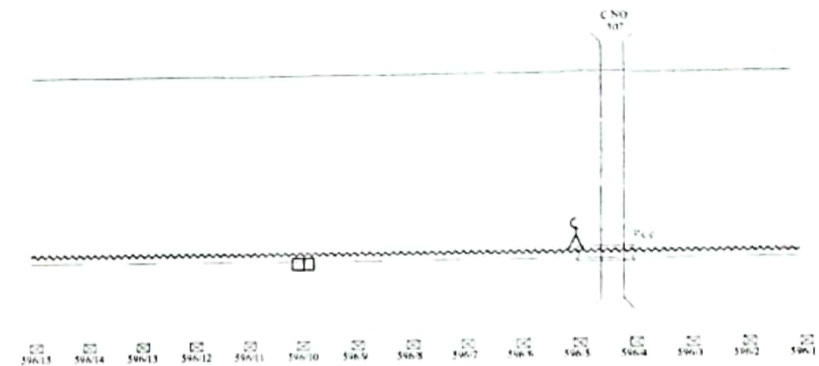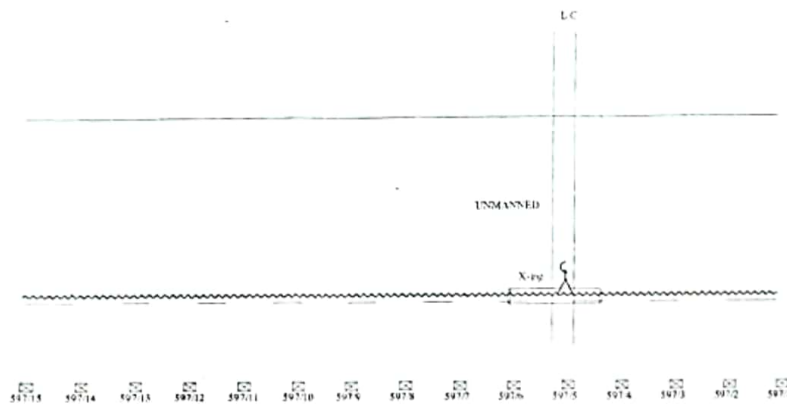


LUCKNOW

GORAKHPUR

LEGENDS:

1. OFC Route :
2. 4 Quad Route :
3. Telecom Post :
4. G.I./RCC Pipe :
5. Horizontal Dist. of OFC Route from Railway track :
6. Emergency Post :
7. O/C Joint :

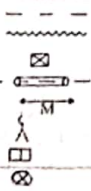

Sign - SE/Con/S & T/NER



Sign - ASTE/Con/S & T/NER

Sign - Dy. CSTE (W)/Con/S & T/NER

M/s Karan Singh & Sons
Allahabad
(Sign of Contractor)

OFC Route Plan for Gonda - Basti Section of
NER
Sheet No. - 27 of 40

8. ST. THRU CO. JOINT.

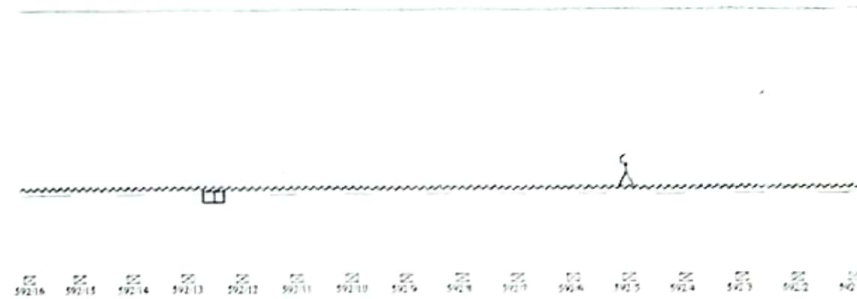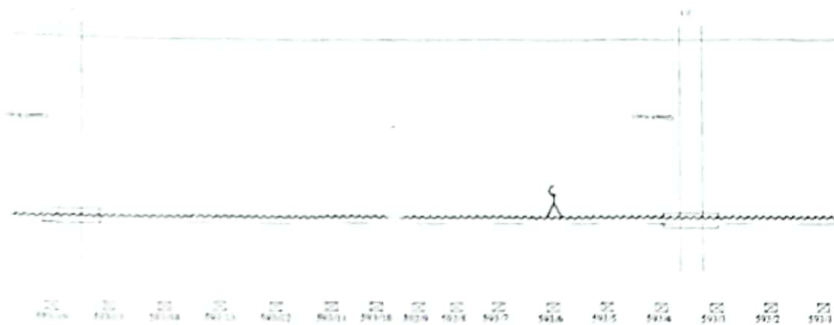


LUCKNOW

GORAKHPUR

LEGENDS:

- 1. OFC Route :
- 2. 4 Quad Route :
- 3. Telecom Post :
- 4. G.I./RCC Pipe :
- 5. Horizontal Dist. of OFC Route from Railway track :
- 6. Emergency Post :
- 7. OFC Joint :

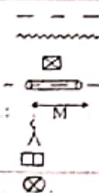

Sign - SE/Con/S & T/NER

Sign - ASTE/Con/S & T/NER

Sign - Dy. CSTE (W)/Con/S & T/NER


M/s Karan Singh & Sons
Allahabad

(Sign of Contractor)

OFC Route Plan for Gonda - Basti Section of
NER


Sheet No. - 28 of 40

ST THRU GD JOINT

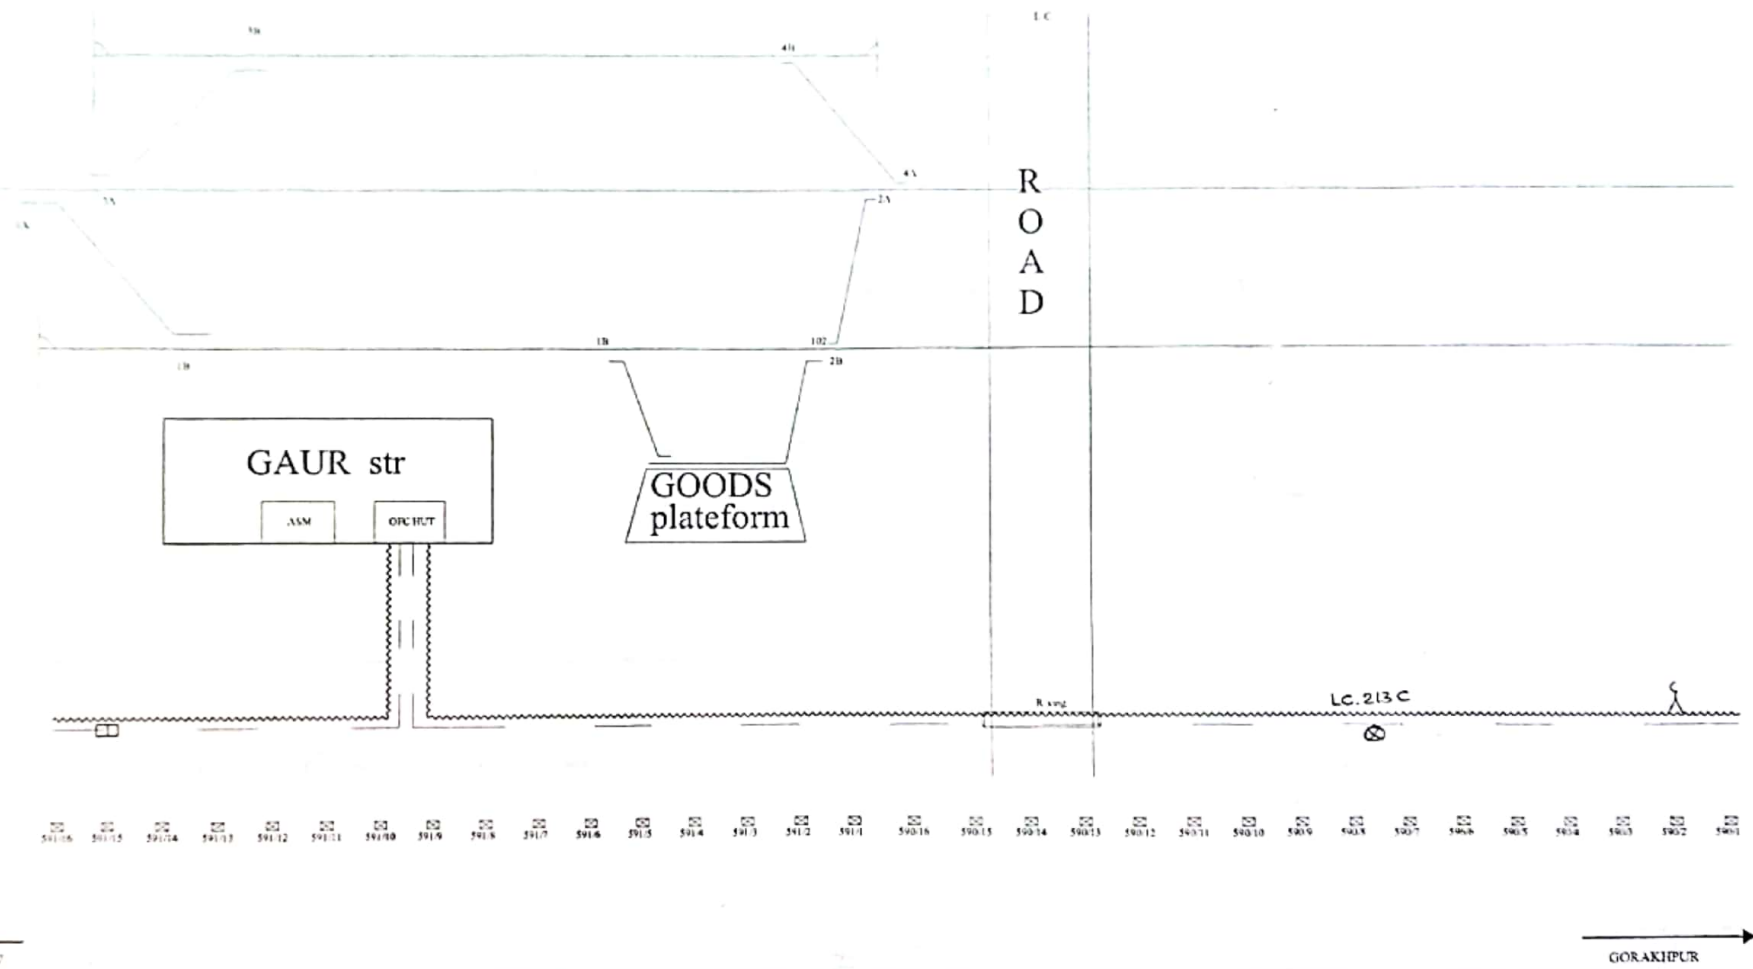

LEGENDS:

1. OFC Route :
2. 4 Quad Route :
3. Telecom Post :
4. G.I./RCC Pipe :
5. Horizontal Dist. of OFC Route from Railway track :
6. Emergency Post :
7. OFC Joint :

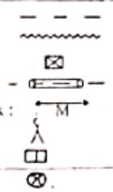

Sign - ~~SE/Con/S & T/NER~~

Sign - ~~ASTE/Con/S & T/NER~~

Sign - Dy. CSTE (W)/Con/S & T/NER



M/s Karan Singh & Sons
Allahabad

(Sign of Contractor)


OFC Route Plan for Gonda - Basti Section of
NER

Sheet No. - 29 of 40

8. ST THRU RD. JOINT.

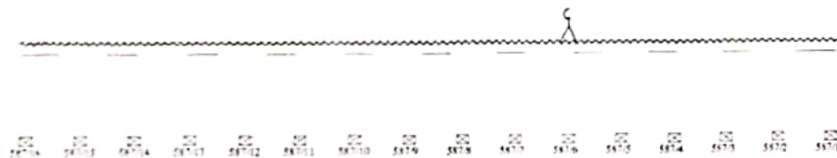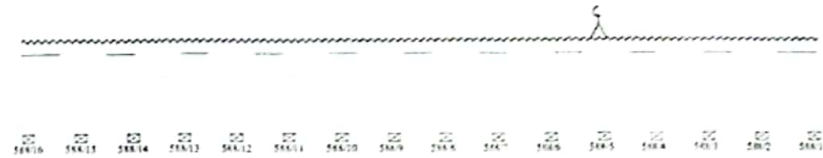

GORAKHPUR

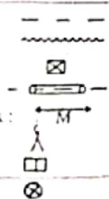

Sheet No. - 30 of 40





← LUCKNOW

→ GORAKHPUR

LEGENDS:

1. OFC Route :
2. 4 Quad Route :
3. Telecom Post :
4. G.I./RCC Pipe :
5. Horizontal Dist. of OFC Route from Railway track :
6. Emergency Post :
7. OFC Joint :

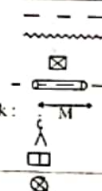

Sign - SE/Con/S & T/NER

Sign - ASTE/Con/S & T/NER

Sign - Dy. CSTE (W)/Con/S & T/NER


M/s Karan Singh & Sons
Allahabad

(Sign of Contractor)


OFC Route Plan for Gonda - Basti Section of
NER

Sheet No. - 31 of 40

8. ST. THRU QD. JOINT.


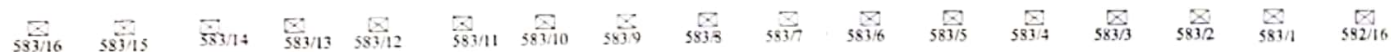


GORAKHPUR


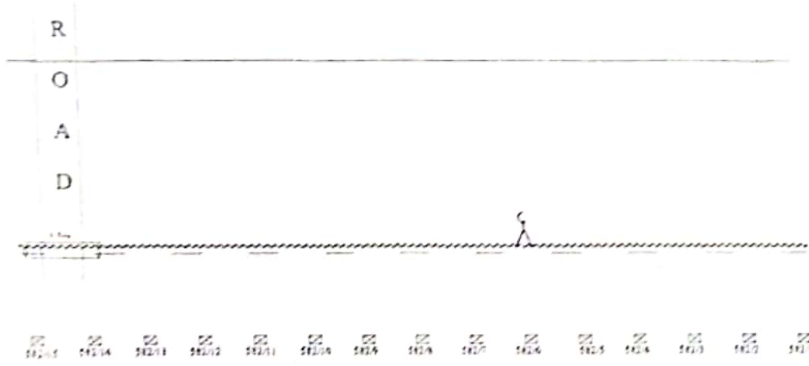


LUCKNOW GORAKHPUR

LEGENDS: 1. OFC Route 2. 4 Quad Route 3. Telecom Post 4. G.I. R.F. Pipe 5. Horizontal Dist. of OFC Route from Railway track 6. Emergency Post 7. OFC Joint 8. ST TAP & JOINT		Sign - S B/Con/S & T/NER	Sign - A/TE/Con/S & T/NER	Sign - Dy. CSTB (W) Con/S & T/NER	M/a Karan Singh & Sons Allahabad (Sign of Contractor)	OFC Route Plan for Gonda - Bahi Section of NER Sheet No. - 33 of 40
--	--	-------------------------------------	--------------------------------------	--	---	---

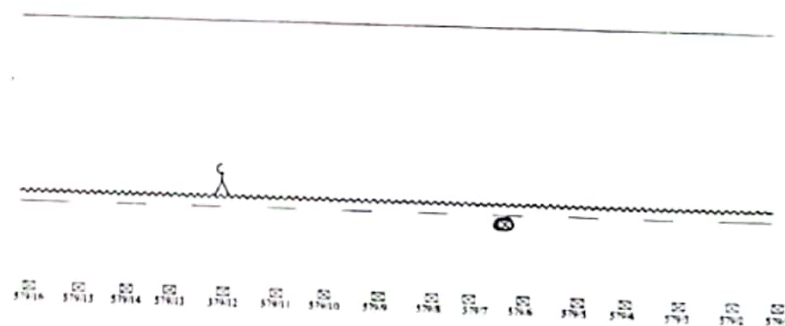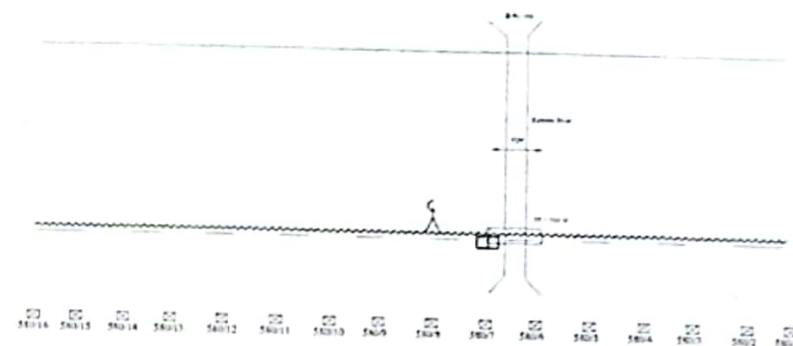

GORAKHPUR

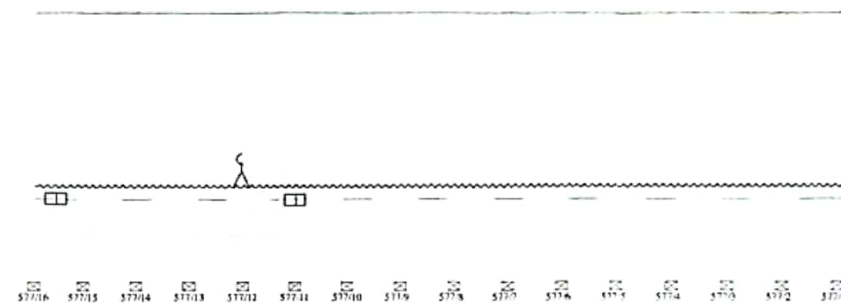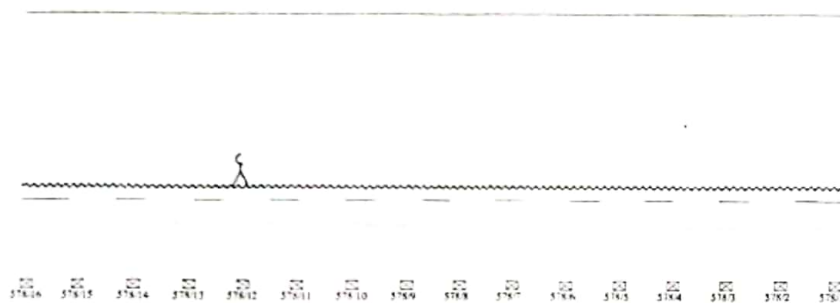


← LUCKNOW

→ GORAKHPUR

LEGENDS: -

1. OFC Route :
2. 4 Quad Route :
3. Telecom Post :
4. G.I./RCC Pipe :
5. Horizontal Dist. of OFC Route from Railway track :
6. Emergency Post :
7. OFC Joint :

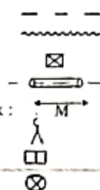

Sign - SE/Con/S & T/NER

Sign - ASTE/Con/S & T/NER

Sign - Dy. CSTE (W)/Con/S & T/NER



M/s Karan Singh & Sons
Allahabad

(Sign of Contractor)

OFC Route Plan for Gonda - Basti Section of
NER

Sheet No. - 35 of 40

8. ST THRU QD. JOINT.

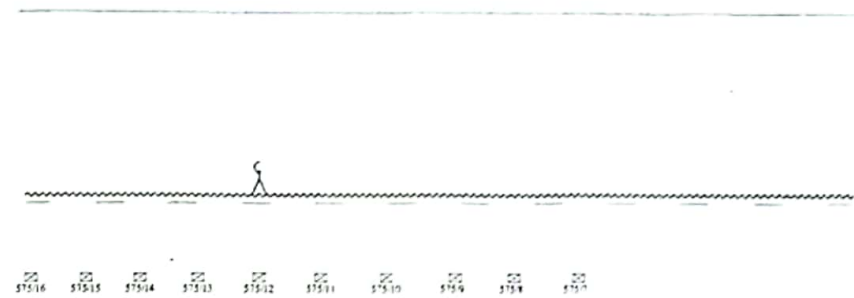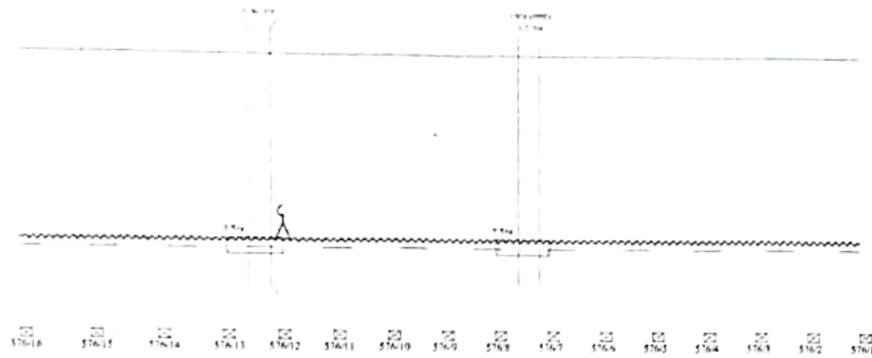


← LUCKNOW

→ GORAKHPUR

LEGENDS:

1. OFC Route :
2. 4 Quad Route :
3. Telecom Post :
4. G.I./RCC Pipe :
5. Horizontal Dist. of OFC Route from Railway track :
6. Emergency Post :
7. OFC Joint :

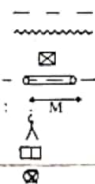

Sign - /Con/S & T/NER

Sign - ASTE/Con/S & T/NER

Sign - Dy. CSTE (W)/Con/S & T/NER


M/s Karan Singh & Sons
Allahabad

(Sign of Contractor)

OFC Route Plan for Gonda - Basti Section of
NER


Sheet No. - 36 of 40

8. ST. THRU QD. JOINT.

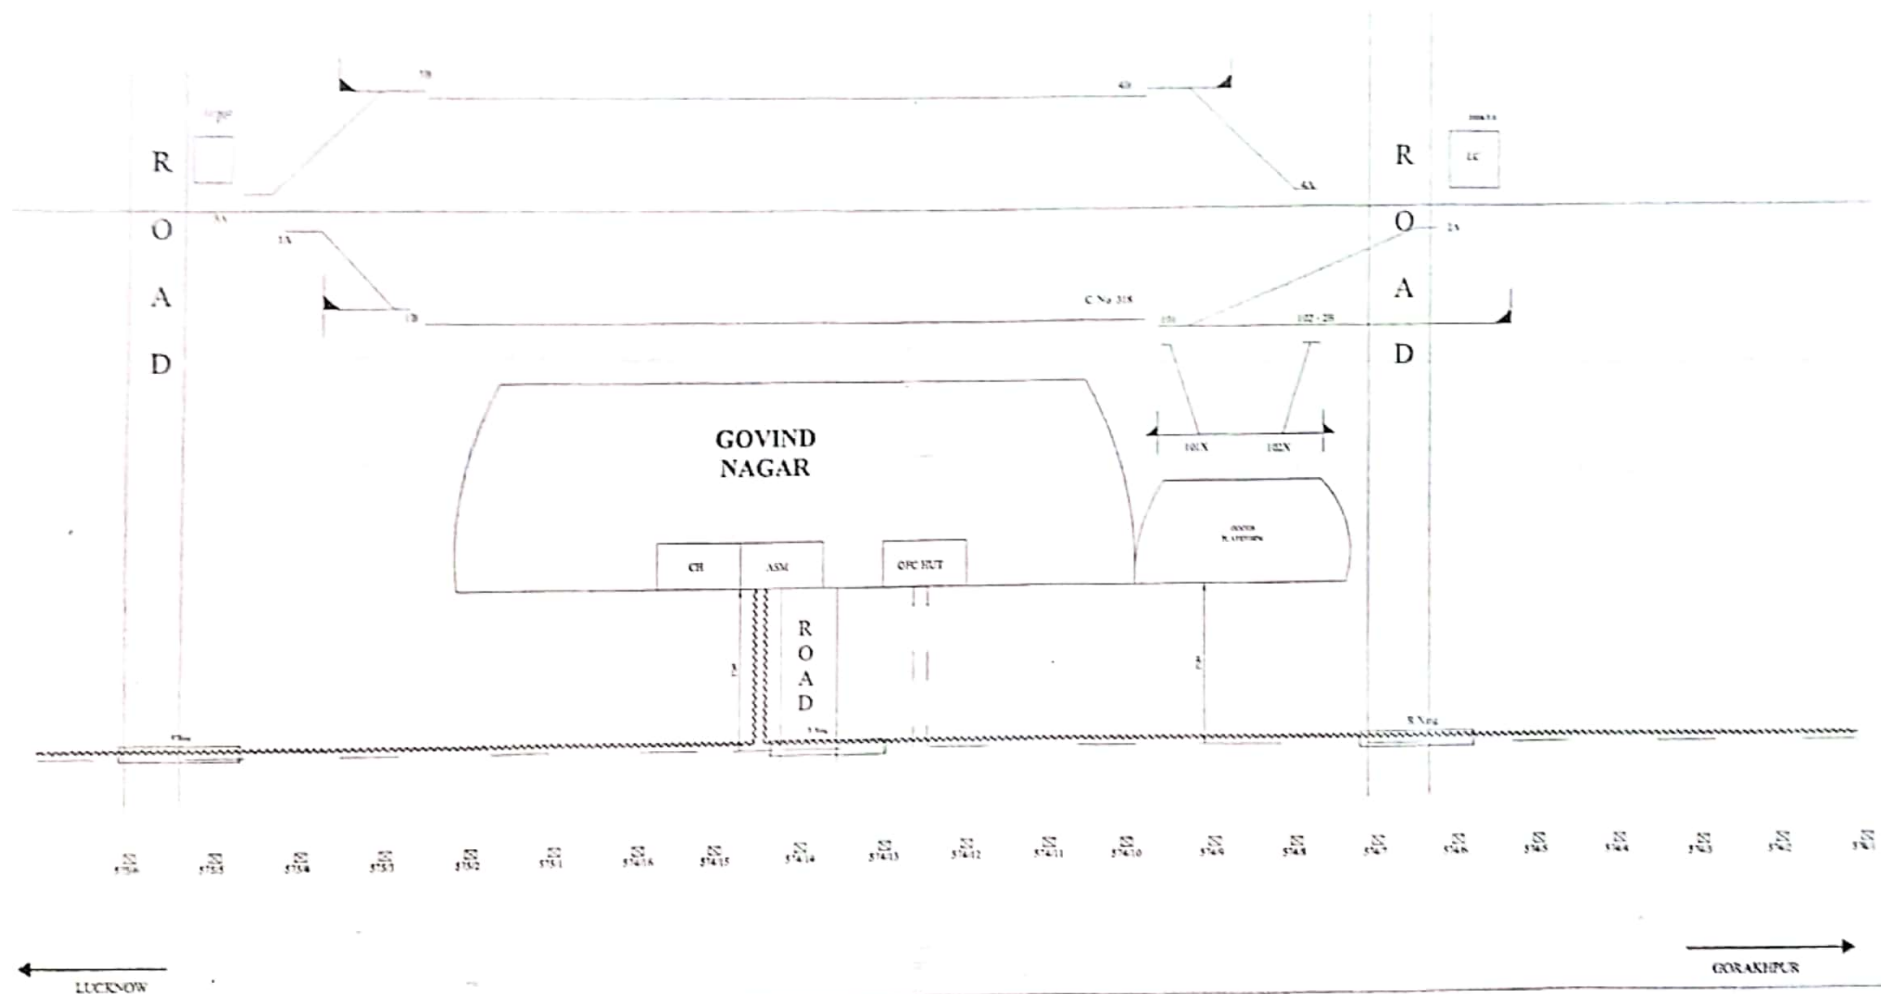

LEGENDS:

1. OFC Route
2. 4 Quad Route
3. Telecom Post
4. G.I./RCC Pipe
5. Horizontal Dist. of OFC Route from Railway track
6. Emergency Post
7. OFC Joint

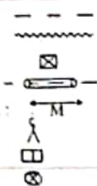

Sign - SE/Con/S & T/NER

Sign - ASTE/Con/S & T/NER

Sign - Dy. CSTE (W) Con/S & T/NER


M/s Karan Singh & Sons
Allahabad

(Sign of Contractor)


OFC Route Plan for Gonda - Basti Section of
NER

Sheet No. - 37 of 40

8. ST. THRU RD. JOINT.

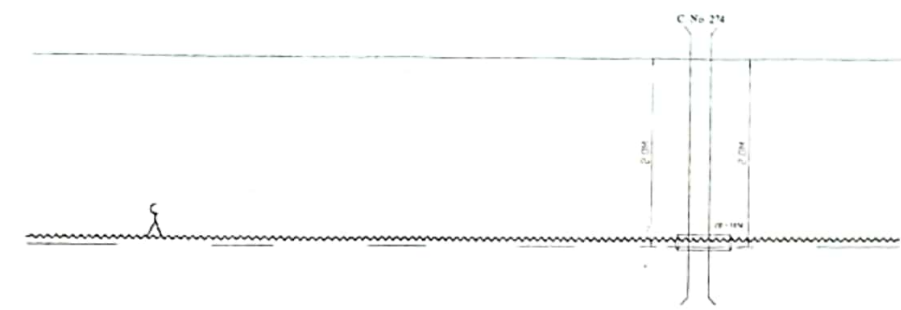

573/16 573/15 573/14 573/13 573/12 573/11 573/10 573/9 573/8 573/7 573/6 573/5 573/4 573/3 573/2 573/1

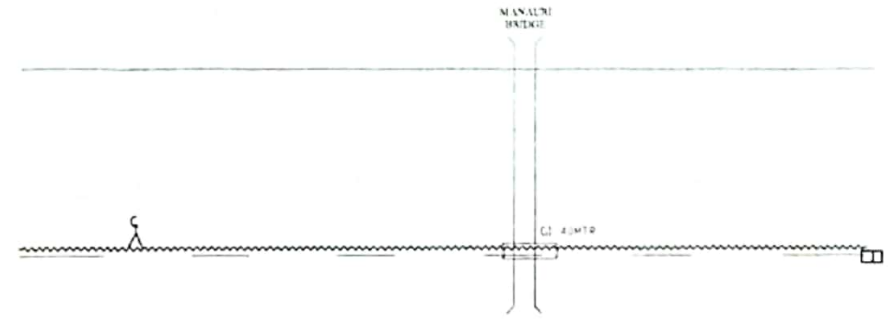


572/16 572/15 572/14 572/13 572/12 572/11 572/10 572/9 572/8 572/7 572/6 572/5 572/4 572/3 572/2 572/1

← LUCKNOW

GORAKHPUR →

LEGENDS:

1. OFC Route :
2. 4 Quad Route :
3. Telecom Post :
4. G.I./RCC Pipe :
5. Horizontal Dist. of OFC Route from Railway track :
6. Emergency Post :
7. OFC Joint :

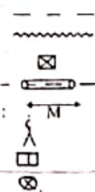

Sign - SE/Con/S & T/NER

Sign - ASTE/Con/S & T/NER

Sign - Dy. CSTE (W) Con/S & T/NER



M/s Karan Singh & Sons
Allahabad

(Sign of Contractor)

OFC Route Plan for Gonda - Basti Section of
NER

Sheet No. - 38 of 40

8. ST THRU QD. JOINT.

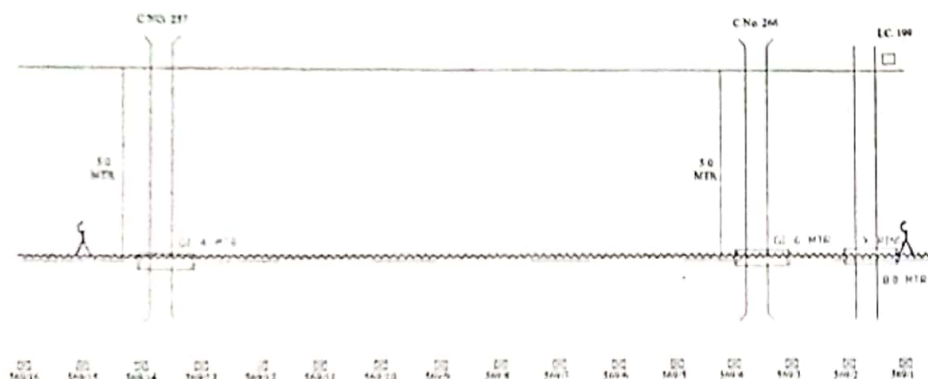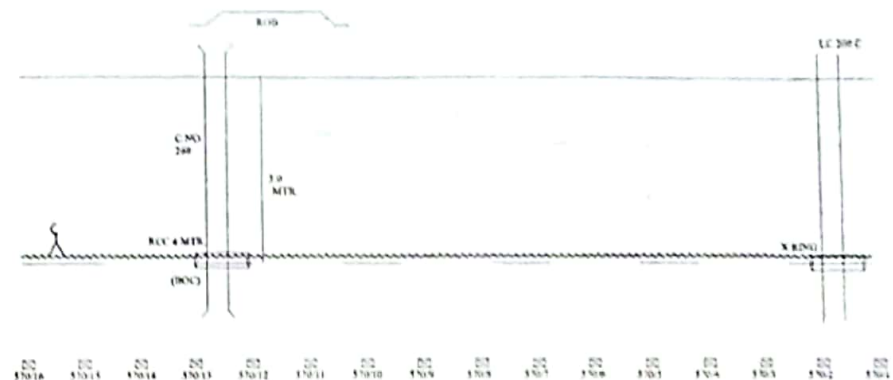


LUCKNOW

GORAKHPUR

LEGENDS:

1. OFC Route ;
2. 4 Quad Route ;
3. Telecom Post
4. GI/RCC Pipe ;
5. Horizontal Dist. of OFC Route from Railway track ;
6. Emergency Post ;
7. OFC Joint

2 ST. THRU QD. JOINT

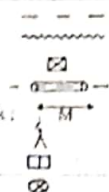

Sign -sr /Con/S & T/NER

Sign - ASTE/Con/S & T/NER


Sign = Dy, CSTE (W)/Con/S & T/NER

M/s Karan Singh & Sons
Allahabad

(Sign of Contractor)


OFC Route Plan for Gonda - Hasti Section of
NER

Sheet No. - 39 of 40

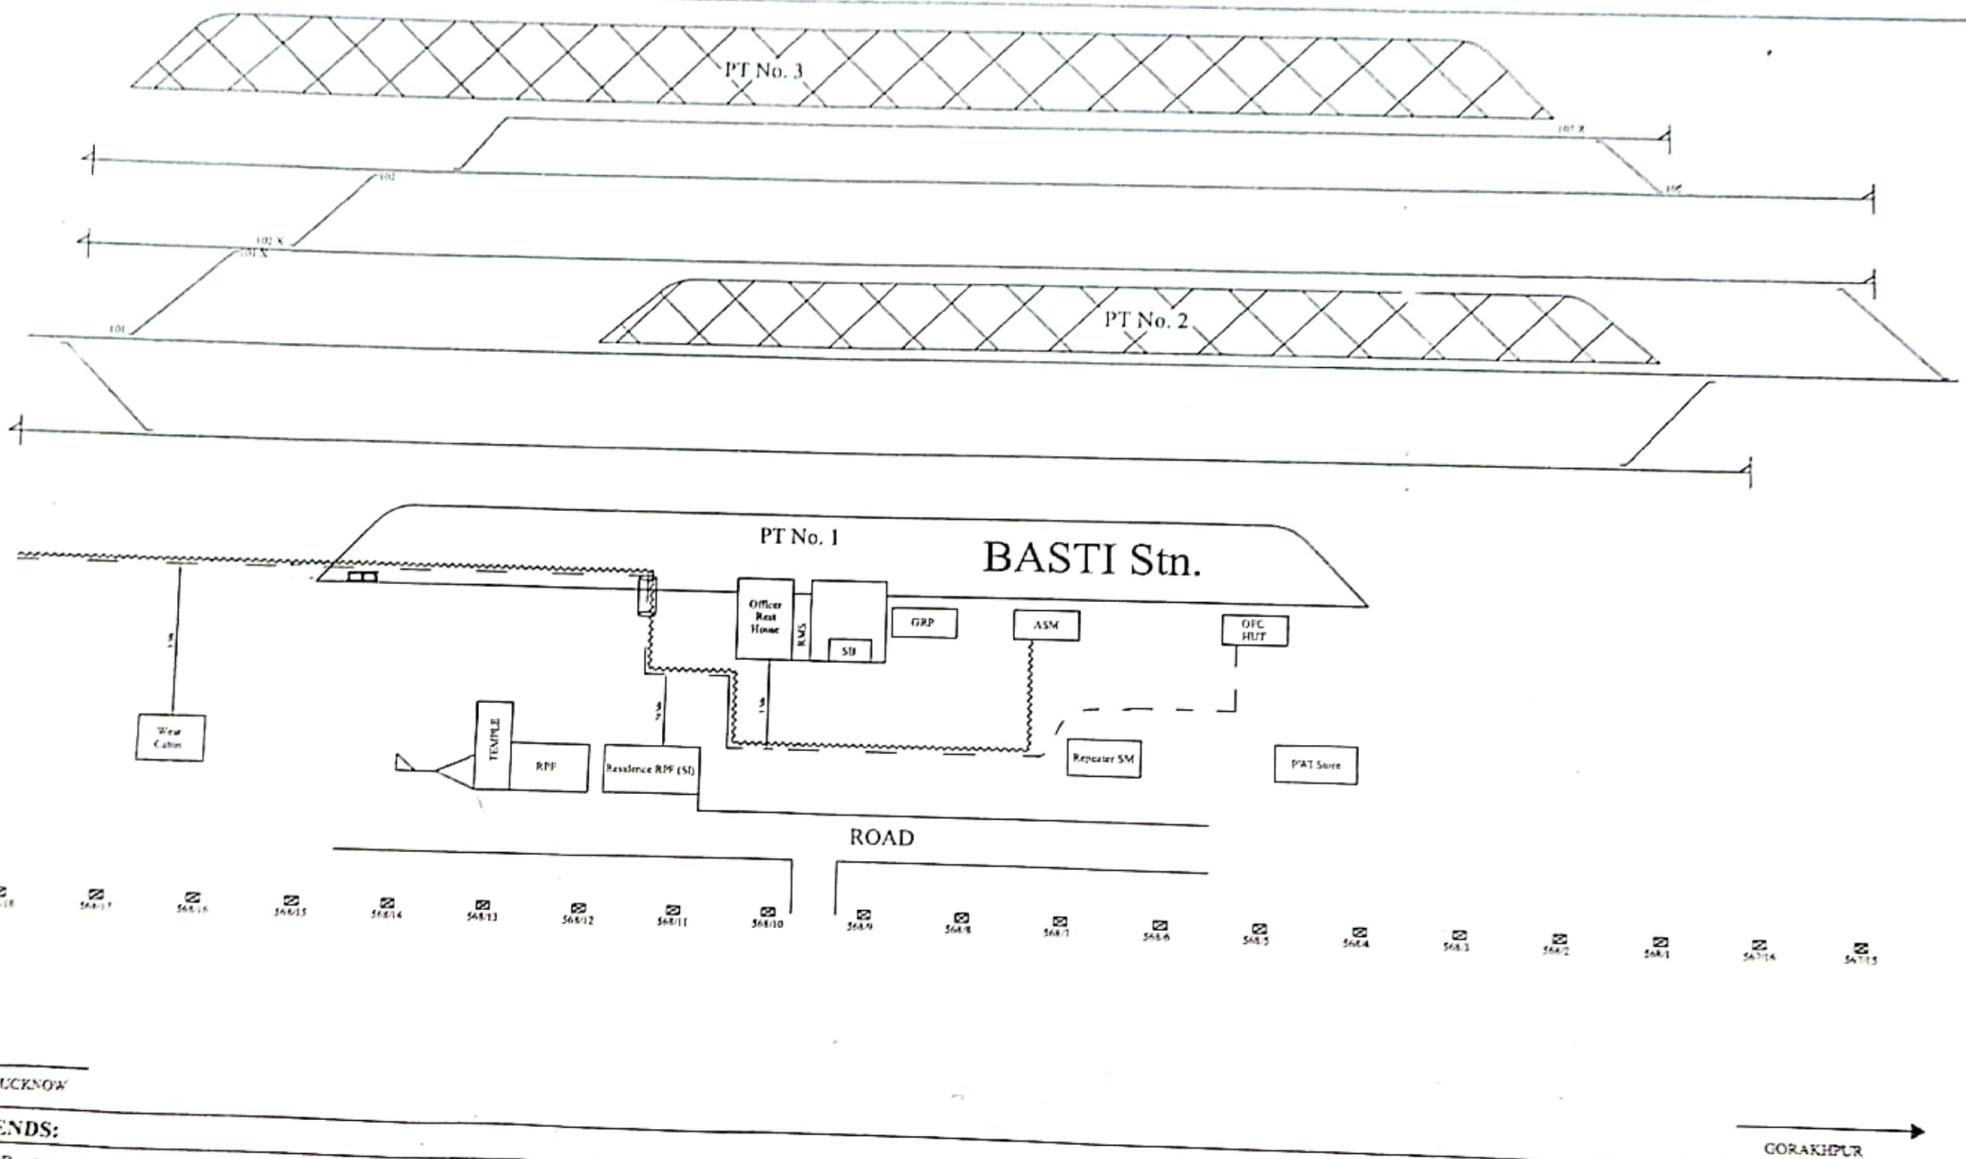

LEGENDS:

1. OFC Route :
2. 4 Quad Route :
3. Telecom Post :
4. GL/RCC Pipe :
5. Horizontal Dist. of OFC Route from Railway track :
6. Emergency Post :
7. OFC Joint :

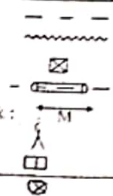

Sign - SE/ Con/S & T/NER

Sign - ASTE/Con/S & T/NER

Sign - Dy. CSTE (W)/Con/S & T/NER

M/s Karan Singh & Sons
Allahabad

(Sign of Contractor)

OFC Route Plan for Gonda - Basti Section of
NER

Sheet No. - 40 of 40

B- ST THRU GD. JOINT.