


GORAKHPUR - KHALILABAD


GKP-KLD

① / 15

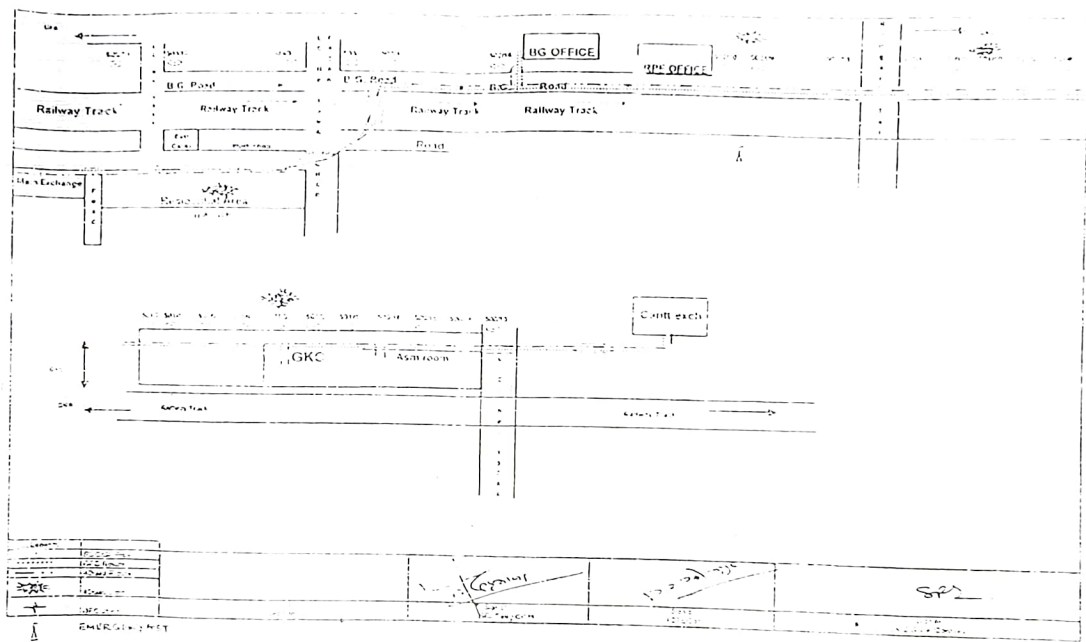

②



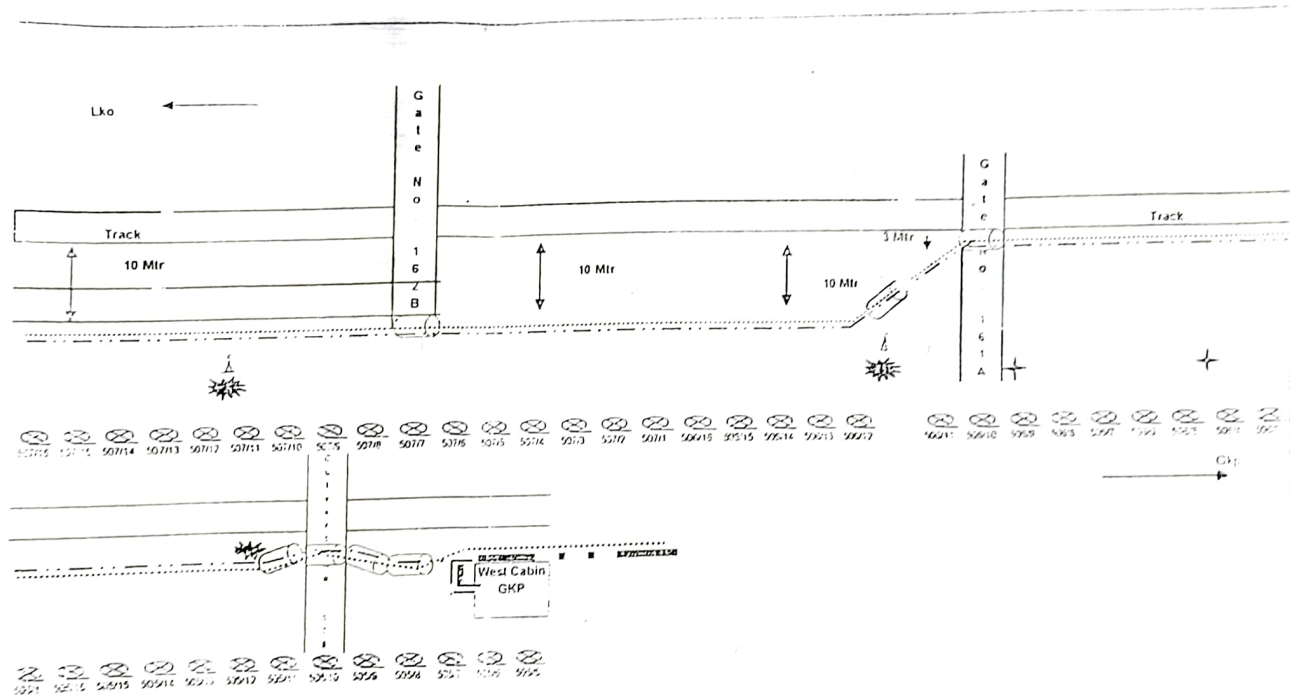

Legend				
	Quad Road			
	PCC/GI Pipe			
	OFC Road			
	Quad Road			
	Quad Joint			
	OFC Joint			
EMERGENCY POST				



RAILTEL
RAILTEL CORPORATION OF INDIA LIMITED
ASBUILT OF OFC LAYING
STATION
DOMINGARH TO MUNDERWA

PREPARED BY:

CHECKED BY:

APPROVED BY:

ACCEPTED BY:


GORAKHPUR

DOMINGARH

JAGATBELA

CEMENT
FENCING

PLATFORM NO-2

MS-509

KM NO
509/39KM NO
509/39KM NO
509/1KM NO
509/2KM NO
509/3KM NO
509/4

PLATFORM NO-1

SWITCH
ROOMWAITING
ROOMSS
ROOMASM
ROOMRELAY
ROOMSIGNAL
ROOMFMS
OFC
CABLE
HUTPT
00

18.3

CEMENT
FENCING

22.4

23.0

19.2

16.8

21.5

ENTRANCE

THLOC
NO 17

Legends

1	COUPLER 40mm		9.	6 QUAD NORMAL JOINT	
2	SPLICE CHAMBER		10.	OFC	
3	KILOMETER STONE		11.	DUCT	
4	CULVERT		12.	OPEN TRENCH	
5	G I PIPE		13.	BORE	
6	RCC PIPE		14.	HDD	
7	GURDER BRIDGE		15.	QUAD CABLE	
8	SUB MILE STONE		16.	TELE POLE	



RAILTEL

RAILTEL CORPORATION OF INDIA LIMITED

RAILWAY STATION - DOMINGARH TO MUNDERWA

DRAWING TITLE: CABLE ROUTE PLAN

DRAWING NO.:

SHEET No.

PROJECT CODE:

SECTION:


DOMINGARH TO JAGATBELA

M/s R.S. TRADERS

DOMINGARH

JAGATBELA

2

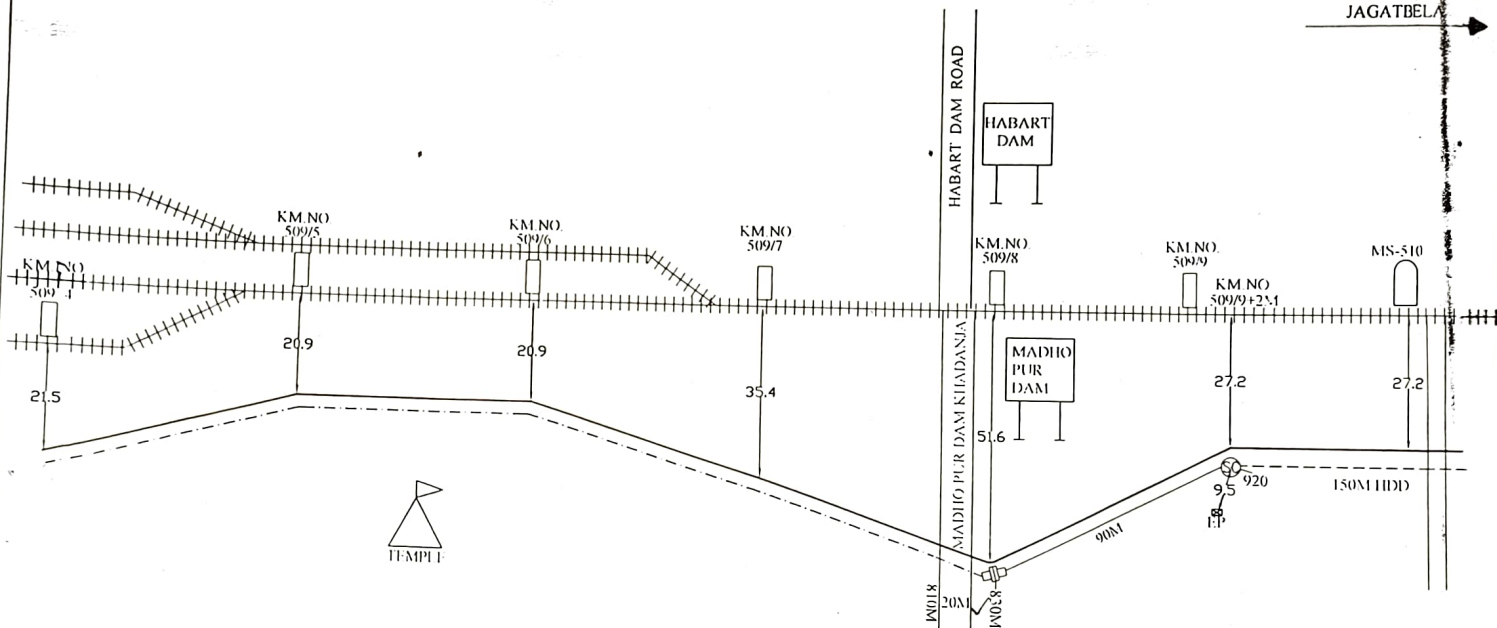

Legends

1. CUMPLER 40mm		9. QUAD NORMAL JOINT	
2. SPLICE CHAMBER		10. OFC	
3. KILOMETER STONE		11. DUCT	
4. CULVERT		12. OPEN TRENCH	
5. GI PIPE		13. BORE	
6. RCC PIPE		14. HDD	
7. GIRDER BRIDGE		15. QUAD CABLE	
8. SUB VILE STONE		16. TELE POLE	



RAILTEL

RAILTEL CORPORATION OF INDIA LIMITED

RAILWAY STATION - DOMINGARH TO MUNDERWA

DRAWING TITLE: CABLE ROUTE PLAN

DRAWING NO.:

SHEET No.

PROJECT CODE:

SECTION:


DOMINGARH TO JAGATBELA

M/S. R. S. TRADERS

DOMINGARH

JAGATBELA

3

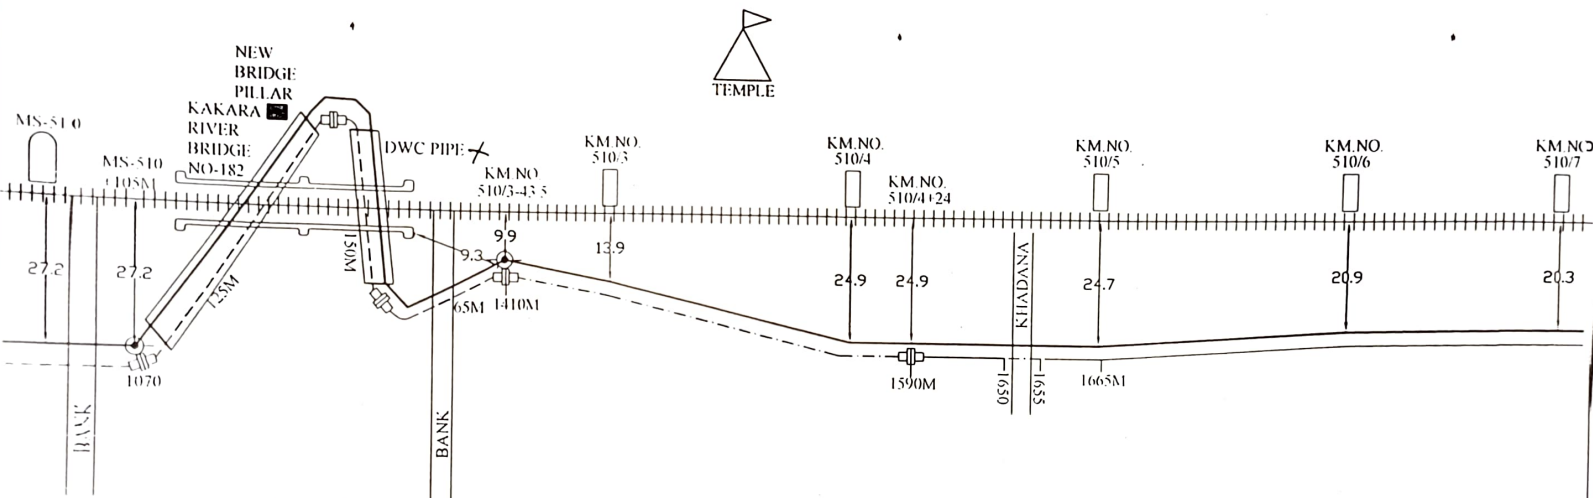

DWC 14d
 Provide
 use PLB Duct

Legends

1	COUPLER 40mm		9.	6 QUAD NORMAL JOINT	
2	SPLICE CHAMBER		10.	OFC	
3	KILOMETER STONE		11.	DUCT	
4	CULVERT		12.	OPEN TRENCH	
5	G.P. PIPE		13.	BORE	
6	RCC PIPE		14.	HDD	
7	GULLY BRIDGE		15.	QUAD CABLE	
8	SUBMILE STONE		16.	TELE POLE	



RAILTEL

RAILTEL CORPORATION OF INDIA LIMITED

RAILWAY STATION - DOMINGARH TO MUNDERWA

DRAWING TITLE: CABLE ROUTE PLAN

DRAWING NO.:

SHEET No.

PROJECT CODE:


SECTION:

DOMINGARH TO JAGATBELA

M/s. R.S. TRADERS

DOMINGARIH

JAGATBELA

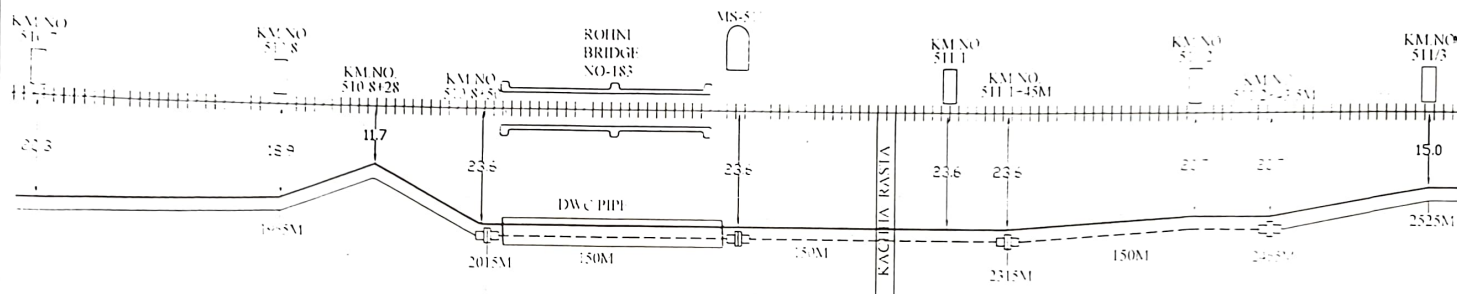

Legends

1. COUPLER 40mm		9. 60 AD NORMAL WENT	
2. SPICE CHAMBER		10. CFC	
3. KILOMETER STONE		11. DUCT	
4. CULVERT		12.	
5. PIPE		13. BURE	
6. RCC PIPE		14. HD	
7. UNDER BRIDGE		15. QUAD CABLE	
8. MILESTONE		16. TELE PILE	



M&B

RAILWAY STATION - DOMINGARIH TO MUNDERWA

DRAWING TITLE: CABLE ROUTE PLAN

DRAWING NO.:

SHEET No.

PROJECT CODE:


SECTION:

DOMINGARIH TO JAGATBELA

M&B TRADERS

DOMINGARH

JAGATBELA

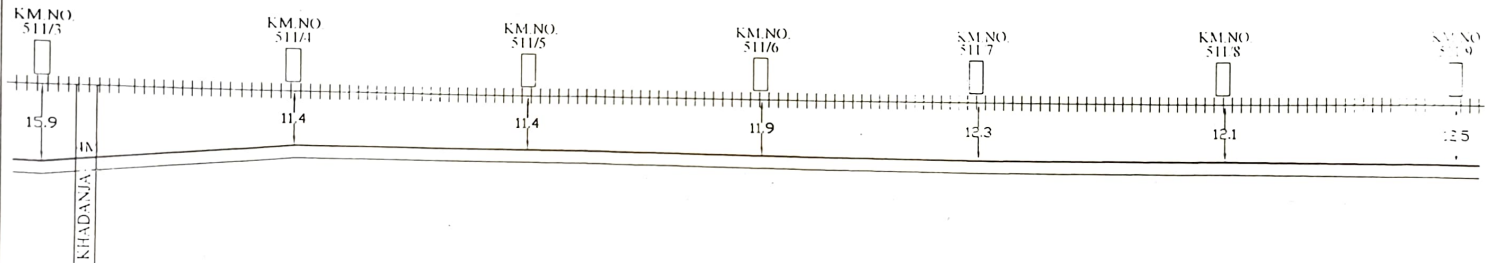

Legends

1	COUPLER 40mm		9	QUAD NORMAL JOINT	
2	SPLICE CHAMBER		10	OFC	
3	KILOMETER STONE		11	DUCT	
4	CULVERT		12	OPEN TRENCH	
5	G.I PIPE		13	BORE	
6	RCC PIPE		14	HDD	
7	GURDER BRIDGE		15	QUAD CABLE	
8	SUB MILE STONE		16	TELE POLE	



RAILTEL

RAILTEL CORPORATION OF INDIA LIMITED

RAILWAY STATION - DOMINGARH TO MUNDERWA

DRAWING TITLE: CABLE ROUTE PLAN

DRAWING NO.:

SHEET No.

PROJECT CODE:

SECTION:


DOMINGARH TO JAGATBELA

M/s R.S. TRADERS

DOMINGARH

6

JAGATBELA

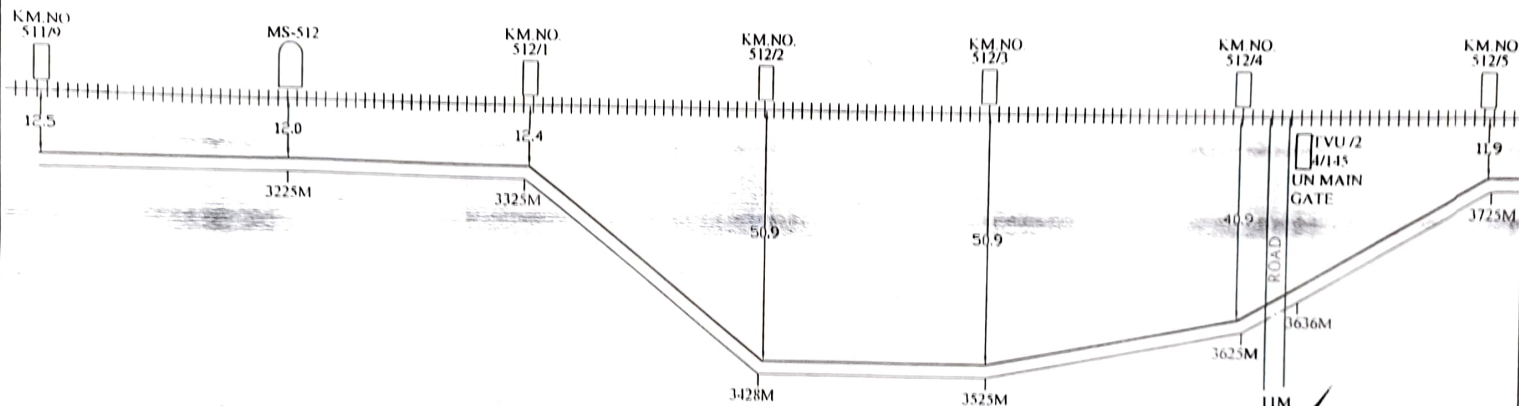

Legends

1	COUPLER 40mm		9	6 QUAD NORMAL JOINT	
2	SPLICE CHAMBER		10	OFC	
3	KILOMETER STONE		11	DUCT	
4	CULVERT		12		
5	G.I. PIPE		13	BORE	
6	RCC PIPE		14	HDD	
7	GUARDER BRIDGE		15	QUAD CABLE	
8	SUB MILE STONE		16	TELE POLE	



RAI TEL

RAILTEL CORPORATION OF INDIA LIMITED

RAILWAY STATION - DOMINGARH TO MUNDERWA

DRAWING TITLE: CABLE ROUTE PLAN

DRAWING NO.:

SHEET No.

PROJECT CODE:


SECTION:

DOMINGARH TO JAGATBELA

M/s R.S. TENDERS

DOMINGARH

JAGATBELA

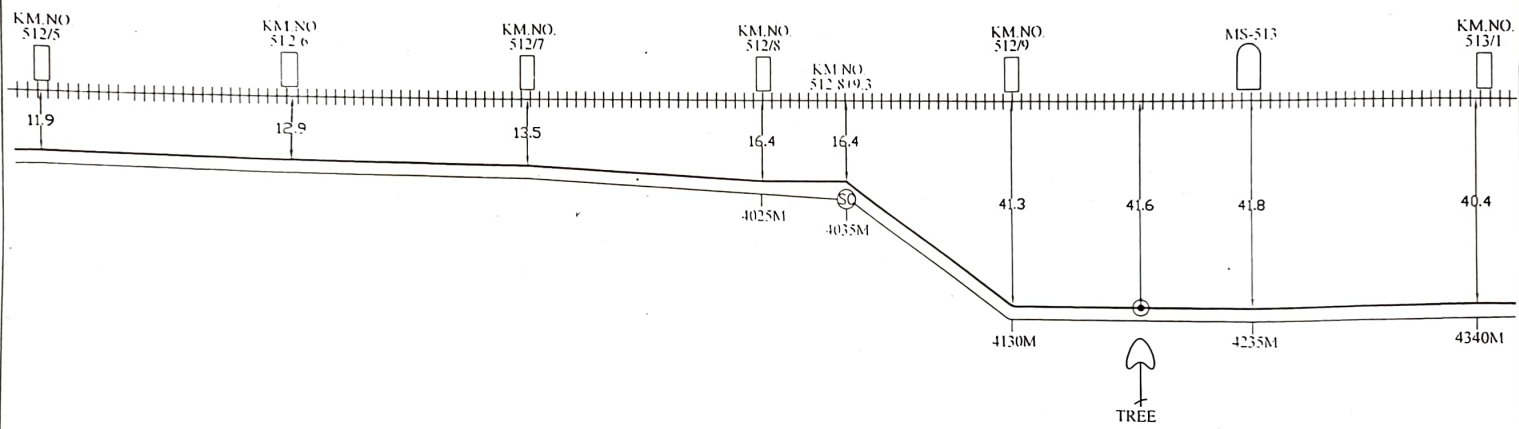

Legends

1.	COUPLER 40mm		9.	6 QUAD NORMAL JOINT	
2.	SPLICE CHAMBER		10.	OFC	
3.	KILOMETER STONE		11.	DUCT	
4.	CULVERT		12.	OPEN TRENCH	
5.	G.I PIPE		13.	BORE	
6.	RCC PIPE		14.	HDD	
7.	GURDER BRIDGE		15.	QUAD CABLE	
8.	SUB MILE STONE		16.	TELE POLE	



RAILTEL

RAILTEL CORPORATION OF INDIA LIMITED

RAILWAY STATION -DOMINGARH TO MUNDERWA

DRAWING TITLE: CABLE ROUTE PLAN

DRAWING NO.:

SHEET No.

PROJECT CODE:

SECTION:


DOMINGARH TO JAGATBELA

M/s R.S. TRADERS

DOMINGARH

JAGATBELA

8

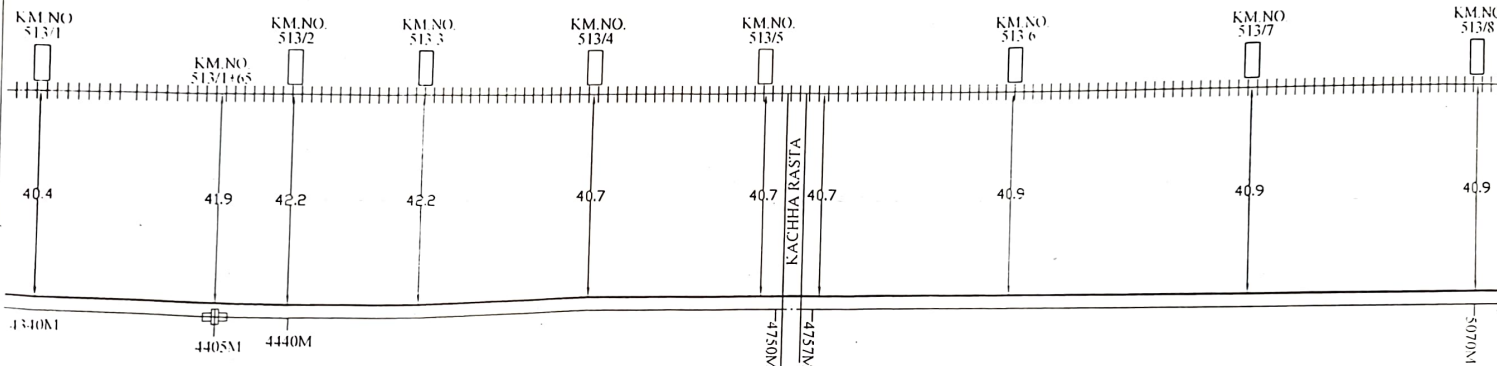

Legends

1	COUPLER 40mm		9	6 QUAD NORMAL JOINT	
2	SPLICE CHAMBER		10	OFC	
3	KILOMETER STONE		11	DUCT	
4	CULVERT		12	OPEN TRENCH	
5	G.I PIPE		13	BORE	
6	RCC PIPE		14	HDD	
7	GURDER BRIDGE		15	QUAD CABLE	
8	SUB MILE STONE		16	TELE POLE	



RAI LTCL

RAILTEL CORPORATION OF INDIA LIMITED

RAILWAY STATION - DOMINGARH TO MUNDERWA

DRAWING TITLE: CABLE ROUTE PLAN

DRAWING NO.:

SHEET No.

PROJECT CODE:


SECTION:

DOMINGARH TO JAGATBELA

M/s R.S. TRADERS

DOMINGARH

JAGATBELA

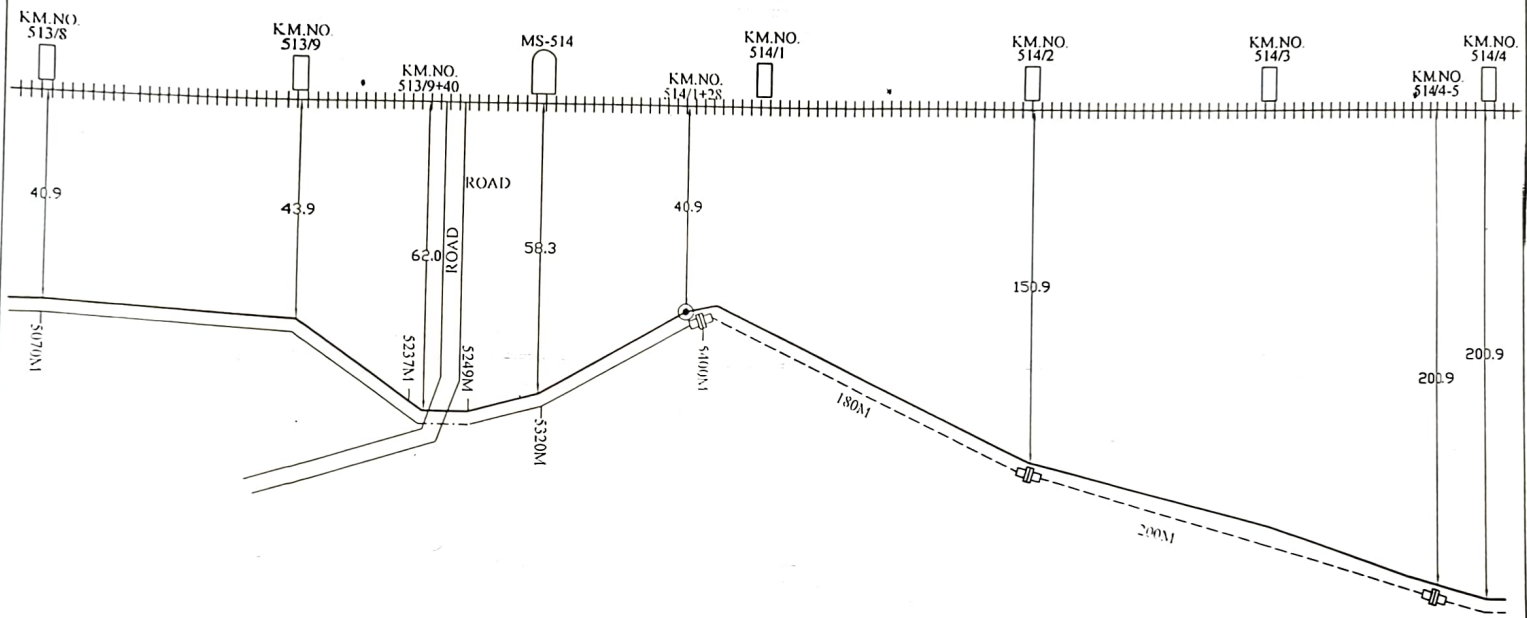

Legends

1	COUPLER 40 mm		9.	6 QUAD NORMAL JOINT	
2	SPLICE CHAMBER		10	OFC	
3	KILOMETER STONE		11	DUCT	
4	CULVERT		12	OPEN TRENCH	
5	G.I PIPE		13	BORE	
6	RCC PIPE		14	HDD	
7	GURDER BRIDGE		15	QUAD CABLE	
8	SUB MILE STONE		16	TELE POLE	



RAILTEL

RAILTEL CORPORATION OF INDIA LIMITED

RAILWAY STATION - DOMINGARH TO MUNDERWA

DRAWING TITLE: CABLE ROUTE PLAN


DRAWING NO.:

SHEET No.

PROJECT CODE:

SECTION: DOMINGARH TO JAGATBELA

M/s R.S. TRADERS

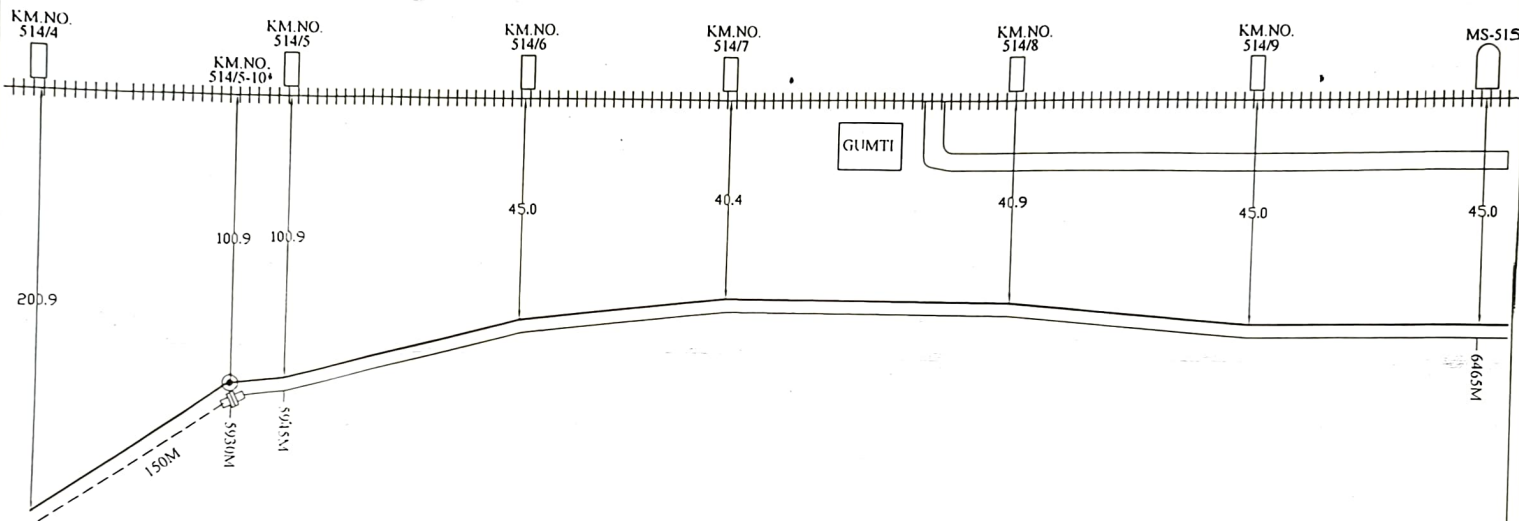

Legends

1	COUPLER 40mm		9	6 QUAD NORMAL JOINT	
2	SPLICE CHAMBER		10	OFC	—
3	KILOMETER STONE		11	DUCT	—
4	CULVERT		12	OPEN TRENCH	—
5	G.I PIPE		13	BORE	- - - -
6	RCC PIPE		14	HDD	- - - -
7	GURDER BRIDGE		15	QUAD CABLE	—
8	SUB MILE STONE		16	TELE POLE	⊙



RAILTEI

RAILTEL CORPORATION OF INDIA LIMITED

RAILWAY STATION - DOMINGARH TO MUNDERWA

DRAWING TITLE:	CABLE ROUTE PLAN
----------------	------------------

DRAWING NO.:

SHEET No.

PROJECT CODE:


SECTION:

DOMINGARH TO JAGATBELA

M/s R.S. PRADERS

DOMINGARH

JAGATBELA

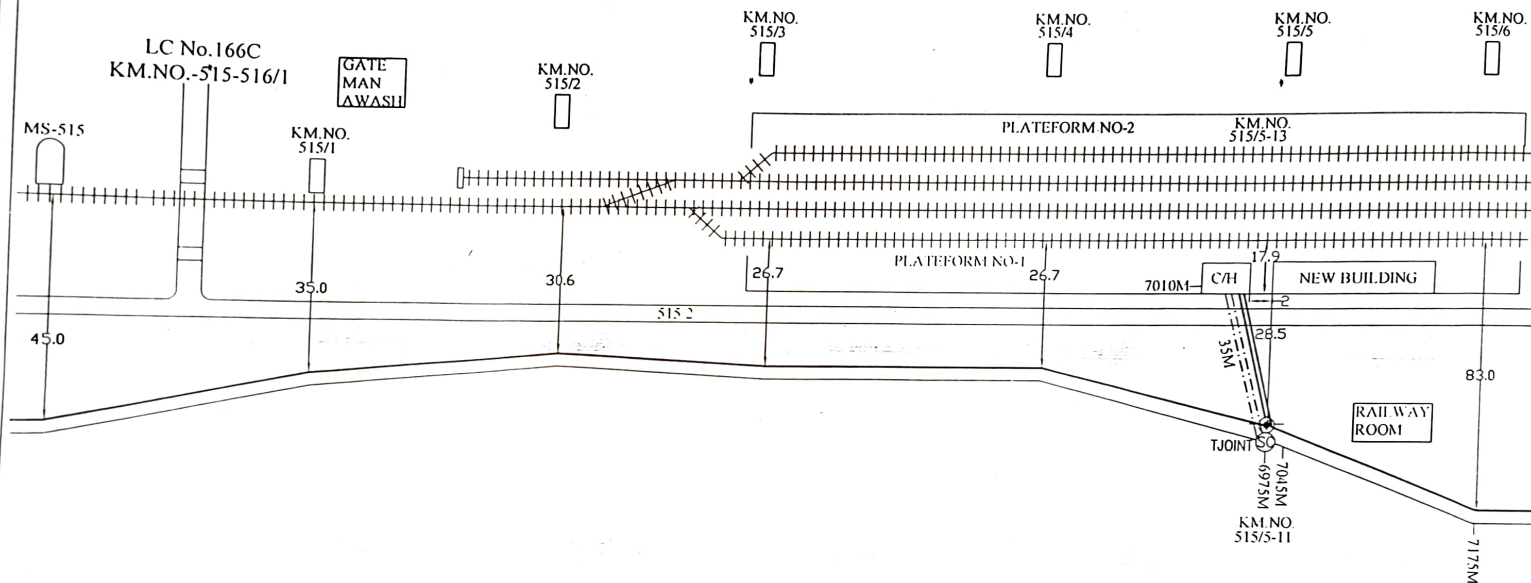

Legends

1	COUPLER 40mm		9	6 QUAD NORMAL JOINT	
2	SPLICE CHAMBER		10	OFC	
3	KILOMETER STONE		11	DUCT	
4	CULVERT		12	OPEN TRENCH	
5	G I PIPE		13	BORE	
6	RCC PIPE		14	HDD	
7	GURDER BRIDGE		15	QUAD CABLE	
8	SUB MILE STONE		16	TELE POLE	



RAILTEL

RAILTEL CORPORATION OF INDIA LIMITED

RAILWAY STATION - DOMINGARH TO MUNDERWA

DRAWING TITLE: CABLE ROUTE PLAN

DRAWING NO.:

SHEET No.


PROJECT CODE:

SECTION:

DOMINGARH TO JAGATBELA

M/s R.S. TRADERS

JAGAT BELA

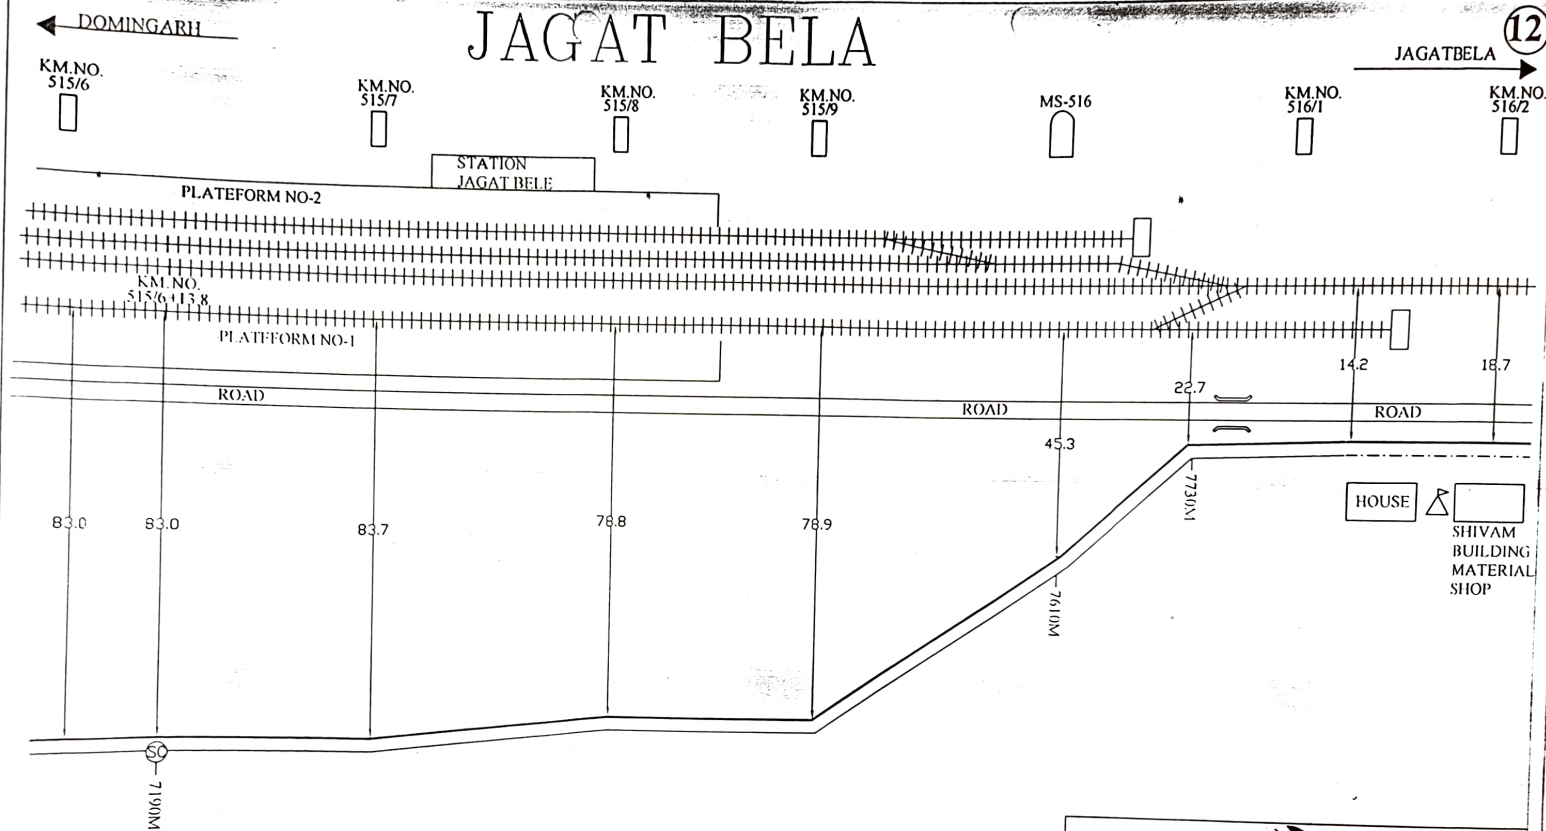

Legends

1.	COPPER 40mm		9.	6 QUAD NORMAL JOINT	
2.	SPLICE CHAMBER		10.	OFC	
3.	KILOMETER STONE		11.	DUCT	
4.	CULVERT		12.	OPEN TRENCH	
5.	G.I PIPE		13.	BORE	
6.	RCC PIPE		14.	HDD	
7.	GURDER BRIDGE		15.	QUAD CABLE	
8.	SUB MILE STONE		16.	TELE. POLE	



RAILTEL

RAILTEL CORPORATION OF INDIA LIMITED

RAILWAY STATION - DOMINGARH TO MUNDERWA

DRAWING TITLE: CABLE ROUTE PLAN

DRAWING NO.:

SHEET No.

PROJECT CODE:

SECTION:


JAGATBELA TO SAHJANWA

M/s R.S. TRADERS

JAGATBELA.

SAHJANWA

13

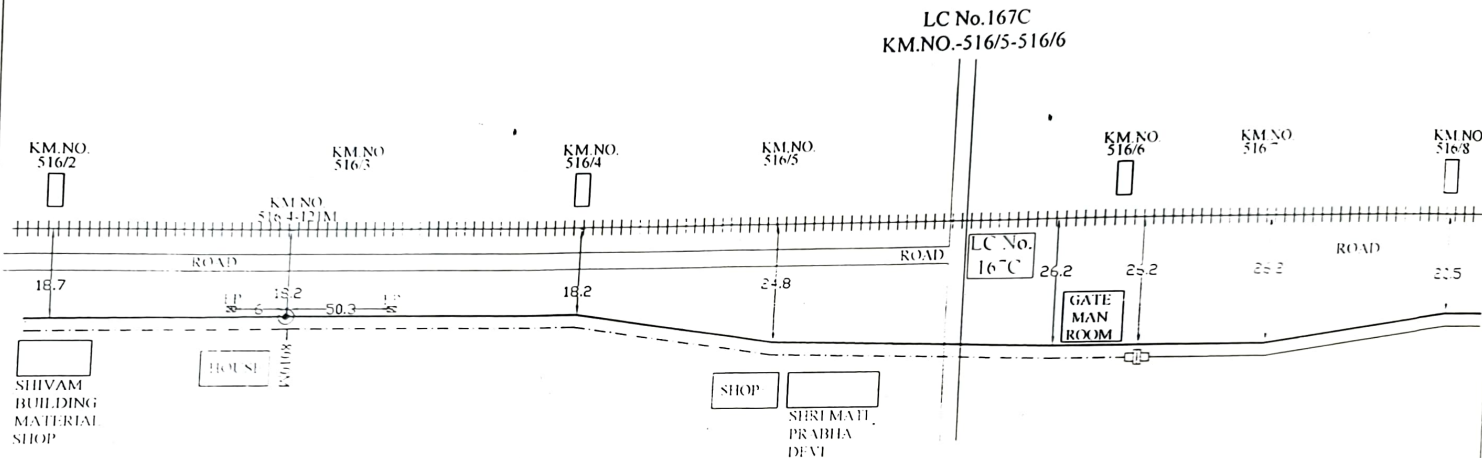

Legends

1.	COUPLER 4 mm		6 QUAD NORMAL JOINT	
2.	SPLICE CHAMBER		CFC	
3.	KILOMETER STONE		DUCT	
4.	CULVERT		OPEN TRENCH	
5.	G.I PIPE		STRE	
6.	RCC PIPE		POD	
7.	GURDER BRIDGE		QUAD CABLE	
8.	SUB MILE STONE		TELE POLE	



RAILTEL

RAILTEL CORPORATION OF INDIA LIMITED

RAILWAY STATION - DOMINGARH TO MUNDERWA

DRAWING TITLE: CABLE ROUTE PLAN

DRAWING NO.:

SHEET No.

PROJECT CODE:


SECTION:

JAGATBELA TO SAHJANWA

M s R S. TRADERS

JAGATBELA

SAHJANWA

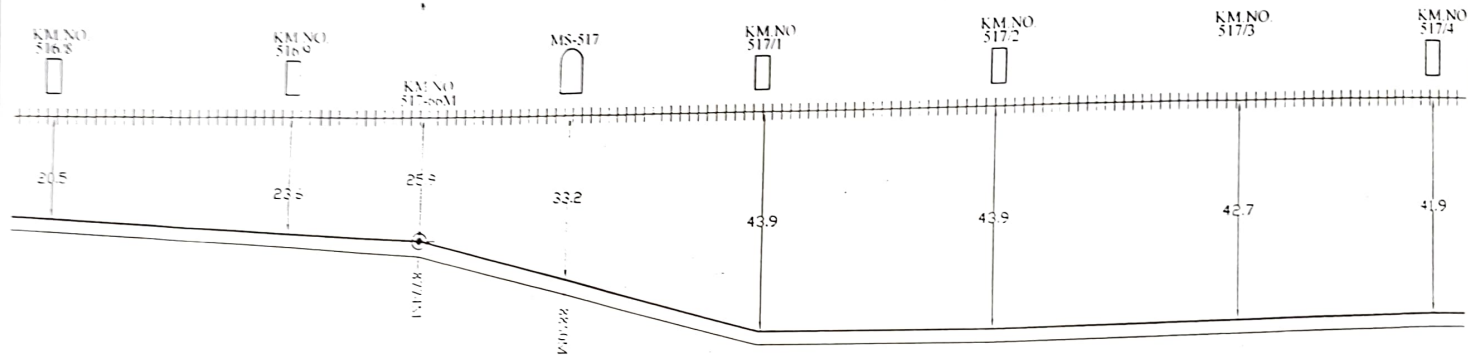

Legends




RAILTEL

RAILTEL CORPORATION OF INDIA LIMITED

RAILWAY STATION - DOMINGARH TO MUNDERWA

DRAWING TITLE: CABLE ROUTE PLAN

DRAWING NO.:

SHEET No.

PROJECT CODE:

SECTION: DOMINGARH TO SAHJANWA

M/s R.S. TRADERS

JAGATBELA

SAHJANWA

15

KM.NO.
517/4KM.NO.
517/5KM.NO.
517/6KM.NO.
517/7KM.NO.
517/8KM.NO.
517/9

MS-518

41.9

41.9

38.9

37.9

38.3

38.3

38.3

9855M

Legends

1.	COUPLER 40mm		9.	6 QUAD NORMAL JOINT	
2.	SPLICE CHAMBER		10.	OFC	
3.	KILOMETER STONE		11.	DUCT	
4.	CULVERT		12.	OPEN TRENCH	
5.	G.I PIPE		13.	BORE	
6.	RCC PIPE		14.	HDD	
7.	GULLY BRIDGE		15.	QUAD CABLE	
8.	SUB MILE STONE		16.	TELE. POLE	



RAI LTEL

RAILTEL CORPORATION OF INDIA LIMITED

RAILWAY STATION - DOMINGARH TO MUNDERWA

DRAWING TITLE: CABLE ROUTE PLAN

DRAWING NO.:

SHEET No.

PROJECT CODE:

SECTION:

DOMINGARH TO SAHJANWA

M/s B.S. TRADERS

JAGATBELA

SAHJANWA

MS-518

KM.NO.
518/1KM.NO.
518/2KM.NO.
518/3KM.NO.
518/4KM.NO.
518/5KM.NO.
518/6

38.3

38.3

40.9

60.9

85.9

87.2

87.2

10055M

10273M

Legends

1	COUPLER 40mm		9	6 QUAD NORMAL JOINT	
2	SPLICE CHAMBER		10	OFC	
3	KILOMETER STONE		11	DUCT	
4	CULVERT		12	OPEN TRENCH	
5	G.I PIPE		13	BORE	
6	RCC PIPE		14	HDD	
7	GURDER BRIDGE		15	QUAD CABLE	
8	SUB MILE STONE		16	TELE. POLE	



RAI LT EL

RAILTEL CORPORATION OF INDIA LIMITED

RAILWAY STATION - DOMINGARH TO MUNDERWA

DRAWING TITLE: CABLE ROUTE PLAN


DRAWING NO.:

SHEET No.

PROJECT CODE:

SECTION: DOMINGARH TO SAHJANWA

M/s B.S. TRADERS

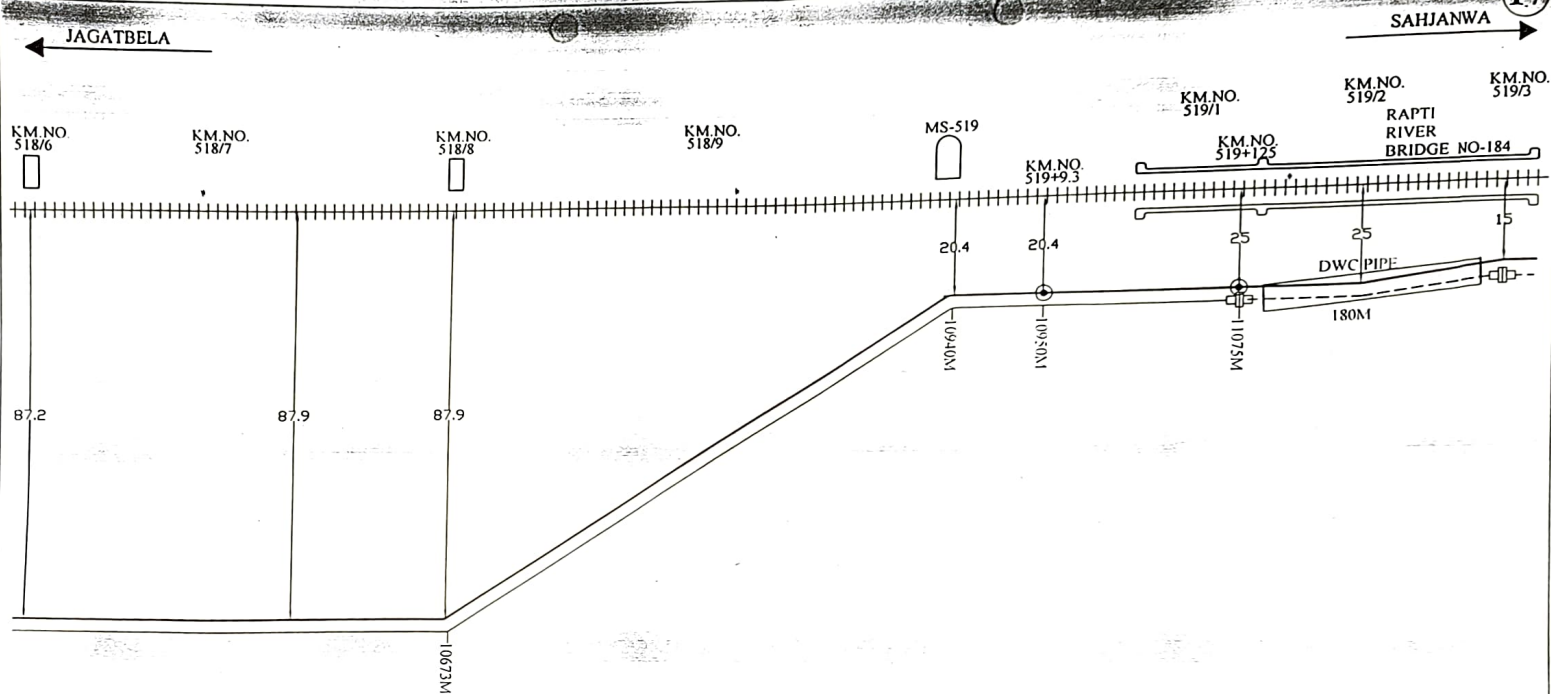

Legends

1. COUPLER 40mm		9. 6 QUAD NORMAL JOINT	
2. SPLICE CHAMBER		10. OFC	
3. KILOMETER STONE		11. DUCT	
4. CULVERT		12. OPEN TRENCH	
5. G.I. PIPE		13. BORE	
6. RCC PIPE		14. HDD	
7. GIRDER BRIDGE		15. QUAD CABLE	
8. SUB MILE STONE		16. TELE. POLE	



RAI LTEL

RAILTEL CORPORATION OF INDIA LIMITED

RAILWAY STATION - DOMINGARH TO MUNDERWA

DRAWING TITLE: CABLE ROUTE PLAN

DRAWING NO.:

SHEET No.

PROJECT CODE:

SECTION:


DOMINGARH TO SAHJANWA

M/s R.S. TRADERS

JAGATBELA

SAHJANWA

18

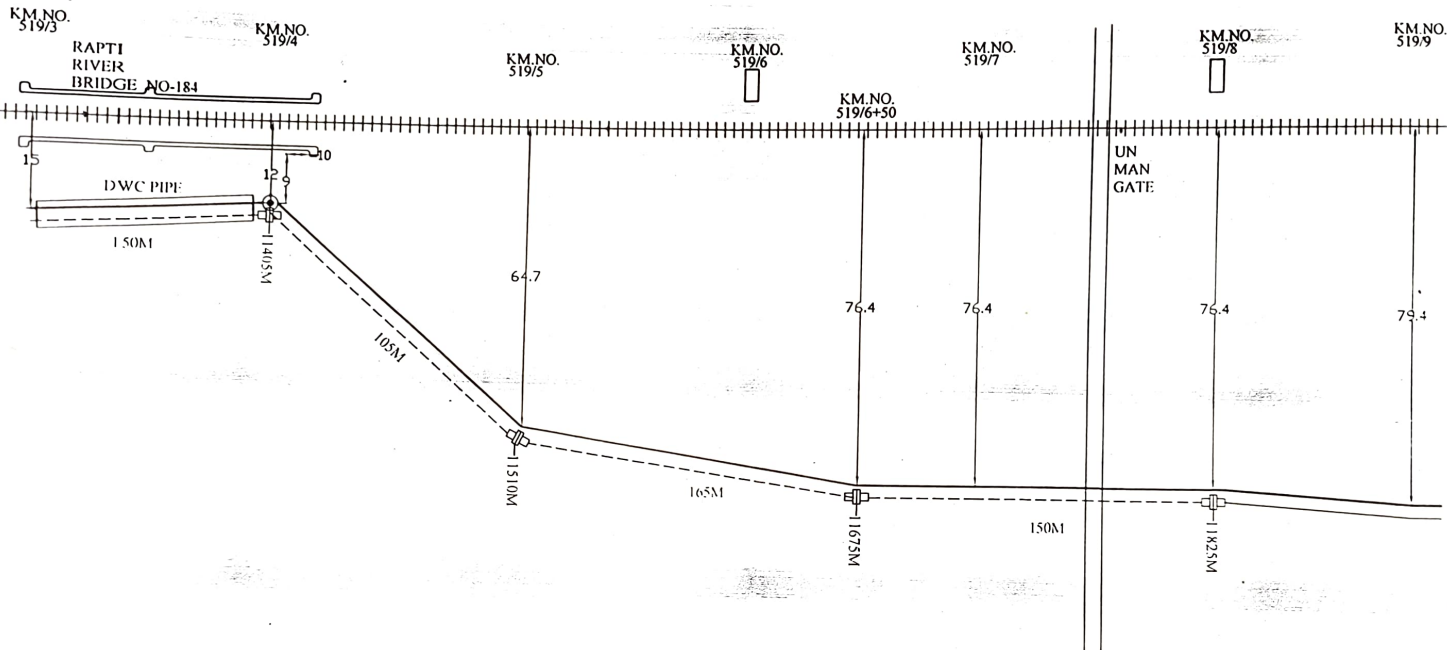

Legends

1	COUPLER 40mm		9.	6 QUAD NORMAL JOINT	
2	SPLICE CHAMBER		10.	OFC	
3	KILOMETER STONE		11.	DUCT	
4	CULVERT		12.	OPEN TRENCH	
5	G.I PIPE		13.	BORE	
6	RCC PIPE		14.	HDD	
7	GU RDER BRIDGE		15.	QUAD CABLE	
8	SUB MILE STONE		16.	TELE POLE	



RAILTEL

RAILTEL CORPORATION OF INDIA LIMITED

RAILWAY STATION - DOMINGARH TO MUNDERWA

DRAWING TITLE: CABLE ROUTE PLAN

DRAWING NO.:

SHEET No.

PROJECT CODE:

SECTION:

DOMINGARH TO SAHJANWA

M/S R.S. TRADERS


JAGATBELA

SAHJANWA

19

KM.NO.
519/9

MS-520

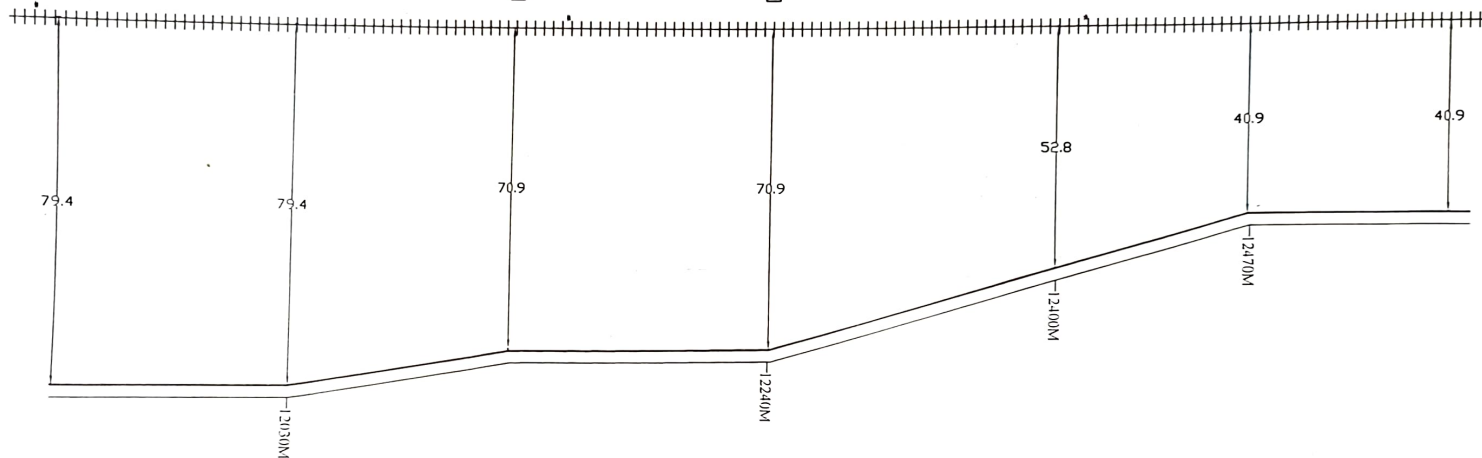KM.NO.
520/1KM.NO.
520/2KM.NO.
520/3KM.NO.
520/4KM.NO.
520/5

Legends

1	COUPLER 40mm		9	6 QUAD NORMAL JOINT	
2	SPLICE CHAMBER		10	OFC	
3	KILOMETER STONE		11	DUCT	
4	CULVERT		12	OPEN TRENCH	
5	G.I PIPE		13	BORE	
6	RCC PIPE		14	HDD	
7	GURDER BRIDGE		15	QUAD CABLE	
8	SUB MILE STONE		16	TELE POLE	



RAI LTEL

RAILTEL CORPORATION OF INDIA LIMITED

RAILWAY STATION - DOMINGARH TO MUNDERWA

DRAWING TITLE: CABLE ROUTE PLAN

DRAWING NO.:

SHEET No.


PROJECT CODE:

SECTION:

DOMINGARH TO SAHJANWA

M/S R.S. TRADERS

JAGATBELA

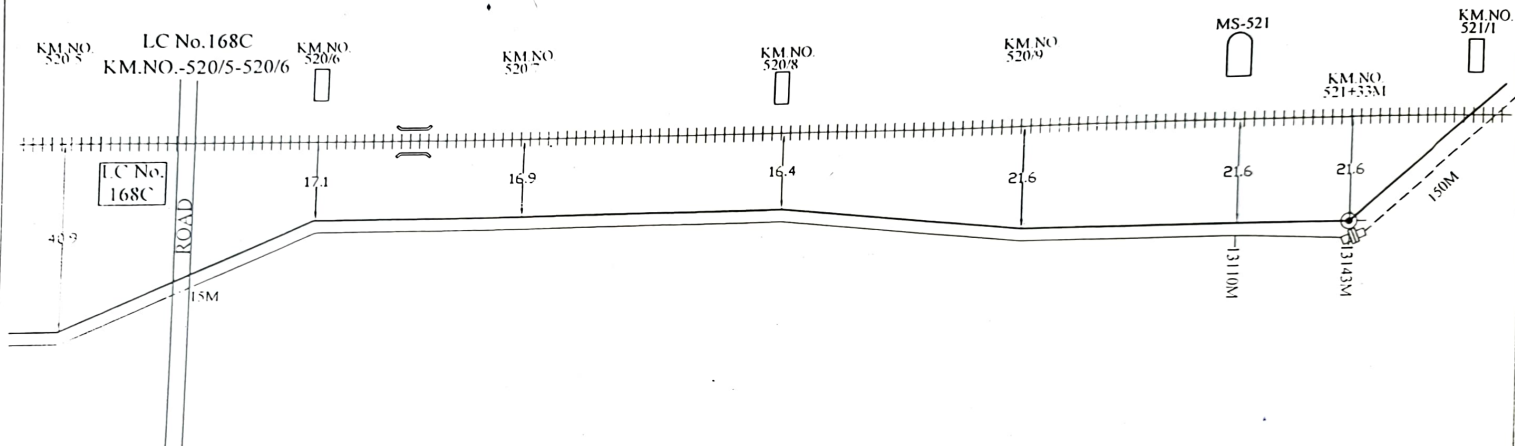

Legends

Legends					
1	COUPLER 40mm		9	6 QUAD NORMAL JOINT	
2	SPLICE CHAMBER		10	OFC	
3	KILOMETER STONE		11	DUCT	
4	CULVERT		12	OPEN TRENCH	





RAILWAY STATION - DOMINGARH TO MUNDERWA

DRAWING TITLE:	CABLE ROUTE PLAN
----------------	------------------

DRAWING NO.:

SHEET No. _____

PROJECT CODE:


SECTION:	DOMINGARH TO SAHJANWA
----------	-----------------------

~~M/s R.S. TRADERS~~

JAGATBELA

SAHJANWA

21

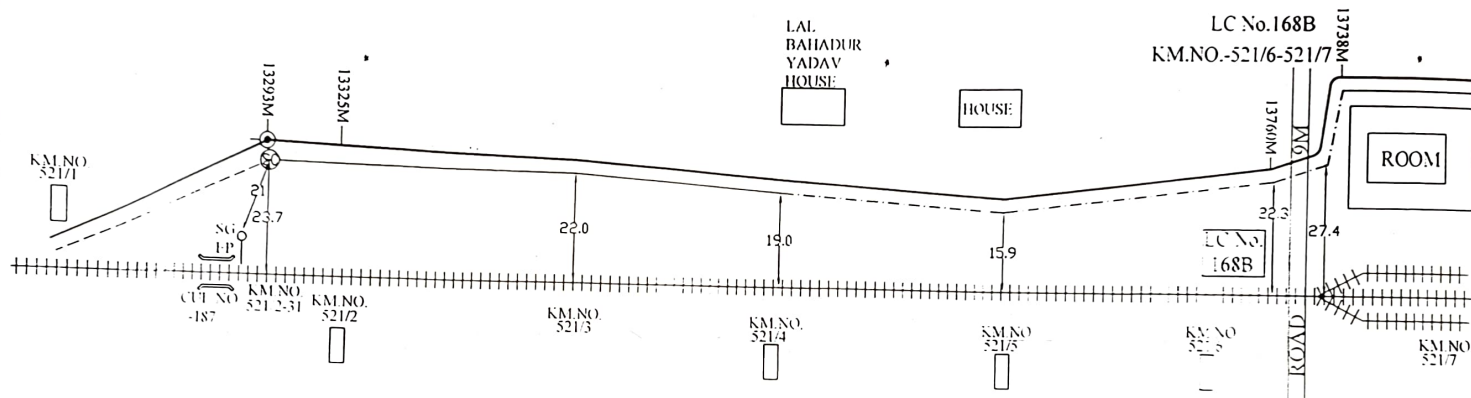

Legends

1. COUPLER 40mm		9. 6 QUAD NORMAL JOINT	
2. SPLICE CHAMBER		10. OFC	
3. KILOMETER STONE		11. DUCT	
4. CULVERT		12. OPEN TRENCH	
5. G.I PIPE		13. BORE	
6. RCC PIPE		14. HDD	
7. GIRDER BRIDGE		15. QUAD CABLE	
8. SUBMILSTONE		16. TELE POLE	



RAI TEL

RAI TEL CORPORATION OF INDIA LIMITED

RAILWAY STATION - DOMINGARH TO MUNDERWA

DRAWING TITLE: CABLE ROUTE PLAN

DRAWING NO.:

SHEET No.

PROJECT CODE

SECTION: DOMINGARH TO SAHJANWA


M/s R.S. TRADERS

JAGATBELA

SAHJANWA

SAHJANWA

22

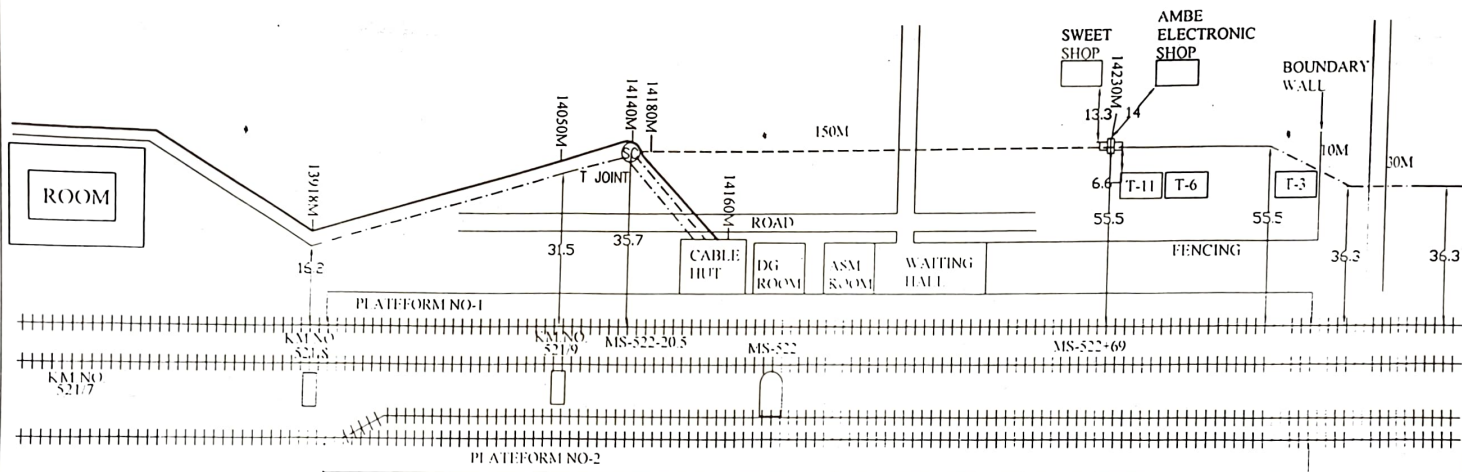

Legends

1	COUPLER 40mm		9	6 QUAD NORMAL JOINT	
2	SPLICE CHAMBER		10	OFC	
3	KILOMETER STONE		11	DUCT	
4	CULVERT		12	OPEN TRENCH	
5	G.I PIPE		13	BORE	
6	RCC PIPE		14	HDD	
7	GURDER BRIDGE		15	QUAD CABLE	
8	SUB MILE STONE		16	TELE. POLE	



RAI TEL

RAILTEL CORPORATION OF INDIA LIMITED

RAILWAY STATION - DOMINGARH TO MUNDERWA

DRAWING TITLE: CABLE ROUTE PLAN

DRAWING NO.:

SHEET No.

PROJECT CODE:

SECTION: DOMINGARH TO SAHJANWA


M/s R.S. TRADERS

JAGATBELA

SIHAPAR HALT

23

LC No.169B
KM.NO.-522/5-522/6

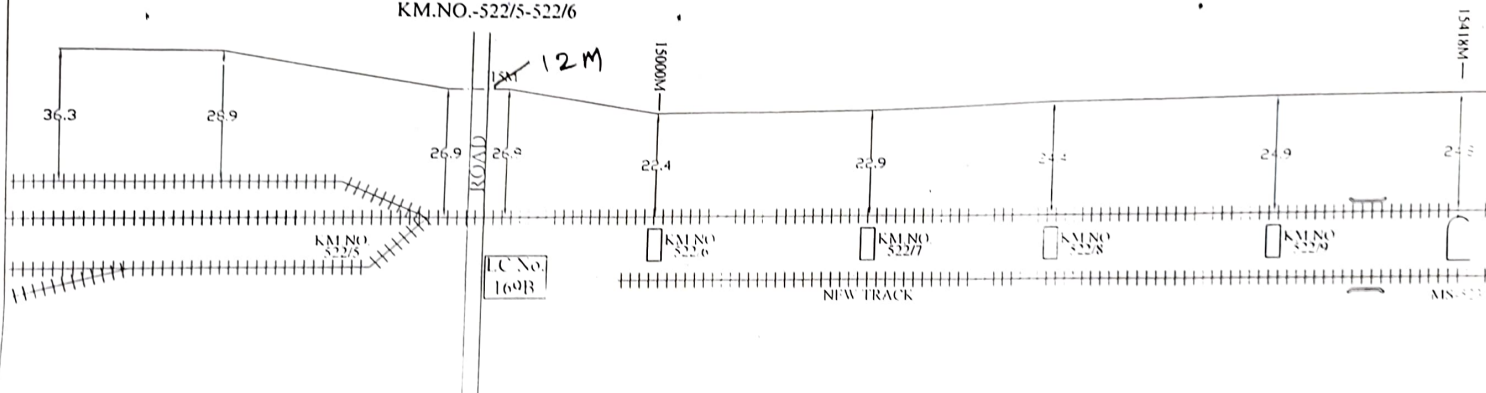

Legends

1	COUPLER 40mm		9	FOUR QUAD NORMAL JONT	
2	SPLICE CHAMBER		10	OFC	
3	KILOMETER STONE		11	DUCT	
4	CULVERT		12	OPEN TRENCH	
5	G.I PIPE		13	BORE	
6	RCC PIPE		14	HDD	
7	GURDER BRIDGE		15	QUAD CABLE	
8	SUB MILE STONE		16	TILE POLE	



RAILTEL

RAILWAY STATION - DOMINGARH TO MUNDERWA

DRAWING TITLE: CABLE ROUTE PLAN

DRAWING NO.:

SHEET No.

PROJECT CODE:

SECTION: SAHANWA TO SIHAPAR HALT


M/s R.S. TRADERS

JAGATBELA

SIHAPAR HALT

24

SARIYA
FACTORY

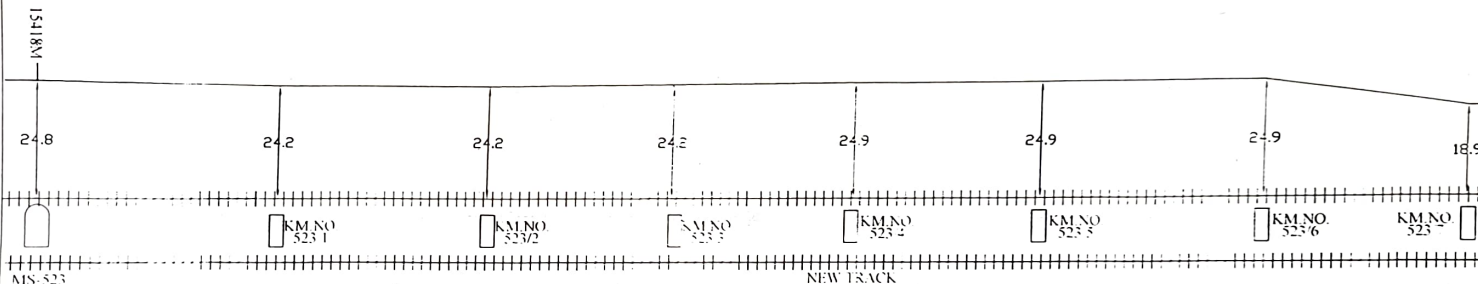

Legends

1	COUPLER 4"		9	6 QUAD NORMAL JOINT	
2	SPLICE CHAMBER		10	OFC	
3	KILOMETER STONE		11	DUCT	
4	CULVERT		12	OPEN TRENCH	
5	G.I. PIPE		13	BORE	
6	RCC PIPE		14	HDD	
7	GURDER BEAM		15	QUAD CABLE	
8	SUB MER STONE		16	TELE POLE	



RAILTEL

RAILTEL CORPORATION OF INDIA LIMITED

RAILWAY STATION - DOMINGARH TO MUNDERWA

DRAWING TITLE: CABLE ROUTE PLAN

DRAWING NO.:

SHEET No.

PROJECT CODE


SECTION: SARJANWA TO SIHAPAR HALT

M/s R.S. TRADERS

JAGATBELA

SIHAPARHALT

25

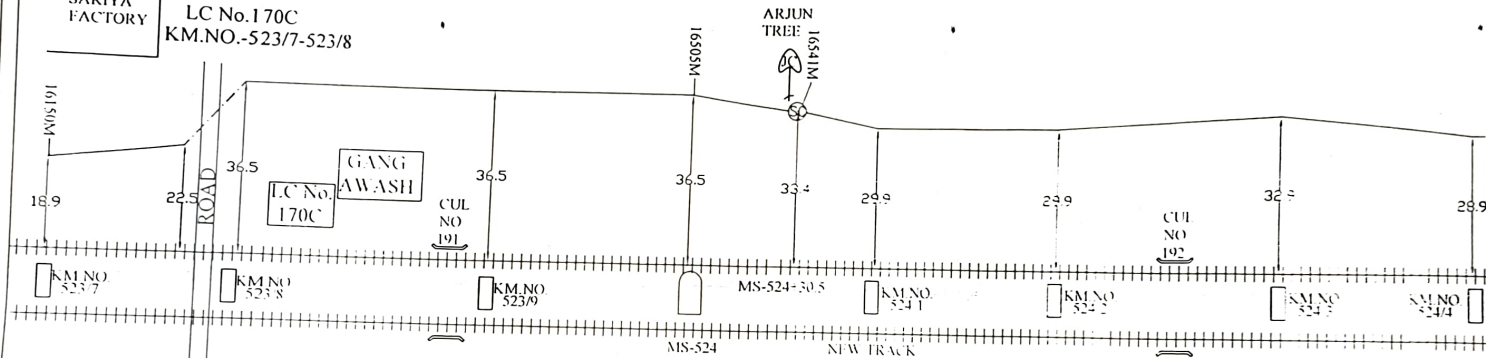SARIYA
FACTORYLC No.170C
KM.NO.-523/7-523/8

Legends

1	COUPLER 40mm		9.	6 QUAD NORMAL JOINT	
2	SPLICE CHAMBER		10	OFC	
3	KILOMETER STONE		11	DUCT	
4	CULVERT		12	OPEN TRENCH	
5	G.I PIPE		13	BORE	
6	RCC PIPE		14	HDD	
7	GIRDER BRIDGE		15	QUAD CABLE	
8	SUB MILE STONE		16	TELE. POLE	



RAI TEL

RAILTEL CORPORATION OF INDIA LIMITED

RAILWAY STATION - DOMINGARH TO MUNDERWA

DRAWING TITLE: CABLE ROUTE PLAN

DRAWING NO.:

SHEET No.

PROJECT CODE:

SECTION:

SAHJANWA TO SIHAPARHALT


M/s R.S. TRADERS

JAGATBELA

SIHAPAR HALT

26

LC No. 171C
KM.NO.-524/8-524/9

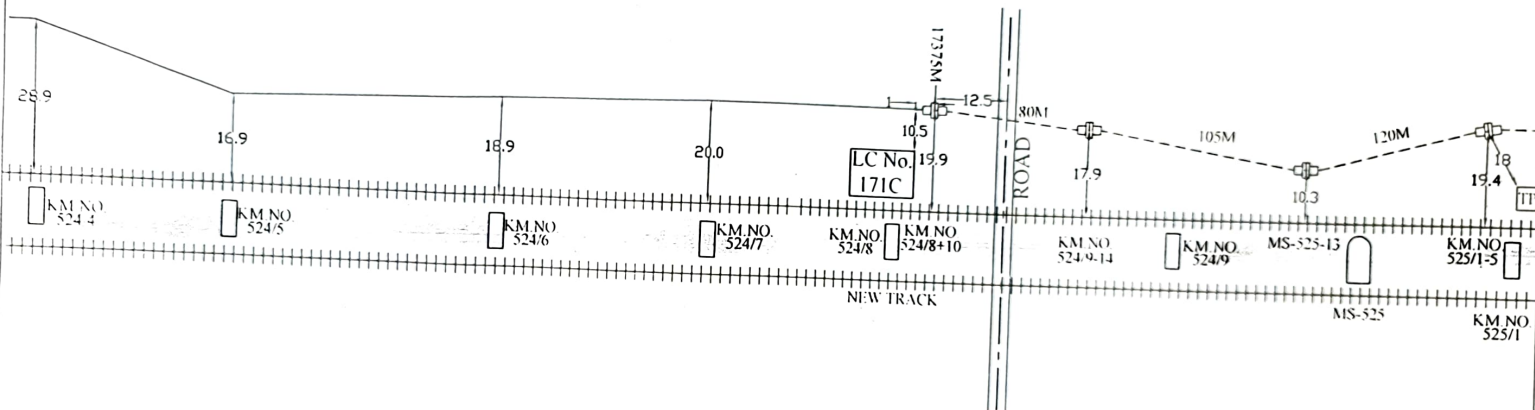

Legends

1	COUPLER 40mm		9	6 QUAD NORMAL JOINT	
2	SPLICE CHAMBER		10	OFC	
3	KILOMETER STONE		11	DUCT	
4	CULVERT		12	OPEN TRENCH	
5	G.I PIPE		13	BORE	
6	RCC PIPE		14	HDD	
7	GURDER BRIDGE		15	QUAD CABLE	
8	SUB MILE STONE		16	TELE POLE	



RAILTEL

RAILTEL CORPORATION OF INDIA LIMITED

RAILWAY STATION - DOMINGARH TO MUNDERWA

DRAWING TITLE: CABLE ROUTE PLAN

DRAWING NO.:

SHEET No

PROJECT CODE:

SECTION:


SAHJANWA TO SIHAPAR HALT

M/s R.S. TRADERS

JAGATBELA

SIHAPAR HALT

27

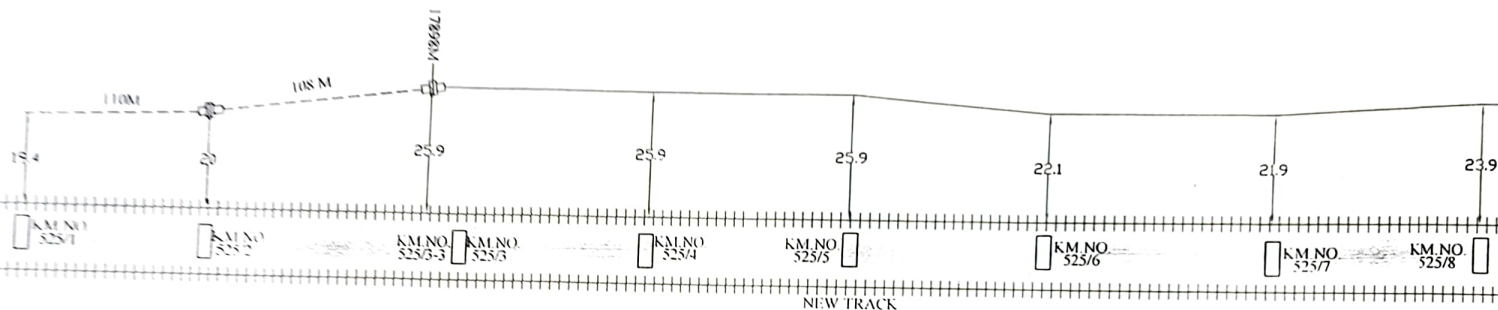

Legends

1	COUPLER 40mm		9	6 QUAD NORMAL JOINT	
2	SPLICE CHAMBER		10	OFC	
3	KILOMETER STONE		11	DUCT	
4	CULVERT		12	OPEN TRENCH	
5	G.I PIPE		13	BORE	
6	R/C PIPE		14	HDD	
7	GURDER BRIDGE		15	QUAD CABLE	
8	SUB MILE STONE		16	TELE. POLE	



RAILTEL

RAILTEL CORPORATION OF INDIA LIMITED

RAILWAY STATION - DOMINGARH TO MUNDERWA

DRAWING TITLE: CABLE ROUTE PLAN

DRAWING NO.:


SHEET No.

PROJECT CODE:

SECTION:

SAHJANWA TO SIHAPAR HALT

M/s R.S. TRADERS

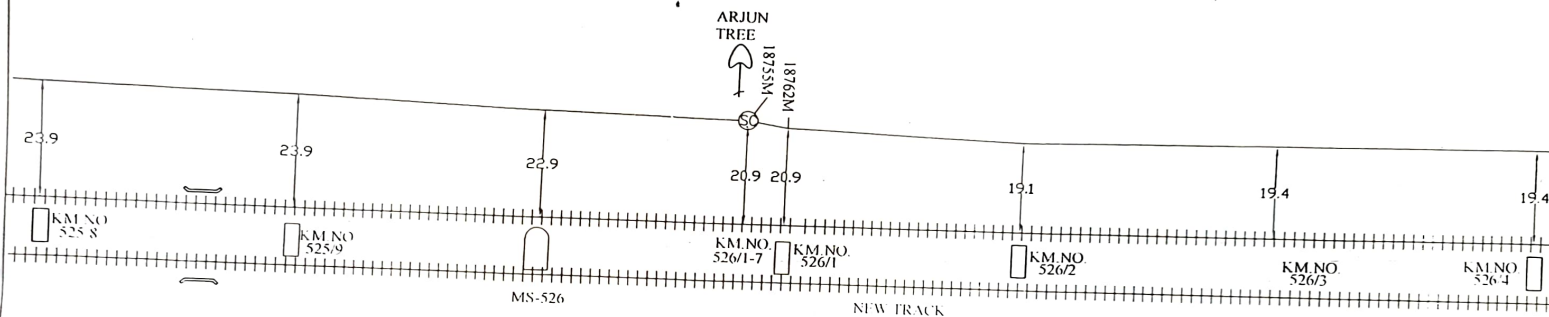

Legends

1	COUPLER 40mm		9	6 QUAD NORMAL JOINT	
2	SPLICE CHAMBER		10	OFC	
3	KILOMETER STONE		11	DUCT	
4	CULVERT		12	OPEN TRENCH	
5	G.I PIPE		13	BORE	
6	RCC PIPE		14	HDD	
7	GIRDER BRIDGE		15	LOAD CABLE	
8	500 MILE STONE		16	TELE POLE	



RAI LTEL

RAILTEL CORPORATION OF INDIA LIMITED

RAILWAY STATION - DOMINGARH TO MUNDERWA

DRAWING TITLE: CABLE ROUTE PLAN

DRAWING NO.:


SHEET No.

PROJECT CODE:

SECTION:

SAHJANWA TO SIHAPAR HALT

M/s R.S. TRADERS

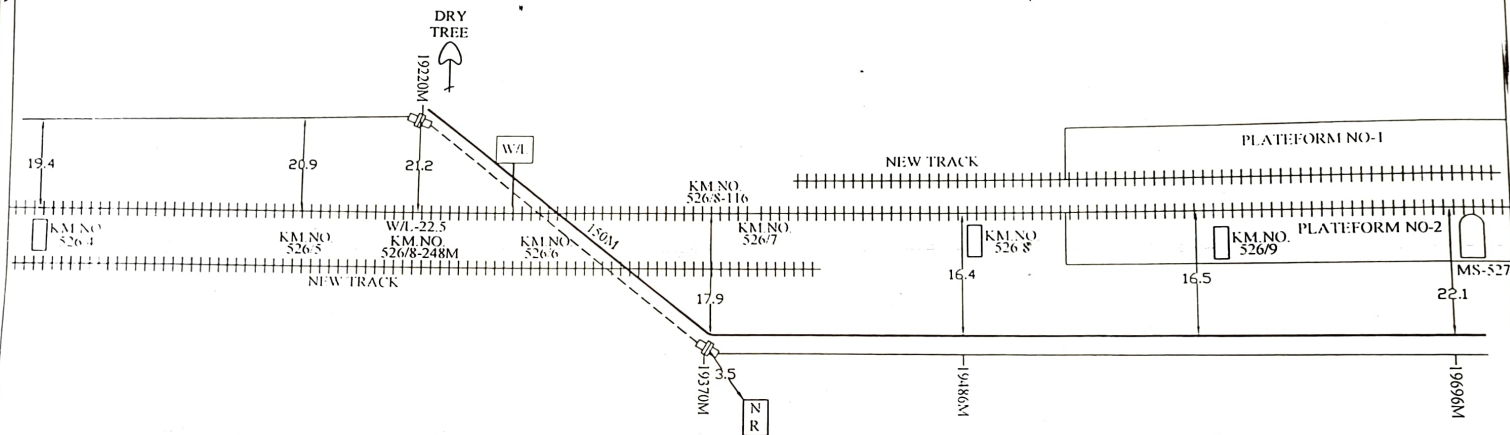

Legends

1	COUPLER 40mm		9.	6 QUAD NORMAL JOINT	
2	SPLICE CHAMBER		10.	OFC	——
3	KILOMETER STONE		11.	DUCT	——
4	CUTVERT		12.	OPEN TRENCH	——



RAI LTEL

RILTEL CORPORATION OF INDIA LIMITED

RAILWAY STATION - DOMINGARH TO MUNDERWA

DRAWING TITLE:	CABLE ROUTE PLAN
----------------	------------------

DRAWING NO.:

SHEET No.

PROJECT CODE:

SECTION:

SAHJANWA TO SIHAPAR HALT

M/s R.S. TRADERS


SIHAPAR HALT

MAGHAR

30'

SIHAPAR HALT

LC No.171A
KM.NO.-527/2-527/3

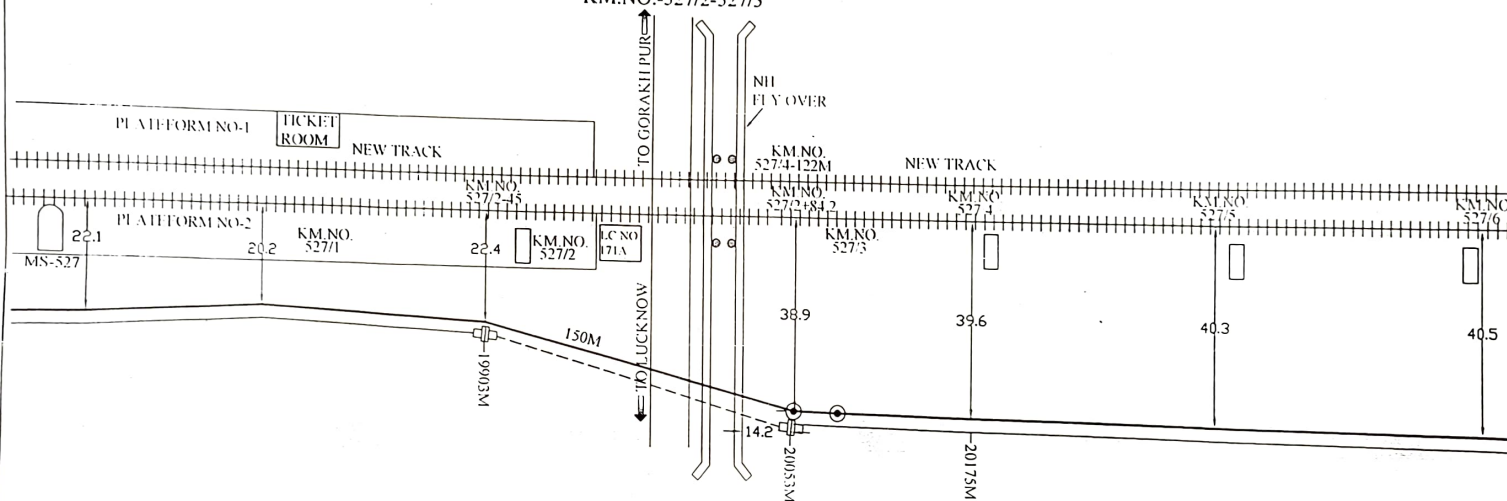

Legends

1. COUPLER 40mm		9. 6 QUAD NORMAL JOINT	
2. SPLICE CHAMBER		10. OFC	
3. KILOMETER STONE		11. DUCT	
4. CULVERT		12. OPEN TRENCH	
5. GI PIPE		13. BORE	
6. RCC PIPE		14. HDD	
7. GURDER BRIDGE		15. QUAD CABLE	
8. SUB MILE STONE		16. TELE POLE	



RAILTEL

RAILTEL CORPORATION OF INDIA LIMITED

RAILWAY STATION - DOMINGARH TO MUNDERWA

DRAWING TITLE: CABLE ROUTE PLAN

DRAWING NO.:

SHEET No.

PROJECT CODE:

SECTION:


SIHAPAR HALT TO MAGHAR

M/S. S. S. TRADERS

SIHAPAR HALT

MAGHAR

31

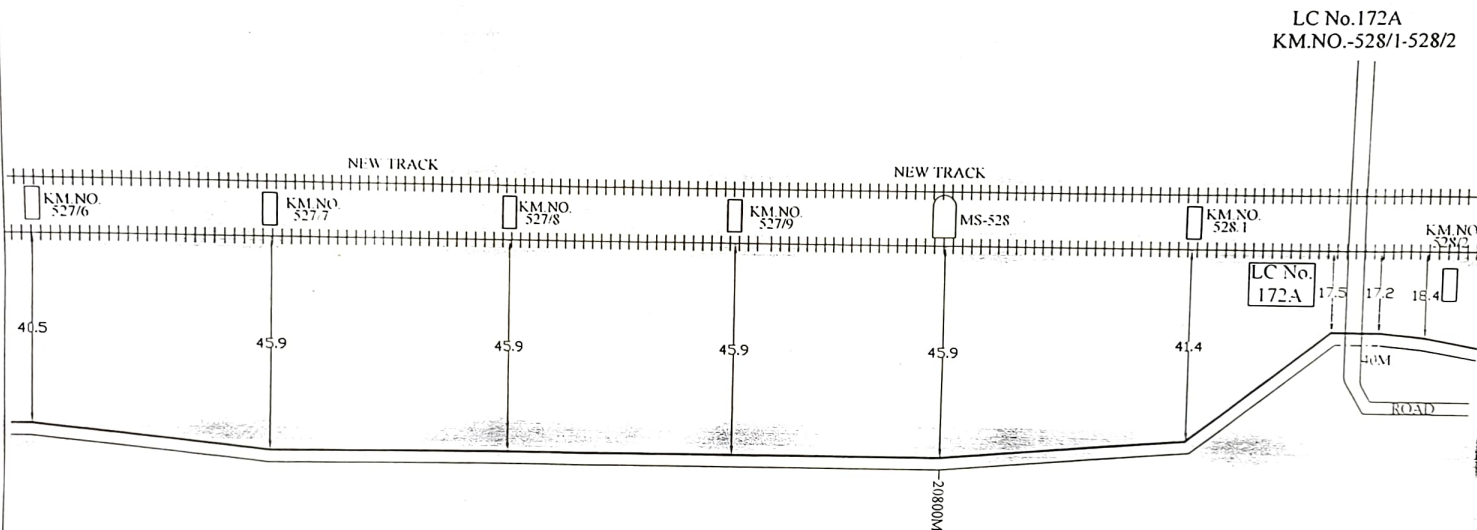

Legends

1. COUPLER 40mm		9. 6 QUAD NORMAL JOINT	
2. SPLICE CHAMBER		10. OFC	
3. KILOMETER STONE		11. DUCT	
4. CULVERT		12. OPEN TRENCH	
5. G.I PIPE		13. BORE	
6. RCC PIPE		14. HDD	
7. GURDER BRIDGE		15. QUAD CABLE	
8. SUB MILE STONE		16. TELE POLE	



RAILTEL

RAILTEL CORPORATION OF INDIA LIMITED

RAILWAY STATION - DOMINGARH TO MUNDERWA

DRAWING TITLE: CABLE ROUTE PLAN

DRAWING NO.:

SHEET No.

PROJECT CODE:

SECTION:


SIHAPAR HALT TO MAGHAR

M/R S. TRADERS

SIHAPAR HALT

MAGHAR

32

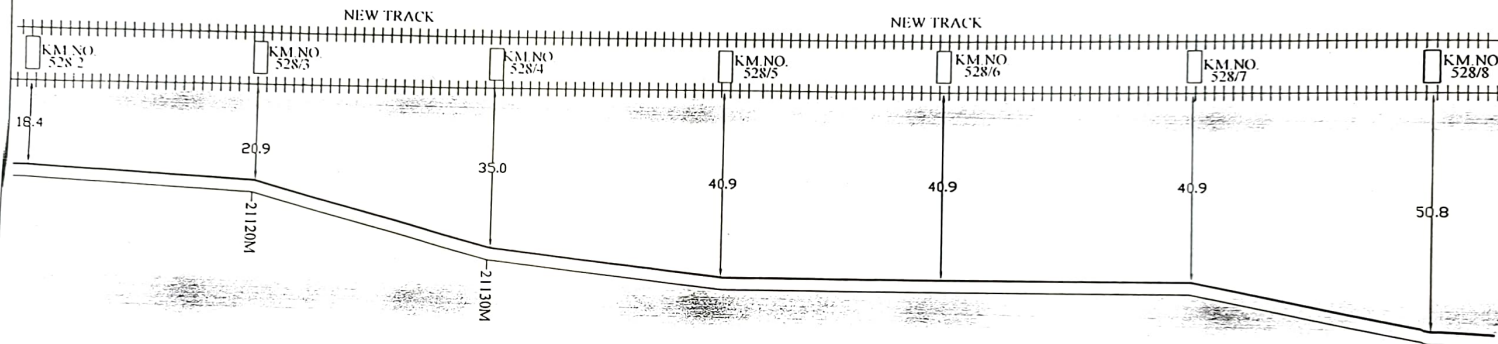

Legends

1.	COUPLER 40mm		9.	6 QUAD NORMAL JOINT	
2.	SPLICE CHAMBER		10.	OFC	
3.	KILOMETER STONE		11.	DUCT	
4.	CULVERT		12.	OPEN TRENCH	
5.	G.I PIPE		13.	BORE	
6.	RCC PIPE		14.	HDD	
7.	GU RDER BRIDGE		15.	QUAD CABLE	
8.	SUB MILE STONE		16.	TELE POLE	



RAILTEL

RAILTEL CORPORATION OF INDIA LIMITED

RAILWAY STATION - DOMINGARH TO MUNDERWA

DRAWING TITLE: CABLE ROUTE PLAN

DRAWING NO.:

SHEET No.

PROJECT CODE:

SECTION:


SIHAPAR HALT TO MAGHAR

M/s R.S. TRADERS

← SIHAPAR HALT

→ MAGHAR

33

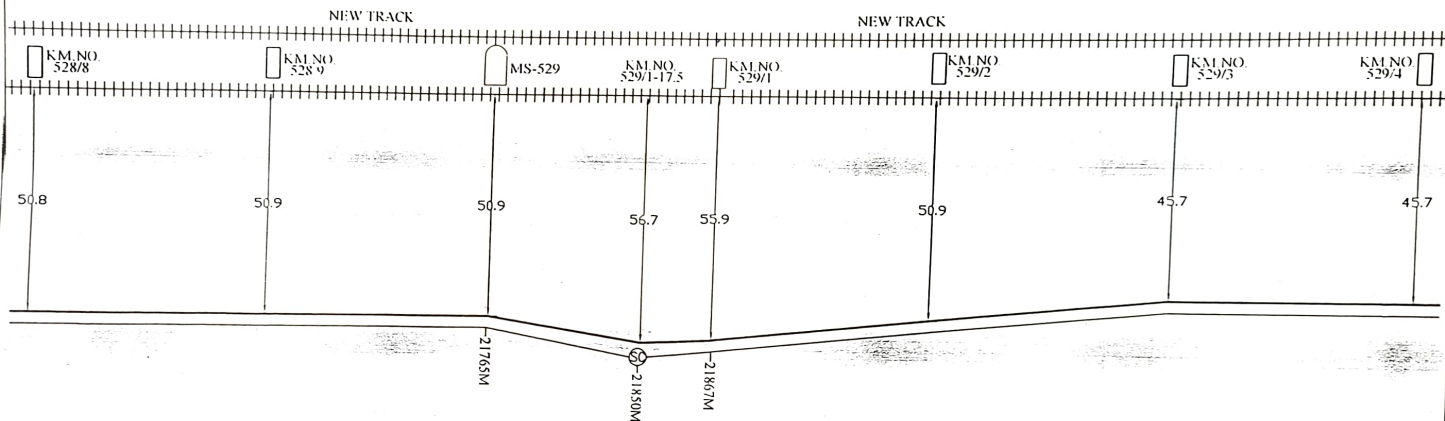

Legends

1.	COUPLER 40mm		9.	6 QUAD NORMAL JOINT	
2.	SPLICE CHAMBER		10.	OFC	
3.	KILOMETER STONE		11.	DUCT	
4.	CULVERT		12.	OPEN TRENCH	
5.	G.I PIPE		13.	BORE	
6.	RCC PIPE		14.	HDD	
7.	GURDER BRIDGE		15.	QUAD CABLE	
8.	SUB MILE STONE		16.	TELE. POLE	



RAILTEL

RAILTEL CORPORATION OF INDIA LIMITED

RAILWAY STATION - DOMINGARH TO MUNDERWA

DRAWING TITLE: CABLE ROUTE PLAN

DRAWING NO.:

SHEET No.

PROJECT CODE:

SECTION:


SIHAPAR HALT TO MAGHAR

M/s R.S. TRADERS

SIHAPAR HALT

MAGHAR

34

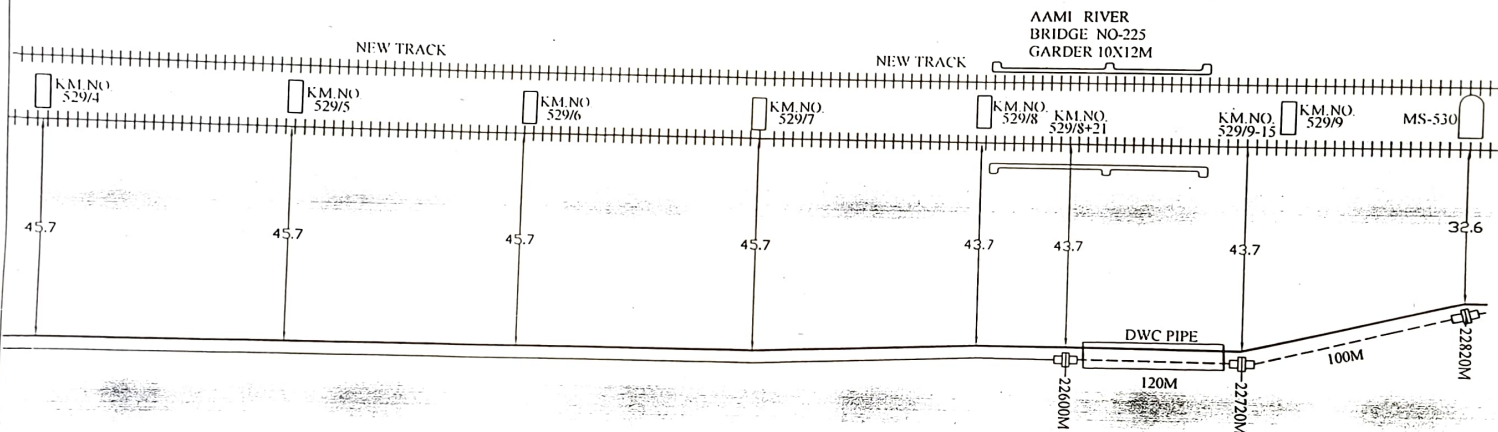

Legends

1.	COUPLER 40mm		9.	6 QUAD NORMAL JOINT	
2.	SPLICE CHAMBER		10.	OFC	
3.	KILOMETER STONE		11.	DUCT	
4.	CULVERT		12.	OPEN TRENCH	
5.	G.I PIPE		13.	BORE	
6.	RCC PIPE		14.	HDD	
7.	GURDER BRIDGE		15.	QUAD CABLE	
8.	SUB MILE STONE		16.	TELE. POLE	



RAILTEL

RAILTEL CORPORATION OF INDIA LIMITED

RAILWAY STATION - DOMINGARH TO MUNDERWA

DRAWING TITLE: CABLE ROUTE PLAN

DRAWING NO.:

SHEET No.

PROJECT CODE:

SECTION:

SIHAPAR HALT TO MAGHAR

M/s R.S. TRADERS

MAGHAR

35



RAILTEI

RAILTEL CORPORATION OF INDIA LIMITED

RAILWAY STATION - DOMINGARH TO MUNDERWA	
DRAWING TITLE:	CABLE ROUTE PLAN
DRAWING NO.	

DRAWING NO.	CABLE ROUTE PLAN
-------------	------------------


SHEET No.

PROJECT CODE:

SECTION:

MAGHAR TO KHALILABAD

M/s R.S. TRADERS

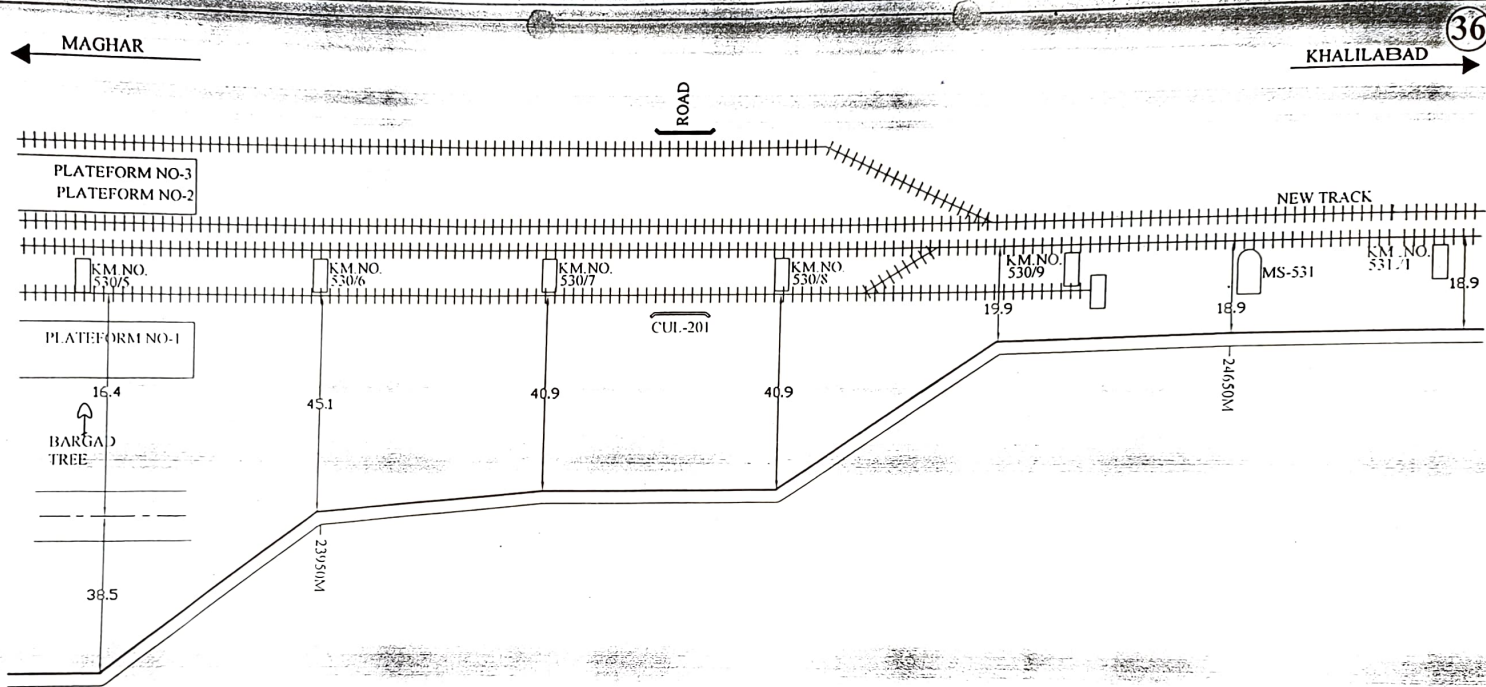

Legends			
1.	COUPLER 40mm		9. 6 QUAD NORMAL JOINT
2.	SPLICE CHAMBER		10. OFC
3.	KILOMETER STONE		11. DUCT
4.	CULVERT		12. OPEN TRENCH
5.	G.I PIPE		13. BORE
6.	RCC PIPE		14. HDD
7.	GURDER BRIDGE		15. QUAD CABLE
8.	SUB MILE STONE		16. TELE. POLE

 RAILTEL CORPORATION OF INDIA LIMITED	
RAILWAY STATION - DOMINGARH TO MUNDERWA	
DRAWING TITLE:	CABLE ROUTE PLAN
DRAWING NO.:	
SHEET No.	
PROJECT CODE:	
SECTION:	MAGHAR TO KHALILABAD
	M/s R.S. TRADERS

MAGHAR

KHALILABAD


37

LC No.173A
KM.NO.-531/1-531/2

LC No.
173A

NEW TRACK

NEW TRACK

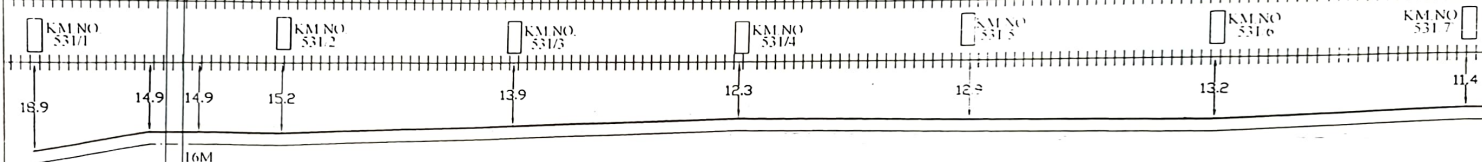

Legends

1. COUPLER 40mm		9. 6 QUAD NORMAL JOINT	
2. SPLICE CHAMBER		10. OFC	
3. KILOMETER STONE		11. DUCT	
4. CULVERT		12. OPEN TRENCH	
5. G.I PIPE		13. BORE	
6. RCC PIPE		14. HDD	
7. GIRDER BRIDGE		15. QUAD CABLE	
8. SUB MILE STONE		16. TELE POLE	



RAI TEL

RAILTEL CORPORATION OF INDIA LIMITED

RAILWAY STATION - DOMINGARH TO MUNDERWA

DRAWING TITLE: CABLE ROUTE PLAN

DRAWING NO.:

SHEET No.

PROJECT CODE:

SECTION:

MAGHAR TO KHALILABAD

M/s R.S. TRADERS


MAGHAR

KHALILABAD

38

LC No. 174C
KM.NO.-532/1-532/2LC No.
174C

NEW TRACK

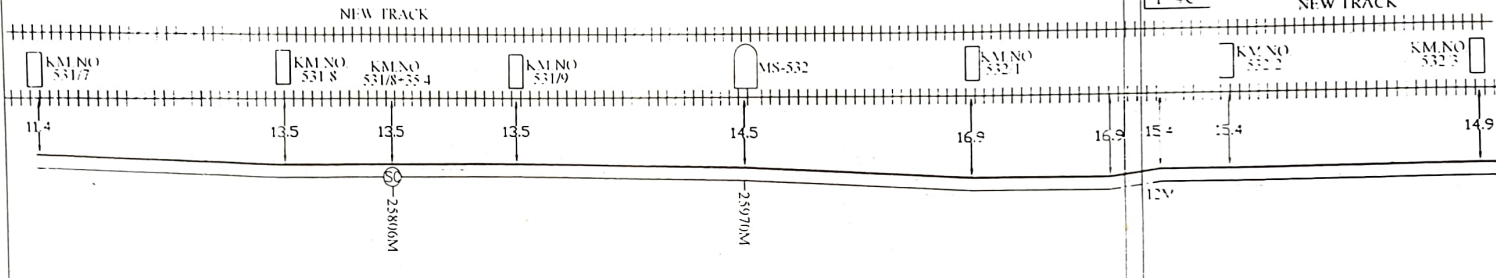

Legends

1	COUPLER		9	QUAD NORMAL JOINT	
2	SPLICE CHAMBER		10	OFC	
3	KILOMETER STONE		11	DUCT	
4	CUMBER		12	OPEN TRENCH	
5	G.I PIPE		13	BORE	
6	RCC PIPE		14	HDD	
7	GURDER BRIDGE		15	QUAD CABLE	
8	SUB MILE STONE		16	TELE POLE	



RAILTEL

RAILTEL CORPORATION OF INDIA LIMITED

RAILWAY STATION - DOMINGARH TO MUNDERWA

DRAWING TITLE: CABLE ROUTE PLAN

DRAWING NO.:

SHEET No.

PROJECT CODE:


SECTION: MAGHAR TO KHALILABAD

M/s R.S. TRADERS

MAGHAR

KHALILABAD

40

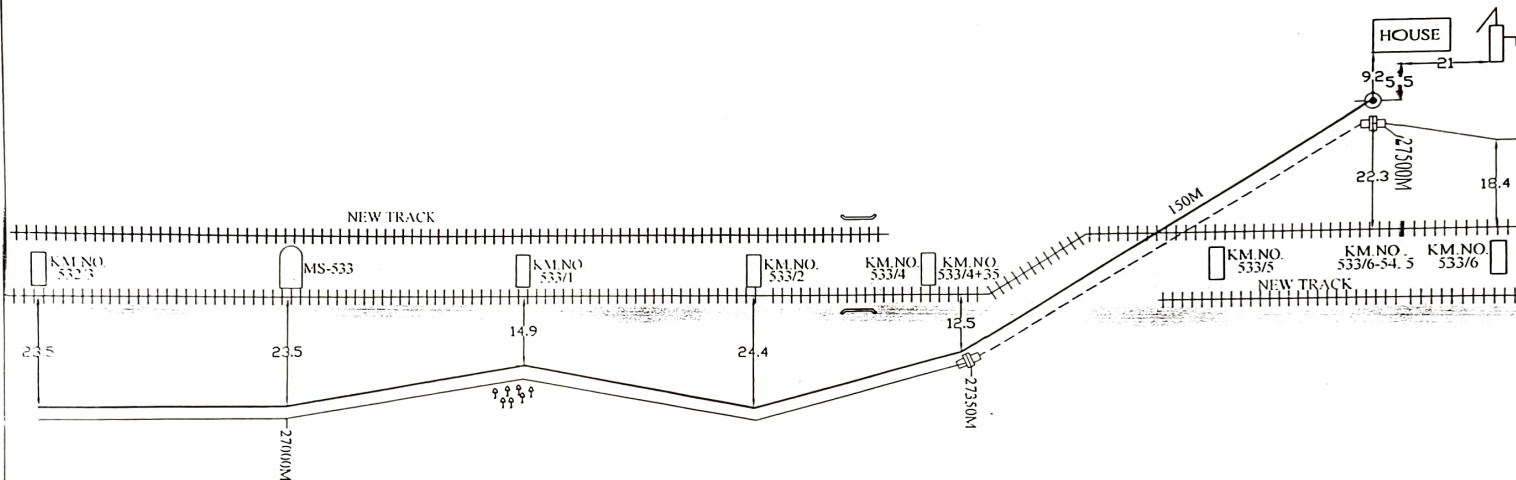

Legends

1	COUPLER 40mm		9.	6 QUAD NORMAL JOINT	
2	SPLICE CHAMBER		10.	OFC	
3	KILOMETER STONE		11.	DUCT	
4	CULVERT		12.	OPEN TRENCH	
5	G.I PIPE		13.	BORE	
6	RCC PIPE		14.	HDD	
7	GURDER BRIDGE		15.	QUAD CABLE	
8	1/2 MILE STONE		16.	TELE. POLE	



RAILTEL

RAILTEL CORPORATION OF INDIA LIMITED

RAILWAY STATION - DOMINGARH TO MUNDERWA

DRAWING TITLE: CABLE ROUTE PLAN

DRAWING NO.:

SHEET No.

PROJECT CODE:


SECTION:

MAGHAR TO KHALILABAD

M/s R.S. TRADERS

MAGHAR

KHALILABAD

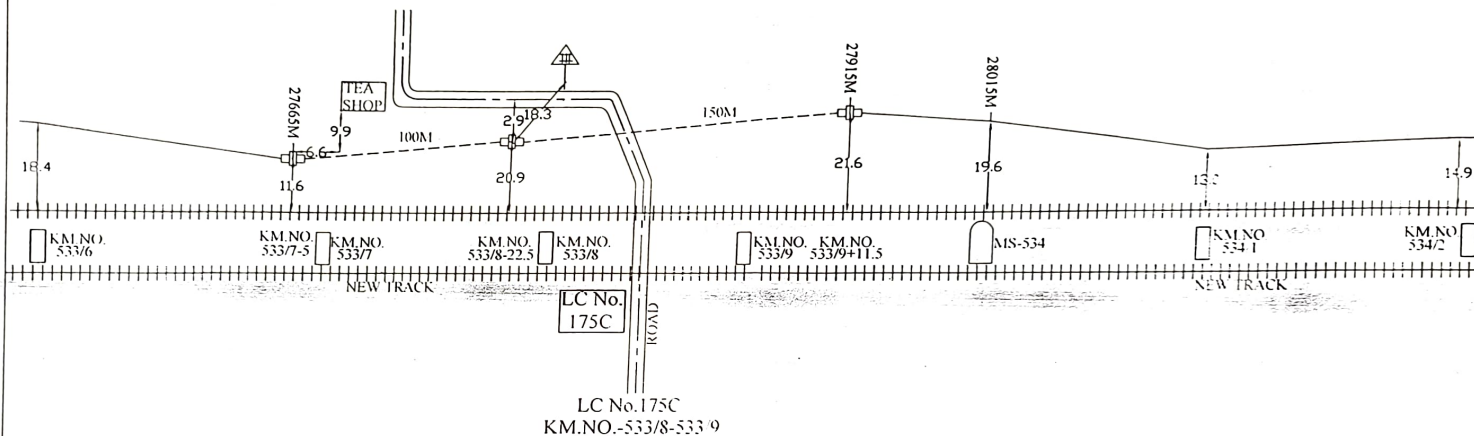

Legends

1. COUPLER 40mm		9. 6 QUAD NORMAL JOINT	
2. SPLICE CHAMBER		10. OFC	
3. KILOMETER STONE		11. DUCT	
4. CULVERT		12. OPEN TRENCH	
5. G.I PIPE		13. BORE	
6. RCC PIPE		14. HDD	
7. GIRDER BRIDGE		15. QUAD CABLE	
8. SUB MILE STONE		16. TELE. POLE	



RAILTEL

RAILTEL CORPORATION OF INDIA LIMITED

RAILWAY STATION - DOMINGARH TO MUNDERWA

DRAWING TITLE: CABLE ROUTE PLAN

DRAWING NO.:

SHEET No.

PROJECT CODE:

SECTION:

MAGHAR TO KHALILABAD

M s R.S. TRADERS

MAGHAR

KHALILABAD

39

NEW TRACK

NEW TRACK

KM NO
532/3KM NO
532/4KM NO
532/5KM NO
532/6KM NO
532/7KM NO
532/8KM NO
532/9

14.9

13.9

13.3

13.3

10.3

8.3

23.5

Legends

1.	COUPLER 40mm		9	6 QUAD NORMAL JOINT	
2.	SPLICE CHAMBER		10	OFC	
3.	KILOMETER STONE		11	DUCT	
4.	CULVERT		12	OPEN TRENCH	
5.	G I PIPE		13	BORE	
6.	RCC PIPE		14	HDD	
7.	GURDER BRIDGE		15	QUAD CABLE	
8.	SUB MILESTONE		16	TELE POLE	



RAI LTEL

RAILTEL CORPORATION OF INDIA LIMITED

RAILWAY STATION - DOMINGARH TO MUNDERWA

DRAWING TITLE: CABLE ROUTE PLAN

DRAWING NO.:

SHEET No.

PROJECT CODE:

SECTION:


MAGHAR TO KHALILABAD

M/s R.S. TRADERS

← **MAGHAR**

KHALILABAD →

46

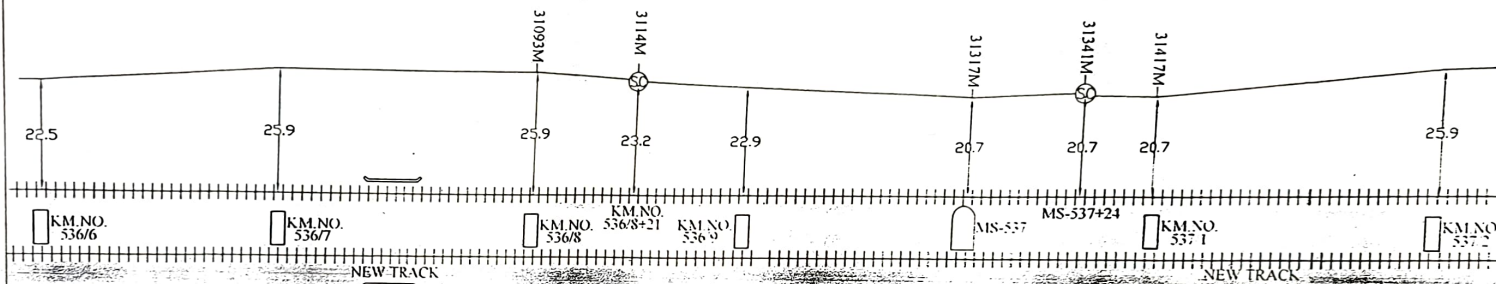

Legends

1.	COUPLER 40mm		9.	6 QUAD NORMAL JOINT	
2.	SPLICE CHAMBER		10.	OFC	
3.	KILOMETER STONE		11.	DUCT	
4.	CULVERT		12.	OPEN TRENCH	
5.	G.I PIPE		13.	BORE	
6.	RCC PIPE		14.	HDD	
7.	GURDER BRIDGE		15.	QUAD CABLE	
8.	SUB MILE STONE		16.	TELE POLE	



RAILTEI

RAILTEL CORPORATION OF INDIA LIMITED

RAILWAY STATION - DOMINGARH TO MUNDERWA

DRAWING TITLE:	CABLE ROUTE PLAN
----------------	------------------

DRAWING NO.:

SHEET No.

PROJECT CODE:

SECTION:


MAGHAR TO KHALILABAD

M/s R.S. TRADERS

46

MAGHAR

KHALILABAD

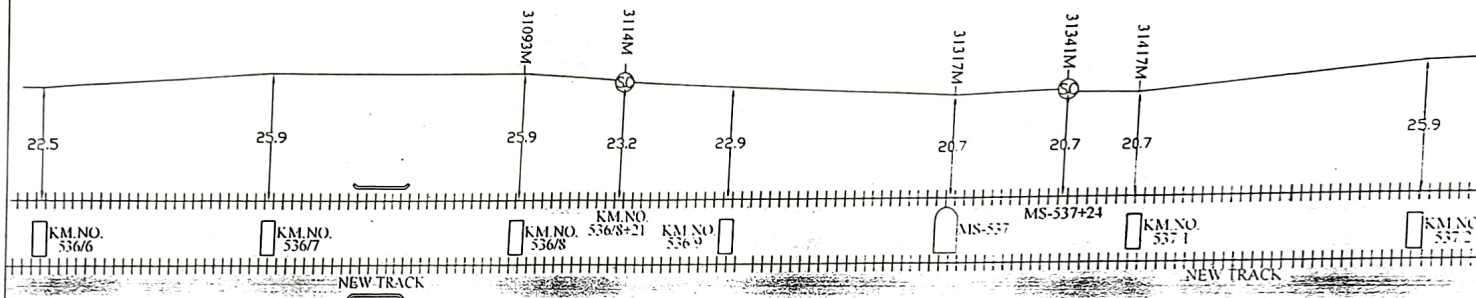

Legends

1.	COUPLER 40mm		9.	6 QUAD NORMAL JOINT	
2.	SPLICE CHAMBER		10.	OFC	
3.	KILOMETER STONE		11.	DUCT	
4.	CULVERT		12.	OPEN TRENCH	
5.	G.I PIPE		13.	BORE	
6.	RCC PIPE		14.	HDD	
7.	GURDER BRIDGE		15.	QUAD CABLE	
8.	SUB MILE STONE		16.	TELE. POLE	



RAILTEL

RAILTEL CORPORATION OF INDIA LIMITED

RAILWAY STATION - DOMINGARH TO MUNDERWA

DRAWING TITLE: CABLE ROUTE PLAN

DRAWING NO.:

SHEET No.

PROJECT CODE:

SECTION:

MAGHAR TO KHALILABAD


M/s R.S. TRADERS

MAGHAR

KHALILABAD

47

LC No.178C
KM.NO.-536/3-536/4

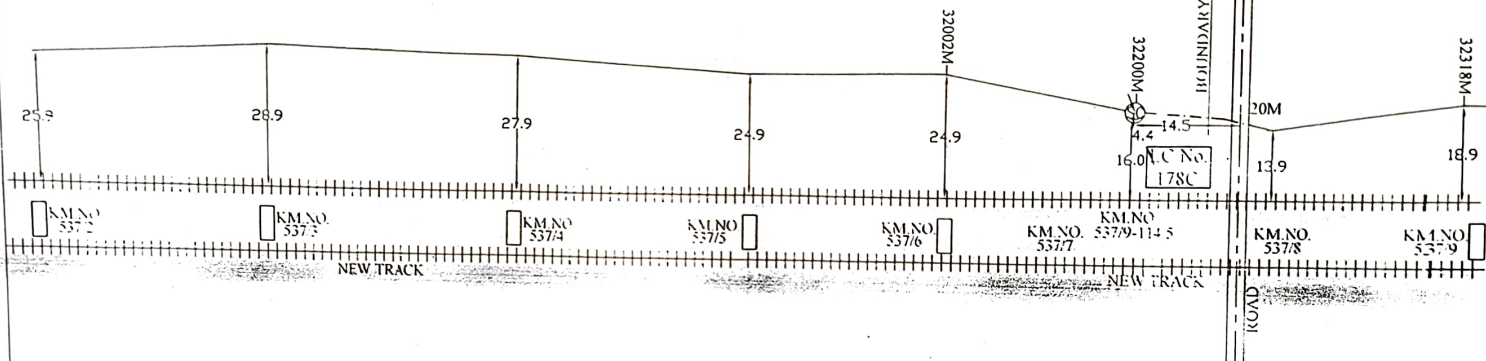

Legends

1. COUPLER 4mm		9. 6 QUAD NORMAL JOINT	
2. SPLICE CHAMBER		10. OFC	
3. KILOMETER STONE		11. DUCT	
4. CULVERT		12. OPEN TRENCH	
5. GI PIPE		13. BORE	
6. RCC PIPE		14. HDD	
7. GUARDER BRIDGE		15. QUAD CABLE	
8. SUBMILESTONE		16. TELE POLE	



RAI LTEL

RAILTEL CORPORATION OF INDIA LIMITED

RAILWAY STATION - DOMINGARH TO MUNDERWA

DRAWING TITLE: CABLE ROUTE PLAN

DRAWING NO.:

SHEET No.

PROJECT CODE:

SECTION:


MAGHAR TO KHALILABAD

M/s R.S. TRADERS

MAGHAR

KHALILABAD

48

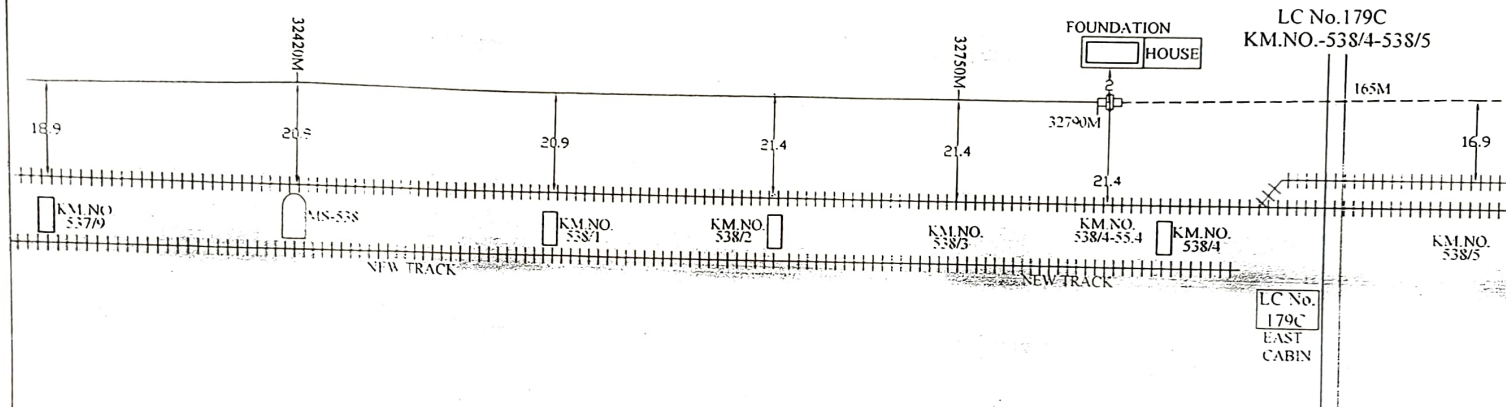

Legends

1. COUPLER 40mm		9. 6 QUAD NORMAL JOINT	
2. SPLICE CHAMBER		10. OFC	
3. KILOMETER STONE		11. DUCT	
4. CULVERT		12. OPEN TRENCH	
5. GI PIPE		13. BORE	
6. RCC PIPE		14. HDD	
7. GIRDER BRIDGE		15. QUAD CABLE	
8. SUB MILESTONE		16. TELE POLE	



RAI TEL

RAILTEL CORPORATION OF INDIA LIMITED

RAILWAY STATION - DOMINGARH TO MUNDERWA

DRAWING TITLE: CABLE ROUTE PLAN

DRAWING NO.:

SHEET No.

PROJECT CODE:

SECTION:

MAGHAR TO KHALILABAD

M/s R.S. TRADERS