

FINAL ROUTE PLAN FOR 6 QUAD CABLE
GORAKHPUR - VALMIKI NAGAR SECTION
ON
N.E. RAILWAY

PREPARED BY
M/S ANUP KUMAR ,
DURGABARI ROAD, GORAKHPUR


ROUTE PLAN FOR GORAKHPUR - GORAKHPUR CANTT - UNAULA SECTION (6 QUAD CABLE)

← GKP

NKE →

Bridge no. 176
Width 3X12.20m.
Km. 501/11-12

LC No. 157/A
Km. 501/2-3

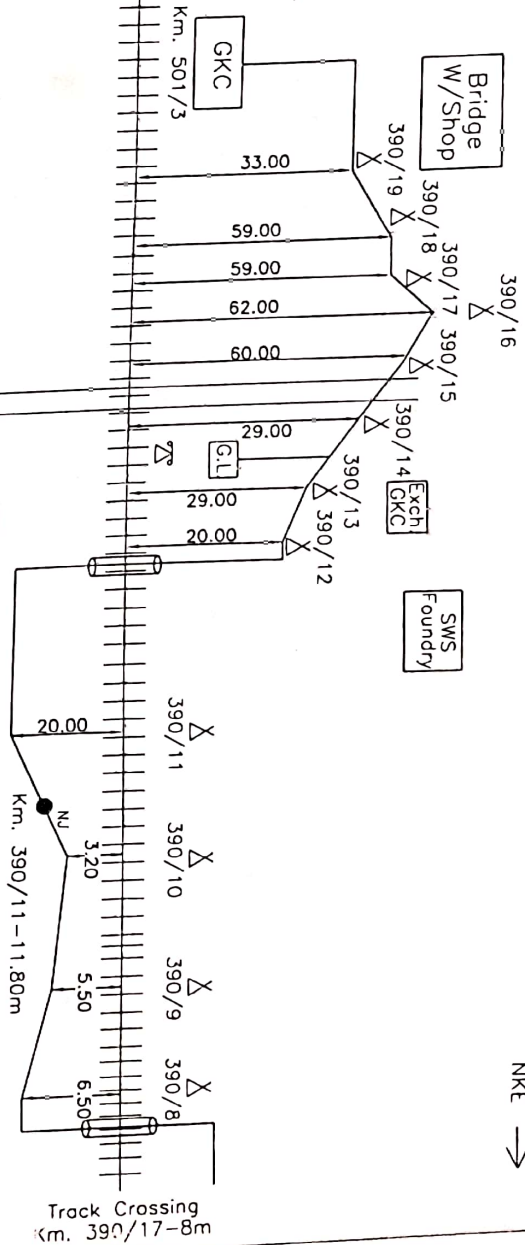

503/3

501/2

CPR →

CONTRACTOR

SE/TELE/CON/GKP

ADSTE/CON/EAST/GKP


DY. ESTE/CON/EAST/GKP

Not to Scale
All reading in m/s

1-JOINT MARKER	0 DU	DUCT JOINT MARKER	2	L.C. GATE PHONE	1 DU	DERIVATION JOINT	SHEET NO. 01	CREATED BY AK	Location - GORAKHPUR - PANIYAHWA
RAILWAY CROSSING	1H	RAILWAY TRACK		POLE	3	EMERGENCY POST	CREATED ON	OFFERED BY AK	
BRIDGE/CULVERT	0	G.I. PIPE		RAILWAY OVER BRIDGE	NU	NORMAL JOINT	REVISION NO	APPR. BY MEPLY	
DUCT PIPE	WOPF	RAILWAY UNDER BRIDGE		6 QUAD CABLE		MODIFIED ON			

N. E. RAILWAY
M/S ANUP KUMAR, DURGAHARI ROAD, NEAR PAKKI BACH GATE, GORAKHPUR

ROUTE PLAN FOR GORAKHPUR CANTT - UNAULA SECTION (6 QUAD CABLE)

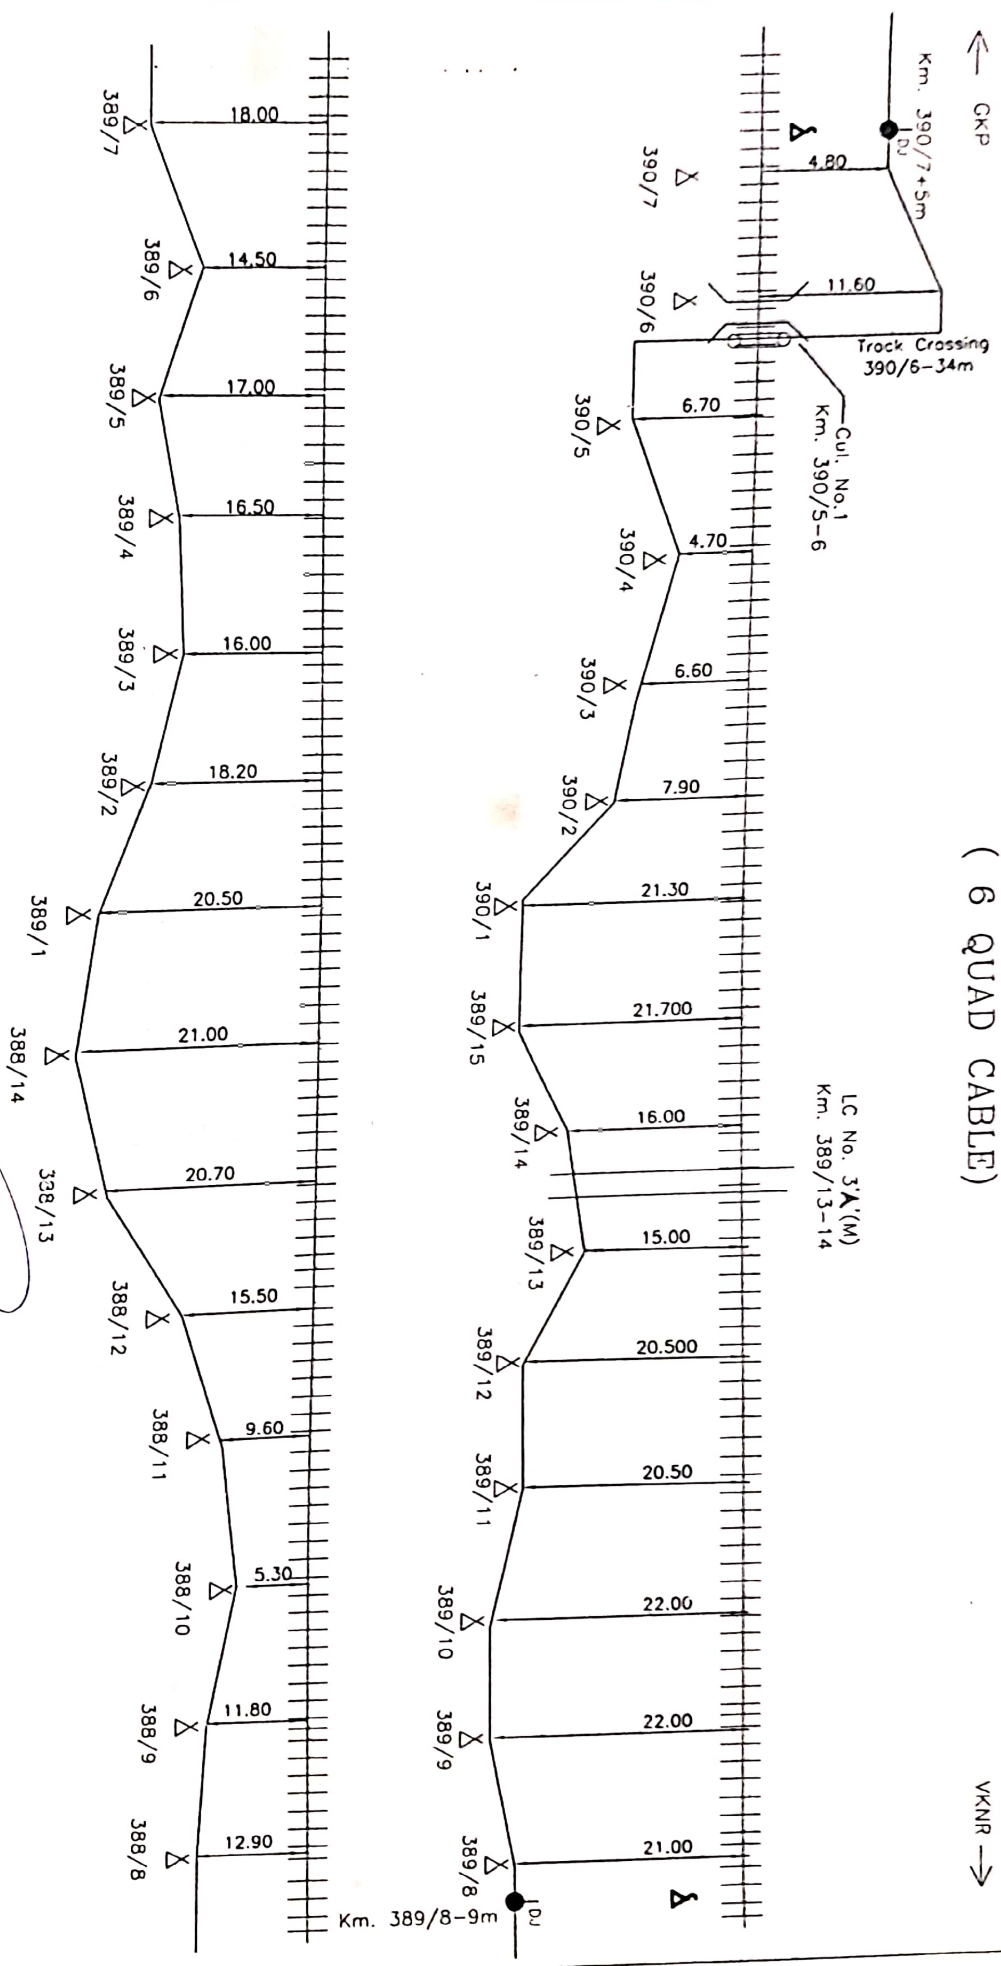

Anup Kumar
CONTRACTOR

Seetha
SE/TELE/CON/GKP

ADSTE/CON/EAST/GKP

ADSTE/CON/EAST/GKP

T-JOINT MARKER	DU	DUCT JOINT MARKER	L.C. GATE PHONE	DERIVATION JOINT	SHEET NO.	02	CREATED BY	AK	Location : -- GORAKHPUR - PANIVAHWA
RAILWAY CROSSING	HH	RAILWAY TRACK	POLE	EMERGENCY POST	CREATED ON		OFFERED BY	AK	
BRIDGE/CULVERT	OO	G.I. PIPE	RAILWAY OVER BRIDGE	NORMAL JOINT	REVISION NO		APPR BY	NE RLY	
DUCT PIPE	CCCC	HDPE	RAILWAY UNDER BRIDGE	6 QUAD CABLE	MODIFIED ON		Ref no - NE/		

Customer Name	N. E. RAILWAY
Prepared By :	M/S ANUP KUMAR, DURGABARI ROAD, NEAR PAKKI BACH GATE, GORAKHPUR


ROUTE PLAN FOR GORAKHPUR CANTT - UNAULA SECTION (6 QUAD CABLE)

OKP →

VKR →

LC No. 1A/C(U/M)
Km. 386/8-7

LC No. 2C(U/M)
Km. 387/11-12

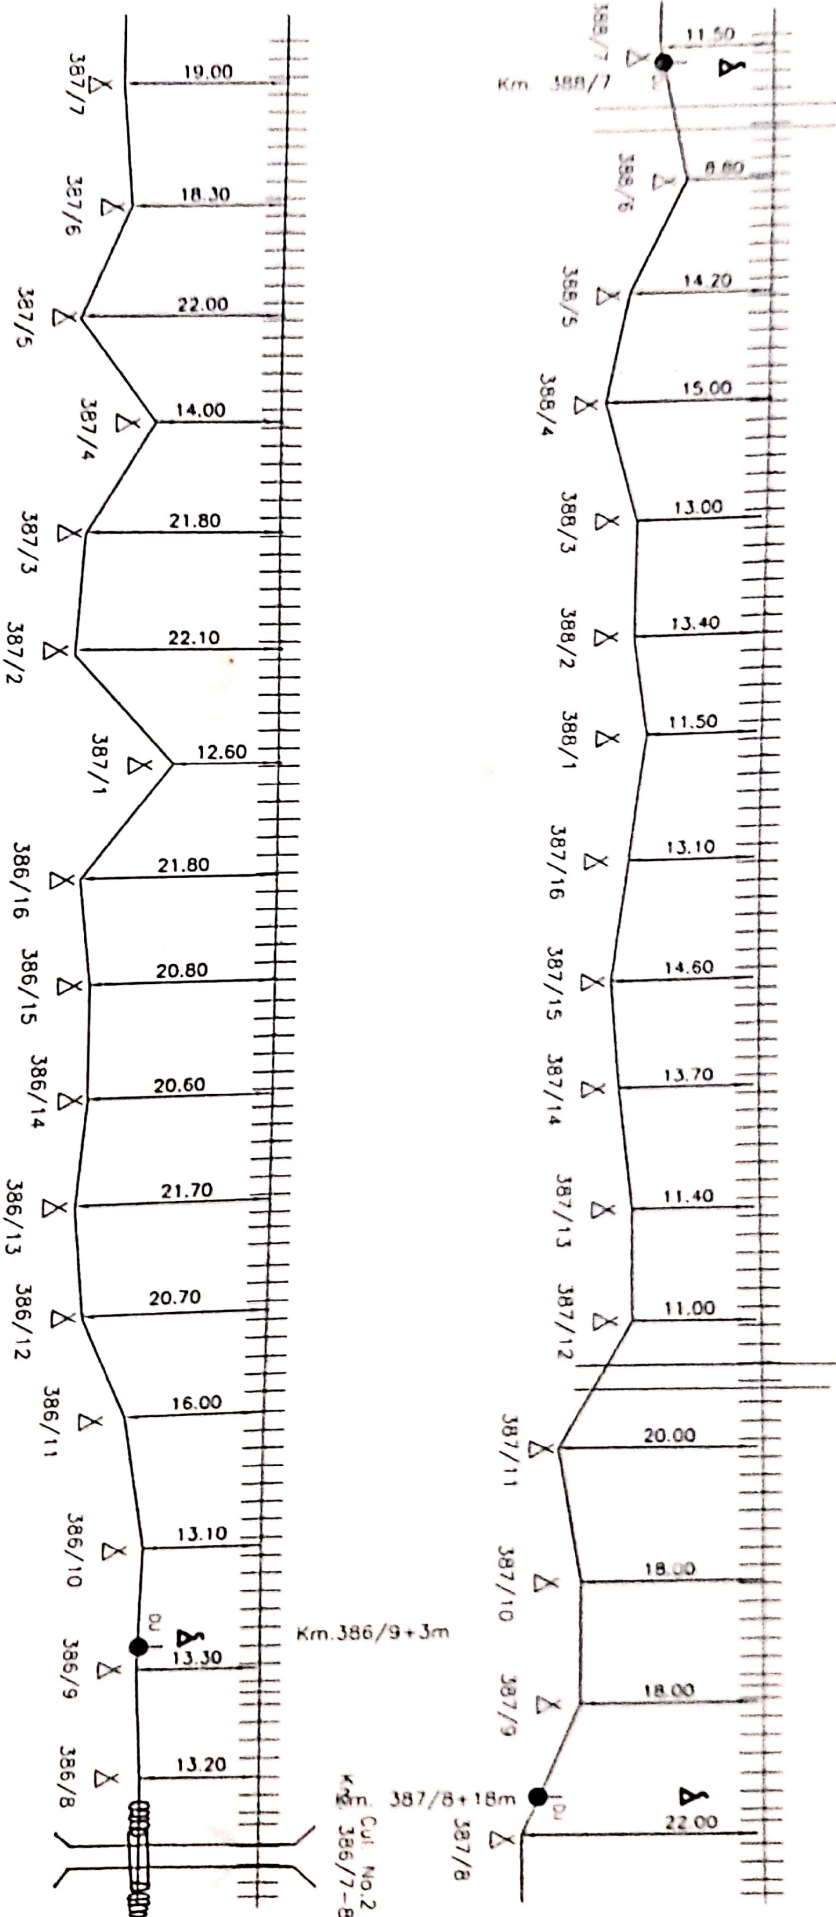

CONTRACTOR
Anup Kumar

SE/TELE/CON/CKP
Subash
KDS/TE/CON/EAST/CKP

DY. CHIEF/CON/EAST/CKP
18/09/13



1. T-JOINT WARE	0 DU	DUCT JOINT WARE	2. L.C. GATE PHONE	3. DERIVATION JOINT	Customer Name	N. E. RAILWAY
RAILWAY CROSSING	HH	RAILWAY TRACY	POLE	EMERGENCY POST	Prepared By	M/S ANUP KUMAR, DURGABARI ROAD, NEAR PAKKI BAGH GATE, GORAKHPUR
BRIDGE/CULVERT	CD	GI PIPE	RAILWAY OVER BRIDGE	NORMAL JOINT	SHEET NO.	03
DUCT PIPE	CC	MOPE	RAILWAY UNDER BRIDGE	6 QUAD CABLE	CREATED ON	CREATED BY
					REVISION NO.	OFFERED BY
					MODIFIED ON	APPROVED BY
						N.E.R.
						Location :- GORAKHPUR - PANIYAHWA

Not to Scale
All reading in mts

← GKP

ROUTE PLAN FOR GORAKHPUR CANTT - UNAULA SECTION (6 QUAD CABLE)


VKNR →

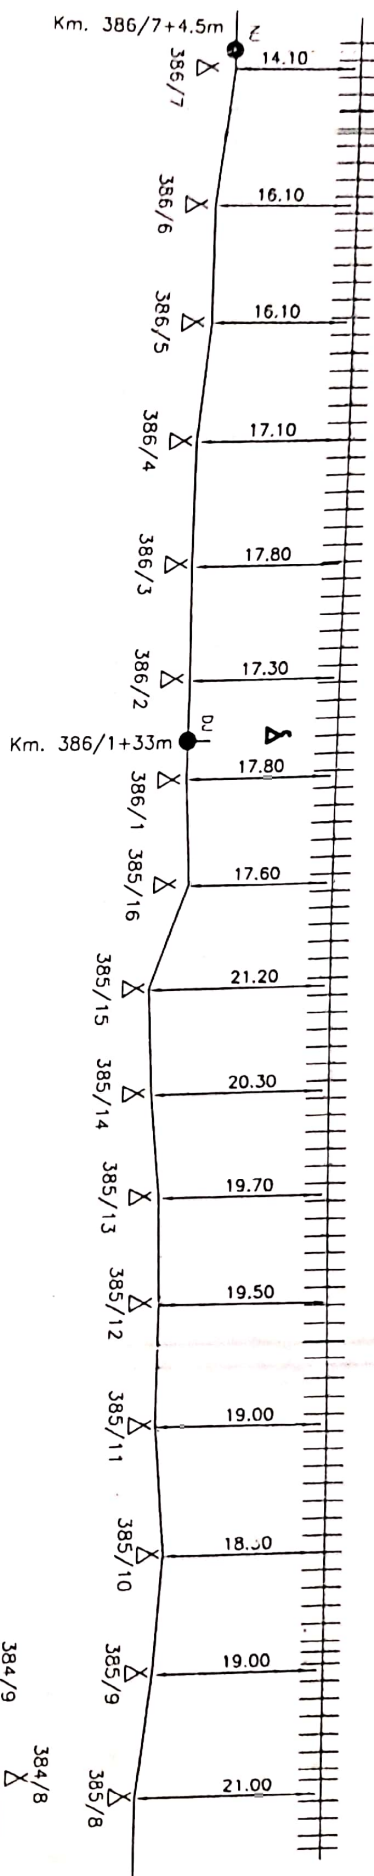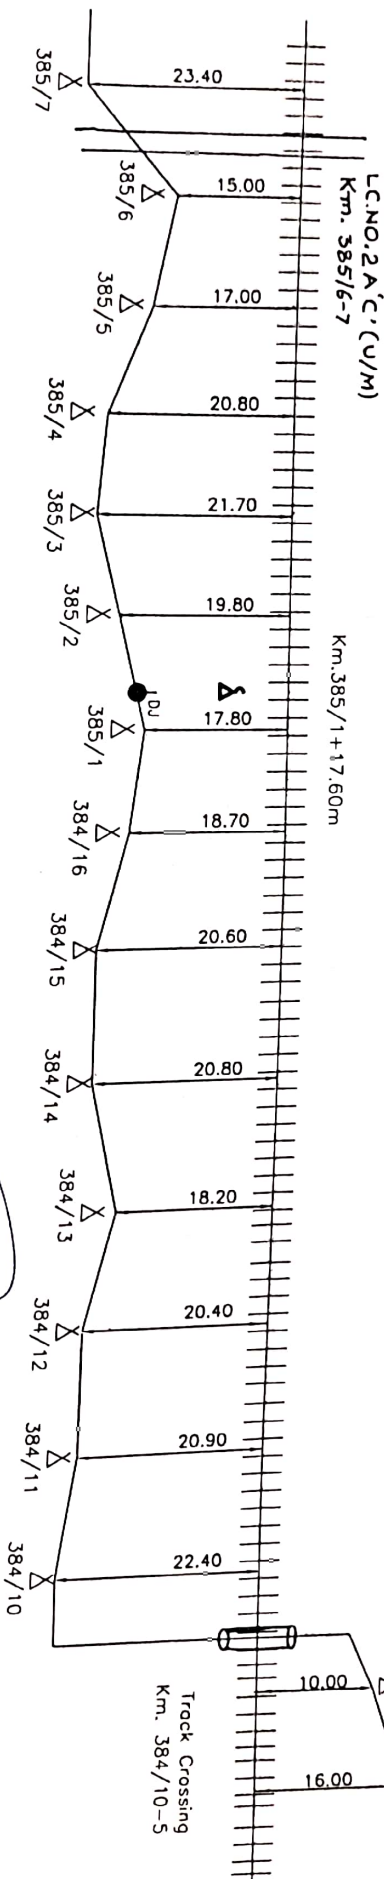

CONTRACTOR		SE/TELE/CDN/GKP		ADSTE/CON/EAST/GKP		DY.CSTE/CON/EAST/GKP	
Customer Name		N. E. RAILWAY					
Prepared By :		W/S ANUP KUMAR, DURGABARI ROAD, NEAR PAKKI BAGH GATE, GORAKHPUR					
SHEET NO.		04		CREATED BY		AK	
CREATED ON				OFFERED BY		AK	
REVISION NO.				APPR BY		N E RLY	
MODIFIED ON				Ref no - NE/			
Location :-		GORAKHPUR - PANIYAHWA					

Not to Scale
All reading in mts

ROUTE PLAN FOR GORAKHPUR CANTT - UNAULA - PIPRAICH SECTION (6 QUAD CABLE)

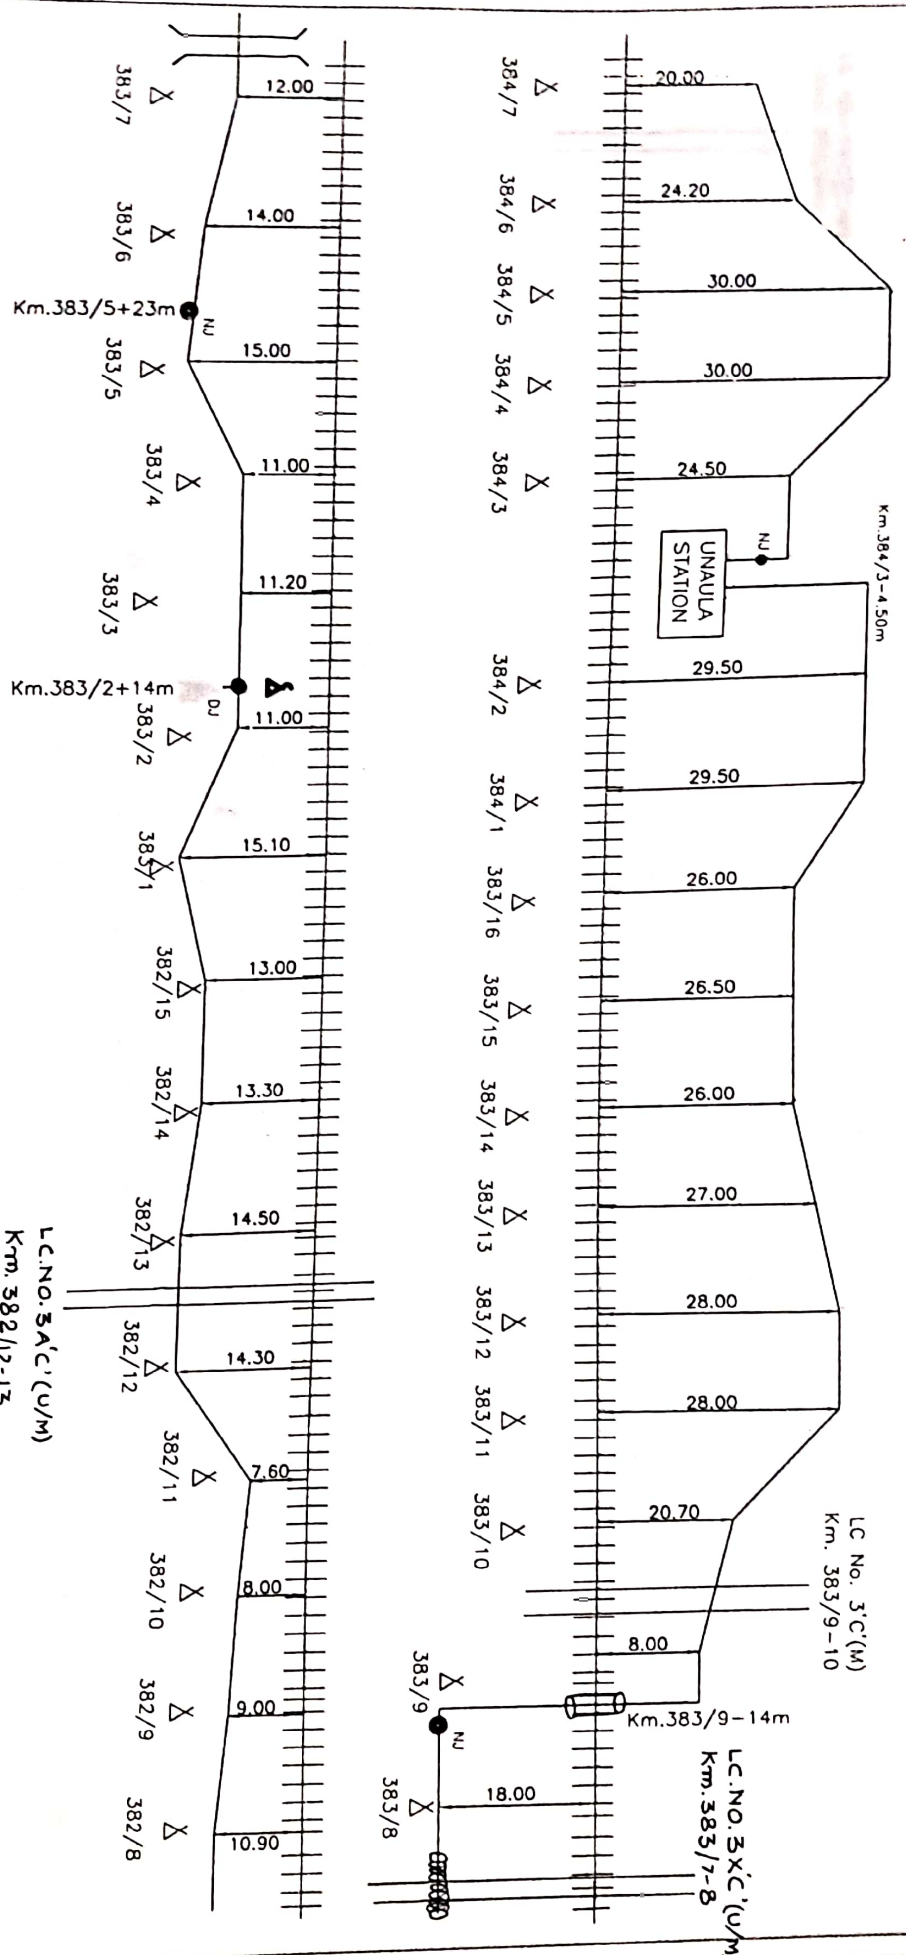

LC NO. 3A'C'(U/M)
Km. 382/12-13

CONTRACTOR
Amphur

SE/TELE/CON/GKP
Sebag

ADSTE/CON/EAST/GKP
13/11/13

DCSTE/CON/EAST/GKP
18/11/13

Customer Name		N. E. RAILWAY	
Prepared By :		M/S ANUP KUMAR, DURGAHARI ROAD NEAR PAKKI BACH GATE, GORAKHPUR	
SHEET NO. 05		CREATED BY AK	
CREATED ON		OFFERED BY AK	
REVISION NO.		APPR BY ME RLY	
MODIFIED ON		DATE - ME/	
Location :-		GORAKHPUR - PANIHAWA	

Not to Scale
All reading in mts


← GKP

ROUTE PLAN FOR UNAULA - PIPRAICH SECTION (6 QUAD CABLE)


→ VKNR

Cd. No. 5
Km. 382/5-6

LC No. 4A(C/U/M)
Km. 381/9-10

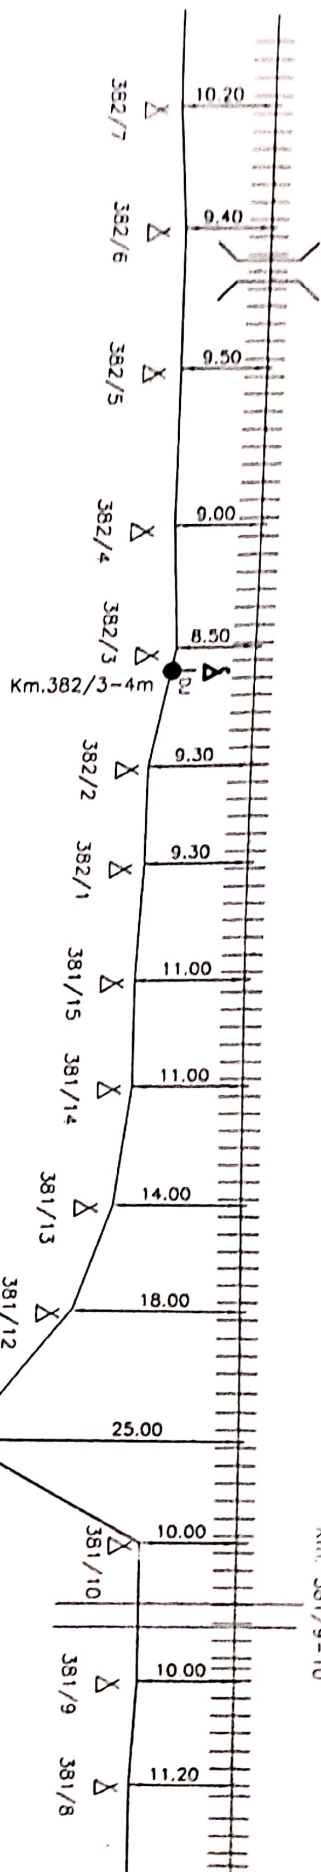

LC No. 4A(C/U/M)
Km. 380/9-10

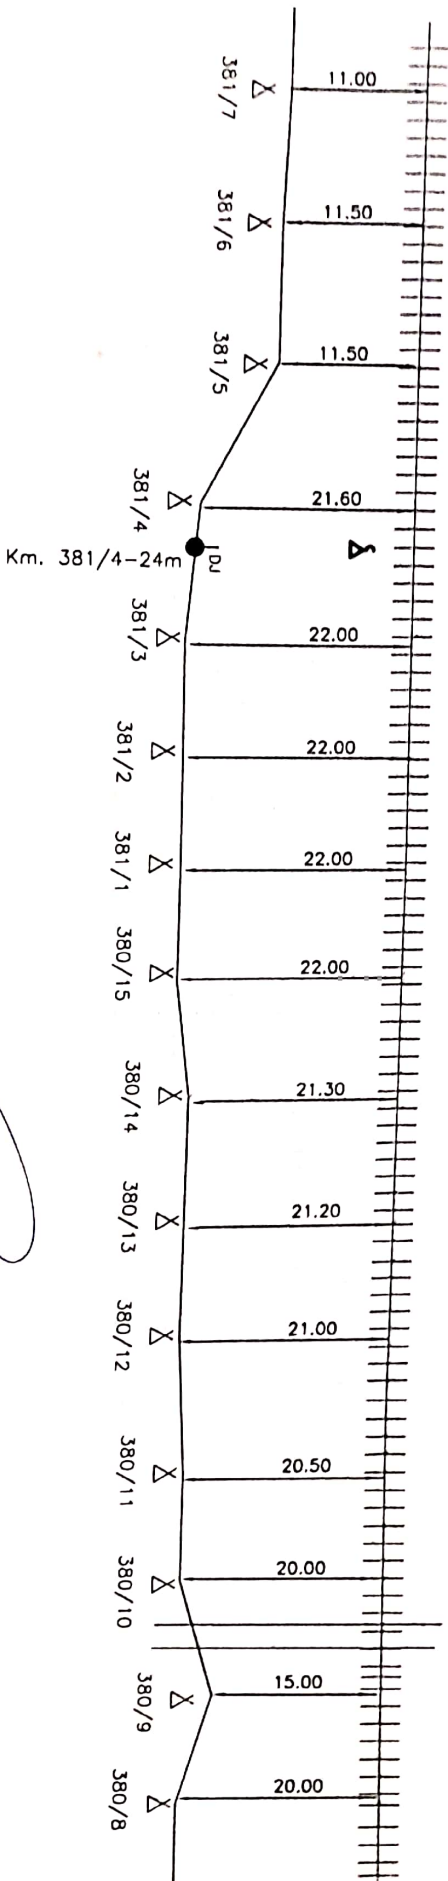

CONTRACTOR

SE/TELE/CON/GKP

ADSTE/CON/EAST/GKP

DY. CSTE/CON/EAST/GKP

Customer Name
Prepared By :
SHEET NO. 06
CREATED ON
OFFERED BY
APPR BY
N E RLY
N. E. RAILWAY
GORAKHPUR
PANIVAHWA


Not to Scale
All reading in mts

1-JOINT MARKER	DU	DUCT JOINT MARKER	DU	LC. GATE PHONE	DU	DERIVATION JOINT	DU	SHEET NO.	06	CREATED BY	AK	Location :-
RAILWAY CROSSING	III	RAILWAY TRACK	X	POLE	X	EMERGENCY POST	Δ	CREATED ON		OFFERED BY	AK	GORAKHPUR.
BRIDGE/CULVERT	III	G.I. PIPE	X	RAILWAY OVER BRIDGE	Δ	NORMAL JOINT	Δ	RMSION NO.		APPR BY	N E RLY	PANIVAHWA
DUCT PIPE	III	HOPE	X	RAILWAY UNDER BRIDGE	Δ	6 QUAD CABLE	Δ	MODIFIED ON		Ref'd - NE/		

ROUTE PLAN FOR UNAULA - PIPRAICH SECTION (6 QUAD CABLE)

← CKP

VRIR →

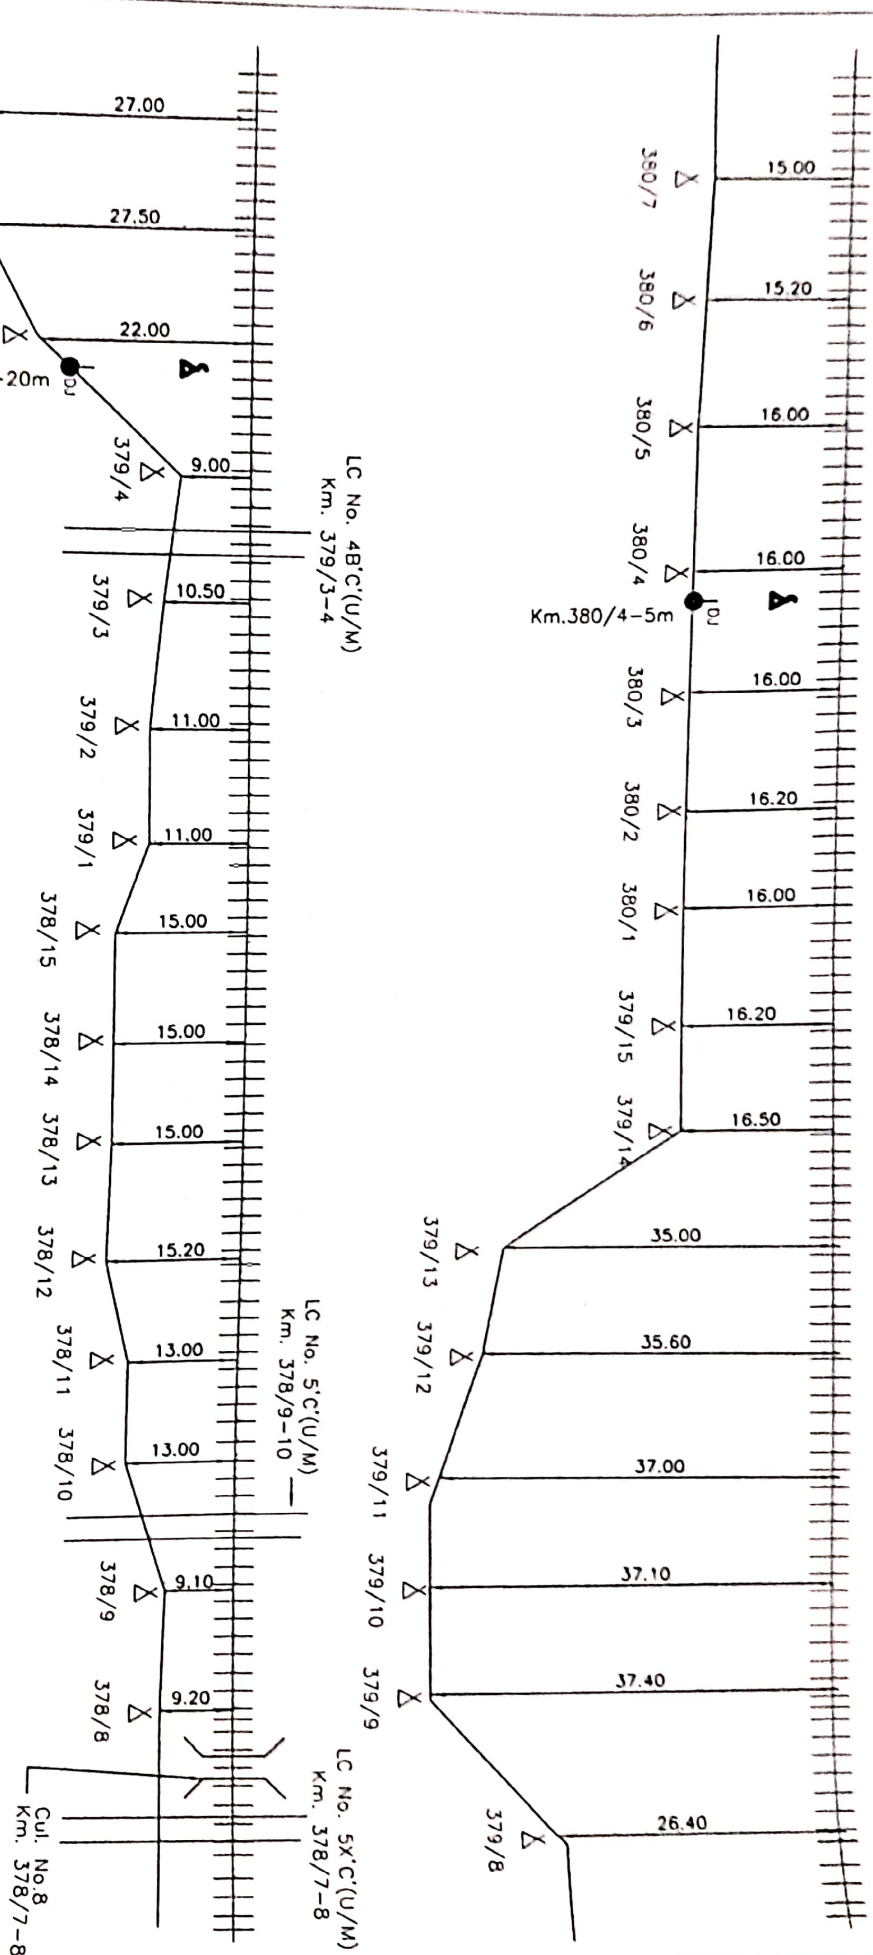

CONTRACTOR
Rup Kumar

SE/TELE/CON/GKP
Sebipta
13/7/13

ADSTE/CON/EAST/GKP

DY.CSTE/CON/EAST/GKP
10/07/13

1-JOINT MARKER	DU	DUCT JOINT MARKER	LC. GATE PHONE
RAILWAY CROSSING	TH	RAILWAY TRACK	POLE
BRIDGE/CULVERT	CD	C.I. PIPE	RAILWAY OVER BRIDGE
DUCT PIPE	WDPE	RAILWAY UNDER BRIDGE	

DERIVATION JOINT	DU
EMERGENCY POST	Δ
NORMAL JOINT	●
6 QUAD CABLE	—

Customer Name	N. E. RAILWAY			
Prepared By :	W/S ANUP KUMAR, DURGABARI ROAD, NEAR PAKKI BAGH GATE, GORAKHPUR			
SHEET NO.	07	CREATED BY	AK	Location : GORAKHPUR - PANITYAHWVA
CREATED ON		OFFERED BY	AK	
REVISION NO		APPR BY	ME RLY	
MODIFIED ON		Ref no - NE/		



Not to Scale
All reading in mts



← GKP

(6 QUAD CABLE)

VKNR →

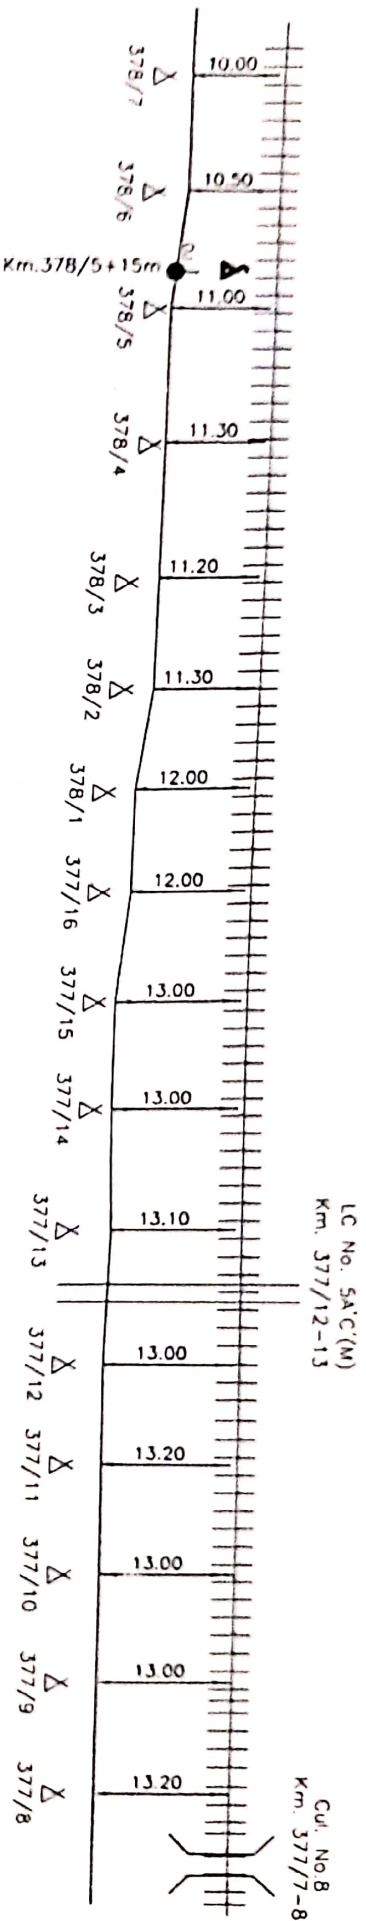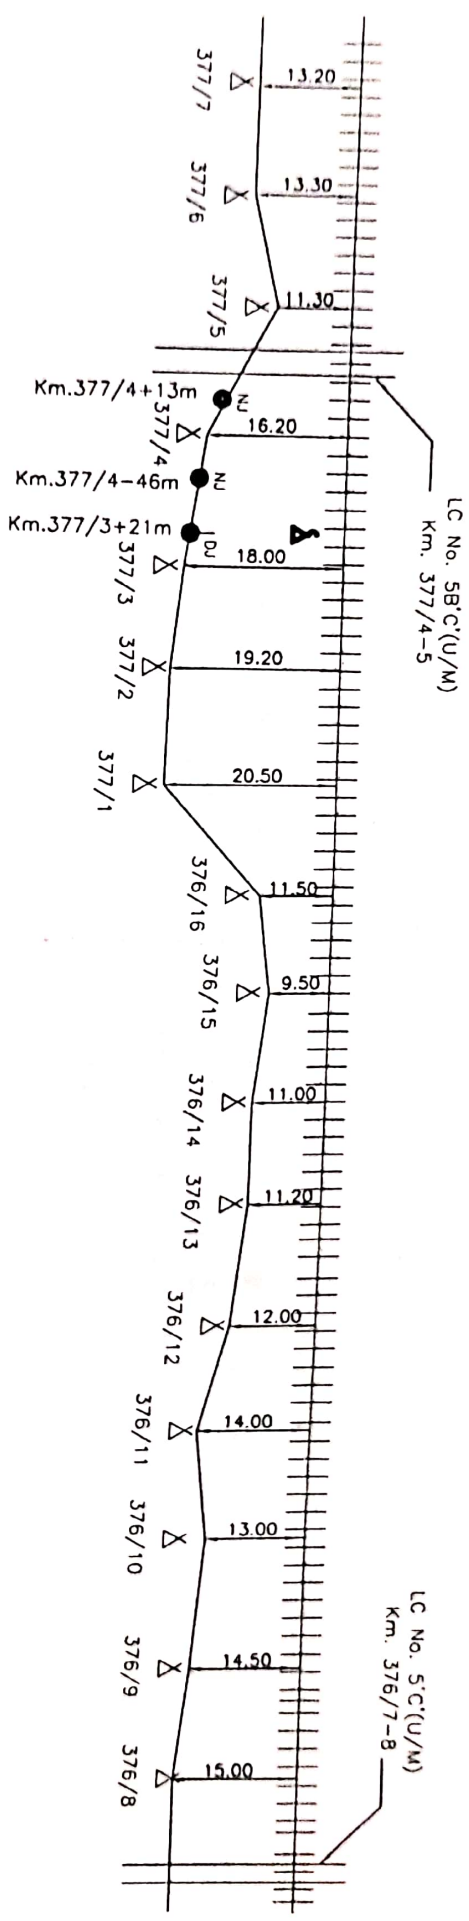

CONTRACTOR

SE/TELE/CON/GKP

ADDTE/CON/EAST/GKP

DY.CSTE/CON/EAST/GKP

N. E. RAILWAY

Location :- GORAKHPUR - PANIYAHWA


1-JOINT MARKER	0 DU	DUCT JOINT MARKER	DU	L.C. GATE PHONE	DU	DERIVATION JOINT	DU	EMERGENCY POST	DU	REVISION NO	APPR BY	NEELY	Location :- GORAKHPUR - PANIYAHWA
RAILWAY CROSSING	4H	RAILWAY TRACK		POLE						CREATED ON	OFFERED BY	AK	
BRIDGE/CULVERT		C.I. PIPE		RAILWAY OVER BRIDGE						REVISION NO	APPR BY	NEELY	
DUCT PIPE		HOPE		RAILWAY UNDER BRIDGE						CREATED ON	OFFERED BY	AK	

Not to Scale
All reading in mts

ROUTE PLAN FOR UNAULA - PIPRAICH - BODARWAR SECTION (6 QUAD CABLE)

← GKP

VKNR →

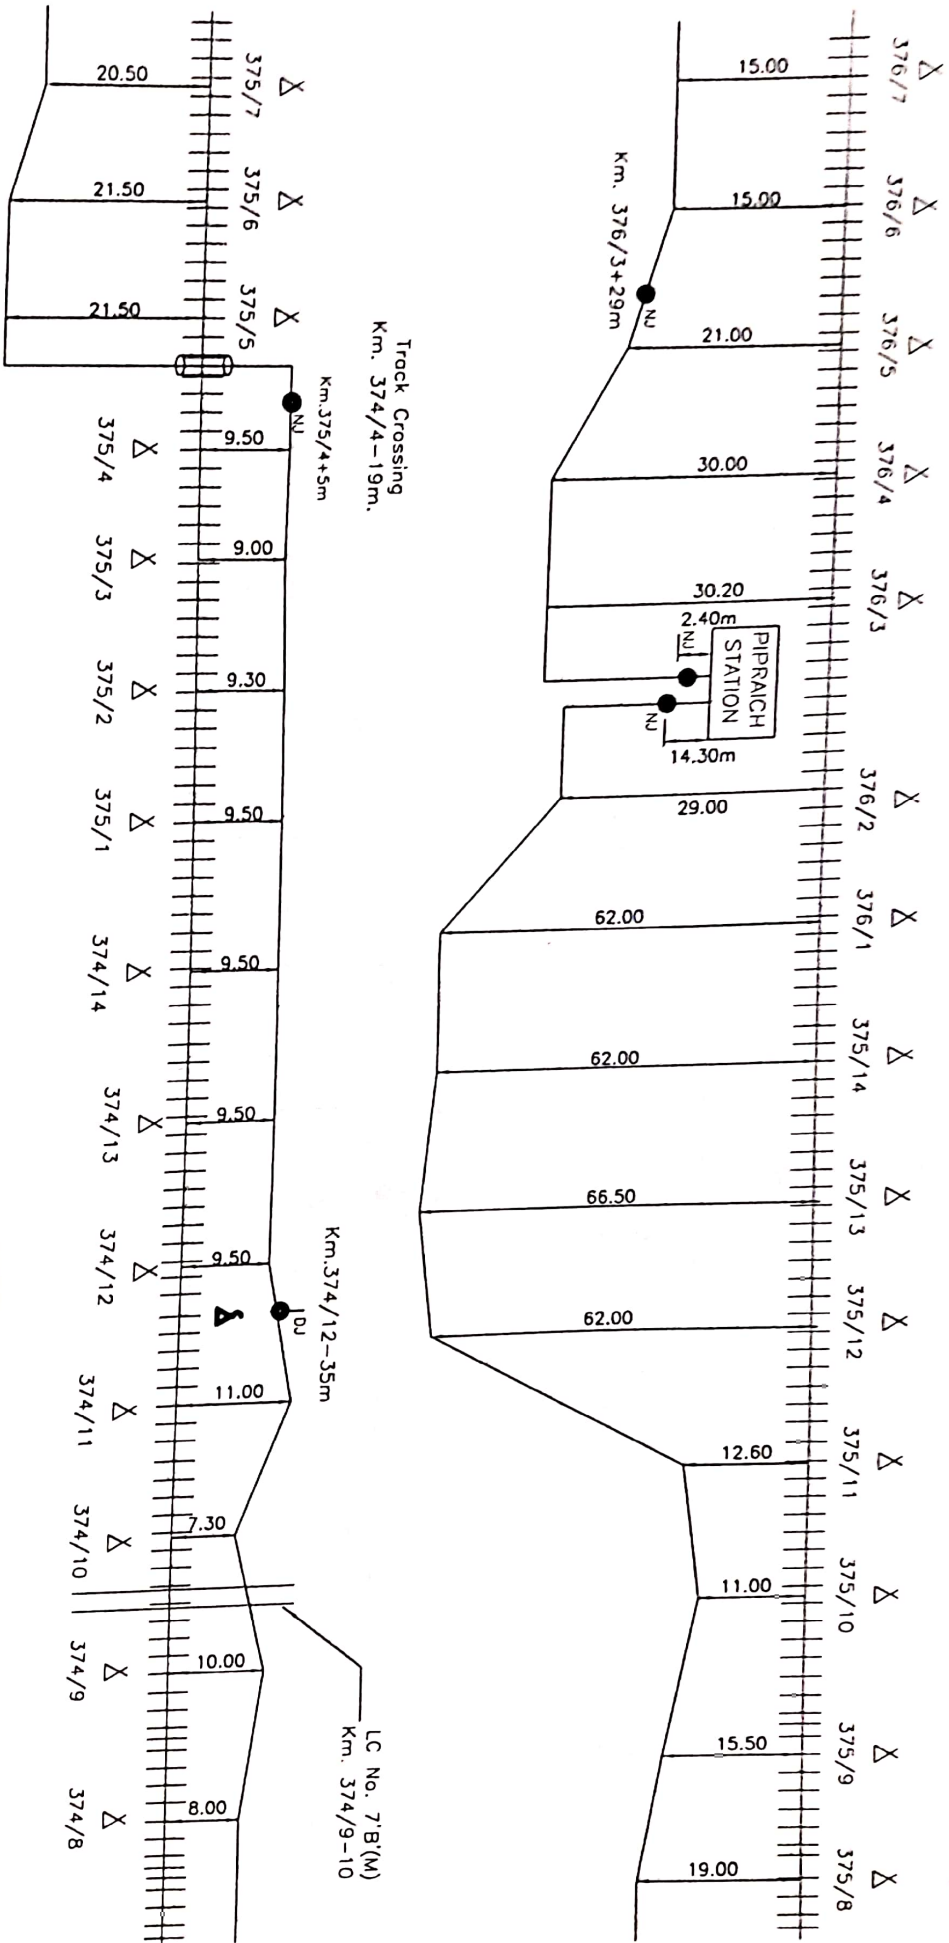

Truck Crossing
Km. 374/4-19m.

Km. 375/4+5m

Km. 374/12-35m

LC No. 7'B(M)
Km. 374/9-10

ANUP KUMAR
CONTRACTOR

SE/TELE/CON/GKP
13/3/13

ADST/CON/EAST/GKP
22/7/17

DY.CSTE/CON/EAST/GKP
18/9/13



Not to Scale
All reading in mts

1. JOINT MARKER	0 DU	DUCT JOINT MARKER	0 DU	L.C. GATE PHONE	0 DU	DERIVATION JOINT	0 DU	SHEET NO.	09	CREATED BY	AK	OFFERED BY	AK	APPR BY	N.E. RAILWAY	Location : - - GORAKHPUR - PANIYAHWA
RAILWAY CROSSING	11	RAILWAY TRACK	11	POLE	11	EMERGENCY POST	11	CREATED CN								
BRIDGE/CULVERT	11	G.I. PIPE	11	RAILWAY OVER BRIDGE	11	NORMAL JOINT	11	RIVISON NO								
DUCT PIPE	11	HOPE	11	RAILWAY UNDER BRIDGE	11	5 QUAD CABLE	11	MODIFIED ON								

← GKP

VKNR →

ROUTE PLAN FOR PIPRACH - BODARWAR SECTION (6 QUAD CABLE)

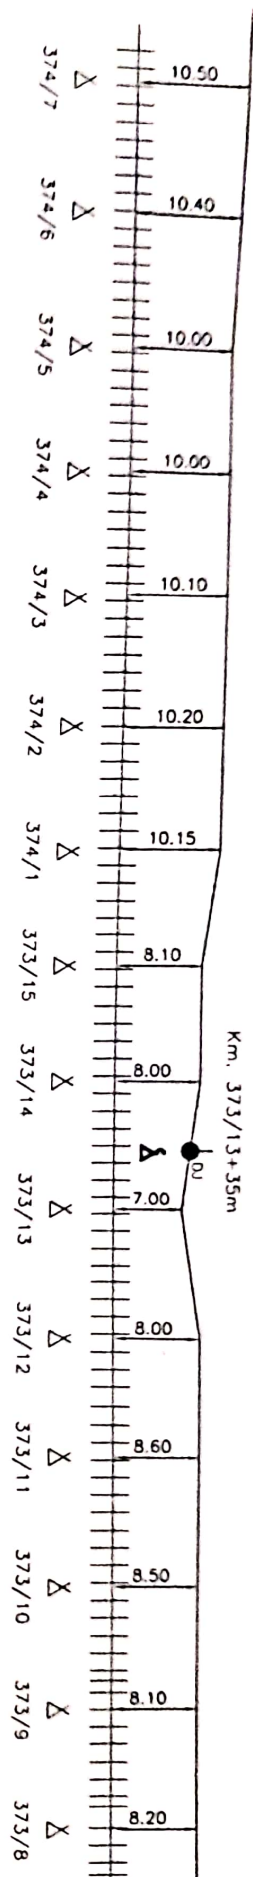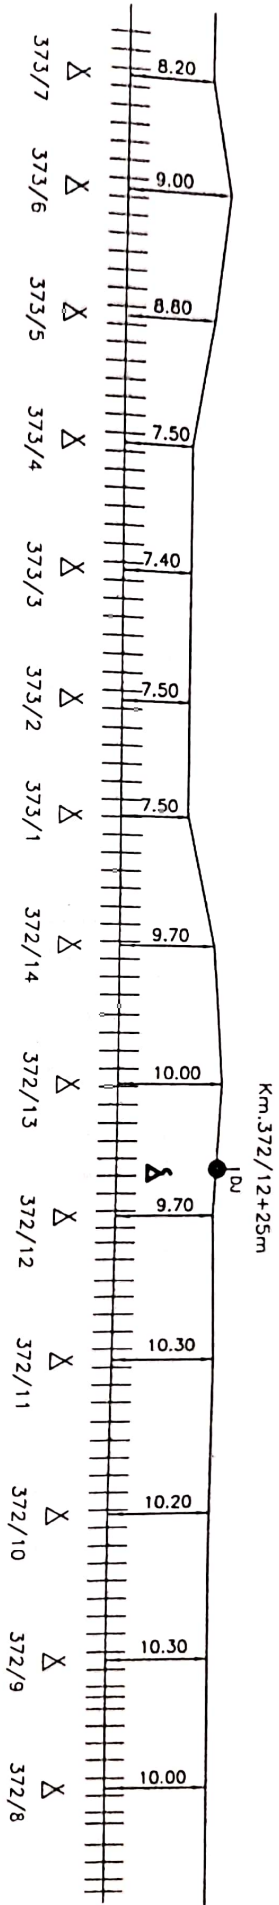

Contractor *Sh. B. Kumar*

SE/TELE/CON/GKP *13/9/13*

ADSITE/CON/EAST/GKP

DY.CSTE/CON/EAST/GKP

15/9/13

Not to Scale
All reading in mts

1-JOINT MARKER	DU	DUCT JOINT MARKER	DU	L.C. GATE PHONE	DU	DERIVATION JOINT	DU	EMERGENCY POST	DU	NORMAL JOINT	DU	6 QUAD CABLE	DU


Customer Name	N. E. RAILWAY
Prepared By :	M/S ANUP KUMAR, DURGADEVI ROAD, NEAR PAKKI BAGH GATE, GORAKHPUR
SHEET NO.	10
CREATED ON	CREATED BY AK
REVISION NO.	OFFERED BY AK
MODIFIED ON	APPR. BY N.E. RLY
Per no - NE/	

Location :-
GORAKHPUR -
PANITYAHWA

ROUTE PLAN FOR PIPRAICH - BODARWAR SECTION (6 QUAD CABLE)

← GKP

VKNR →

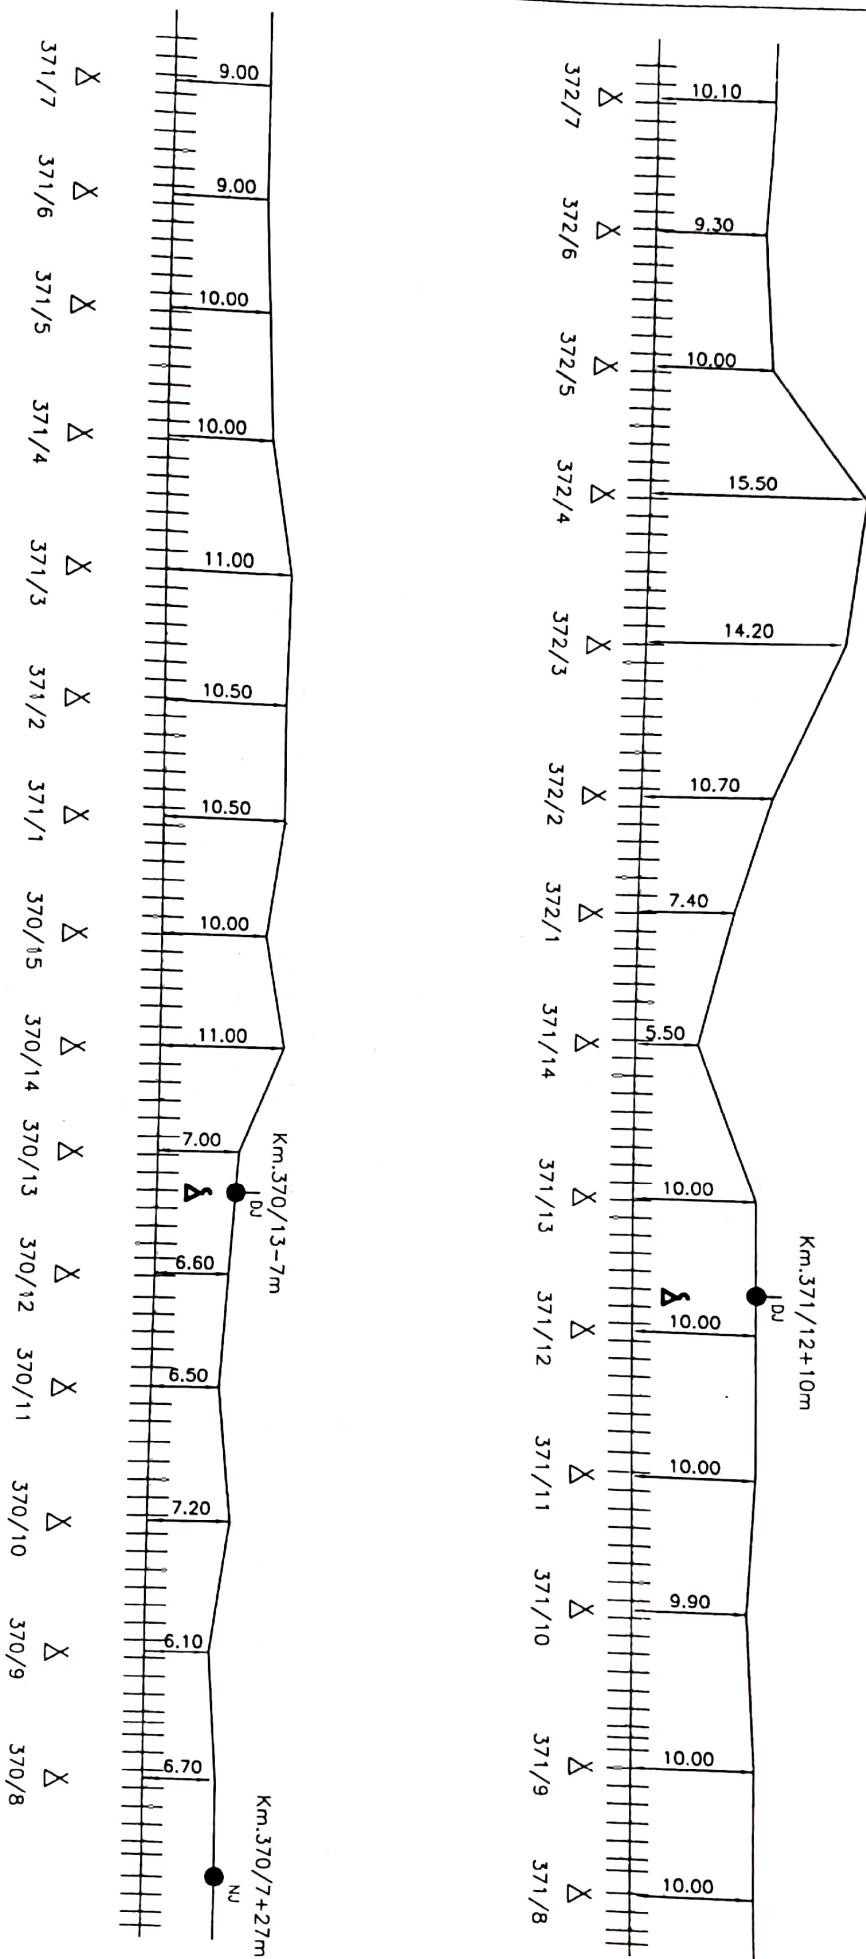

CONTRACTOR <i>Anup Kumar</i>		SE/TELE/CON/GKP <i>12/2/13</i>		ADSTE/CON/EAST/GKP <i>17/7/13</i>		DY.CSTE/CON/EAST/dkp <i>18/8/13</i>	
1-JOINT MARKER	0 DU	DUCT JOINT MARKER	2	L.C. GATE PHONE	10	DERIVATION JOINT	10
RAILWAY CROSSING	11	RAILWAY TRACK	1	POLE	1	EMERGENCY POST	1
BRIDGE/CUIVERT	0	G.I. PIPE	1	RAILWAY OVER BRIDGE	1	NORMAL JOINT	1
DUCT PIPE	0	HDPE	1	RAILWAY UNDER BRIDGE	1	6 QUAD CABLE	1

Customer Name	N. E. RAILWAY	
Prepared By :	M/S ANUP KUMAR, DURGABARI ROAD NEAR PAKKI BAGH CATE. GORAKHPUR	
SHEET NO.	11	CREATED BY
CREATED ON		OFFERED BY
REVISION NO.		APPR. BY
MODIFIED ON		NE/RY
Ref no - NE/		

Location : - -
GORAKHPUR - PANIYAHWA


Not to Scale
All reading in mts

← G.S.

(6 QUAD CABLE)

VKNR →

ROUTE PLAN FOR PIPRAICH - BODARWAR SECTION

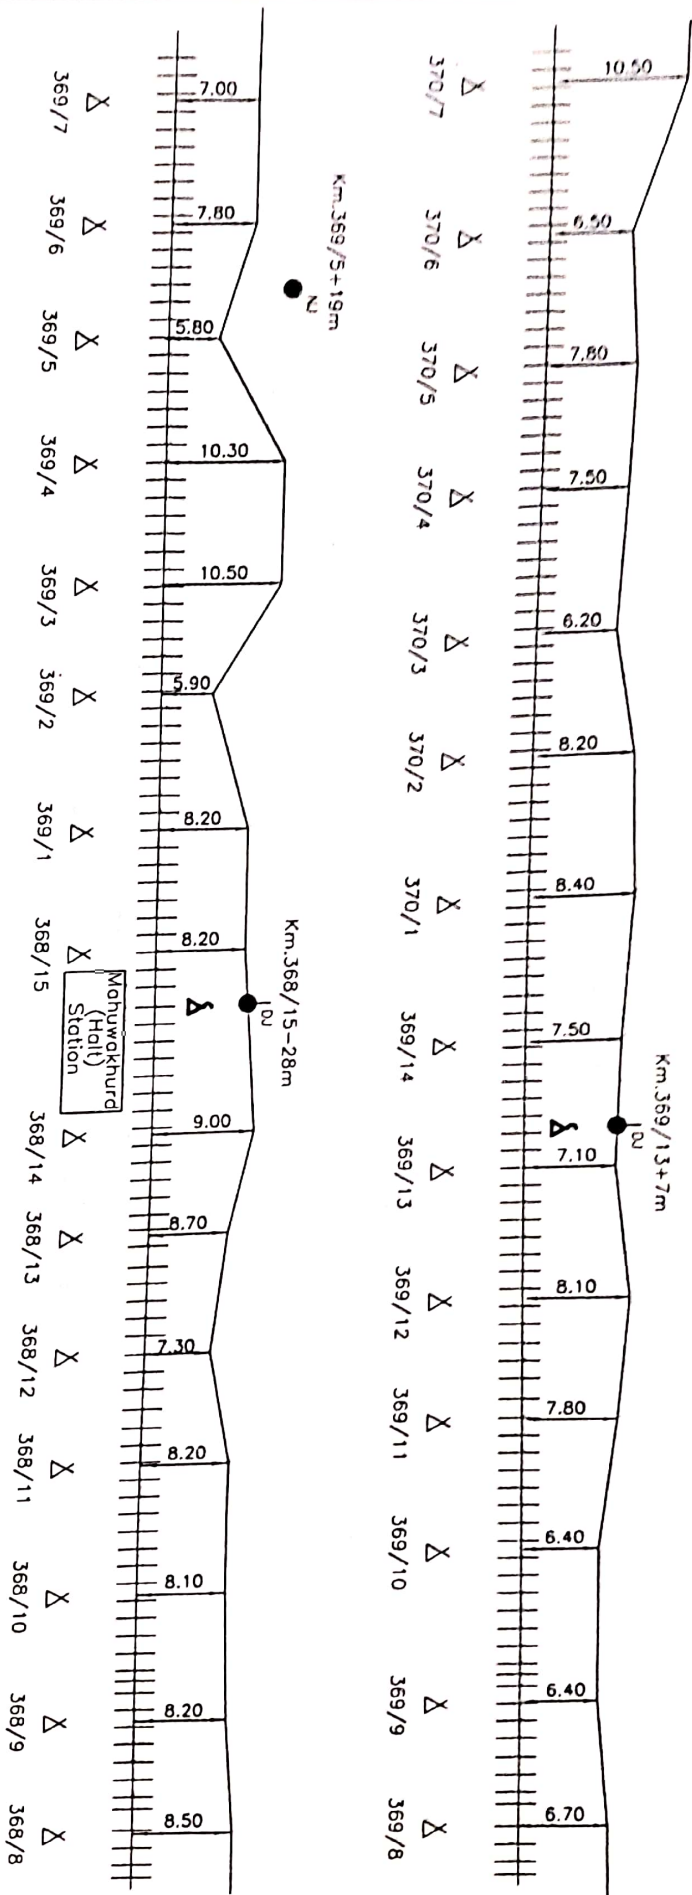

Amrith Kumar

Se Bapen

12/3/13

12/3/13


Not to Scale
All reading in m/s

1	T-JOINT MARKER	0	DUCT JOINT MARKER	1	L.C. GATE PHONE	1	DERIVATION JOINT	12	CREATED BY	AK	Location :-
2	RAILWAY CROSSING	1	RAILWAY TRACK	2	POLE	2	EMERGENCY POST	12	CREATED ON	AK	GORAKHPUR -
3	BRIDGE/CULVERT	1	G.I. PIPE	3	RAILWAY OVER BRIDGE	3	NORMAL JOINT	12	OFFERED BY	AK	PANIYAHWA
4	NUCT PIPE	1	HDP	4	RAILWAY UNDER BRIDGE	4	6 QUAD CABLE	12	APPR. BY	N E RLY	
Customer Name: N. E. RAILWAY											
Prepared By: M/S ANUP KUMAR, DURGABARI ROAD, NEAR PAKKI BAGH GATE, GORAKHPUR											
Revision No: 1											
Modified On: 12/3/13											

← GKP

ROUTE PLAN FOR PIPRAICH - BODARWAR SECTION (6 QUAD CABLE)

VKNR →

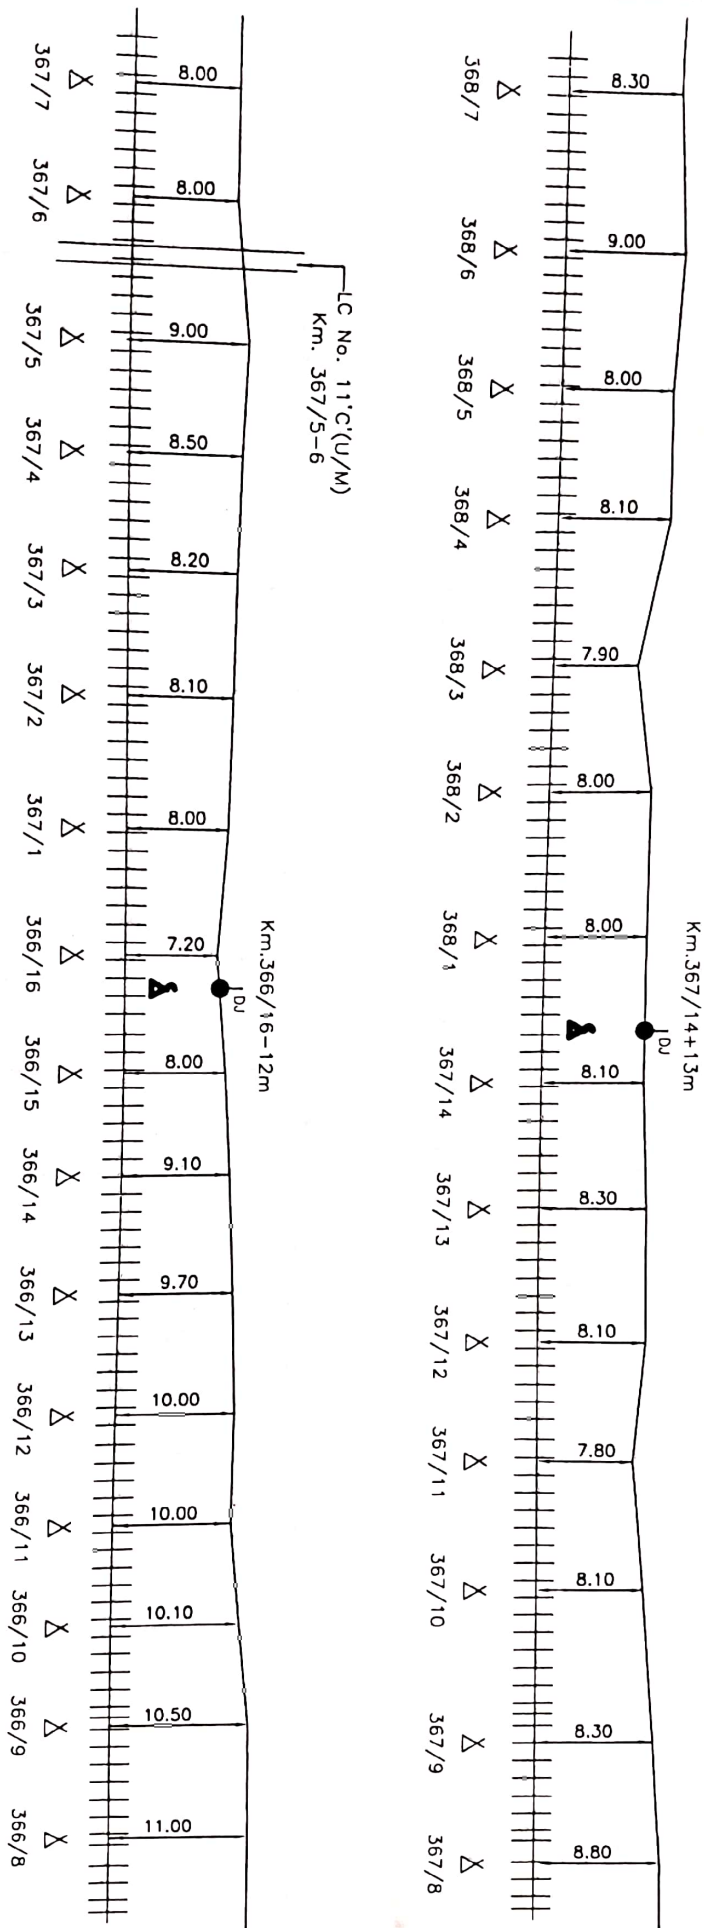

1. T-JOINT MARKER	0 DU	DUCT JOINT MARKER	Σ	L.C. GATE PHONE	DU	DERIVATION JOINT	SHEET NO. 13	CREATED BY AK	Location : -- GORAKHPUR - PANIYAHWA
RAILWAY CROSSING	++	RAILWAY TRACK	X	POLE	Δ	EMERGENCY POST	CREATED ON	OFFERED BY AK	
BRIDGE/CULVERT	—	G.I. PIPE	≡	RAILWAY OVER BRIDGE	● NU	NORMAL JOINT	REVISION NO.	APPR. BY NERLY	
DUCT PIPE	=====	HOPE	≡≡≡	RAILWAY UNDER BRIDGE	—	6 QUAD CABLE	MODIFIED ON	Ref no :- NE/	

CONTRACTOR *Anup Kumar*

SE/TELE/CON/GKP *13/7/13*

ADSTE/CON/EAST/GKP *13/7/13*

DY.CSTE/CON/EAST/GKP *13/7/13*

Customer Name	N. E. RAILWAY
Prepared By :	M/S ANUP KUMAR, DURGABARI ROAD NEAR PAKKI BACH GATE, GORAKHPUR

Not to Scale
All reading in mts

VKNR ↓

(6 QUAD CABLE)




ANUPKUMAR		SE/TELE/CON/GKP		ADST/CON/EAST/GKP		DY.CSTE/CON/EAST/GKP		Customer Name		N. E. RAILWAY	
CONTRACTOR		13/7/13		13/7/13		18/9/13		Prepared By :		M/S ANUP KUMAR, DURGABARI ROAD, NEAR PAKKI BACH GATE GORAKHPUR	
1-JOINT MARKER	0	DUCT JOINT MARKER	2	L.C. GATE PHONE		DERIVATION JOINT		SHEET NO.	14	CREATED BY	AK
RAILWAY CROSSING	111	RAILWAY TRACK	X	POLE		EMERGENCY POST		CREATED ON		OFFERED BY	AK
BRIDGE / CULVERT	0-0	G.I. PIPE	3	RAILWAY OVER BRIDGE		NORMAL JOINT		REVISION NO		APPR BY	NEALY
RAILWAY UNDER BRIDGE	11	RAILWAY UNDER BRIDGE				6 QUAD CABLE		MODIFIED ON		Ref no - NE/	
Location :- GORAKHPUR - PANIYAHWVA											

← GKP

ROUTE PLAN FOR BODARWAR - KAPTANGANJ SECTION (6 QUAD CABLE)

VKNP →

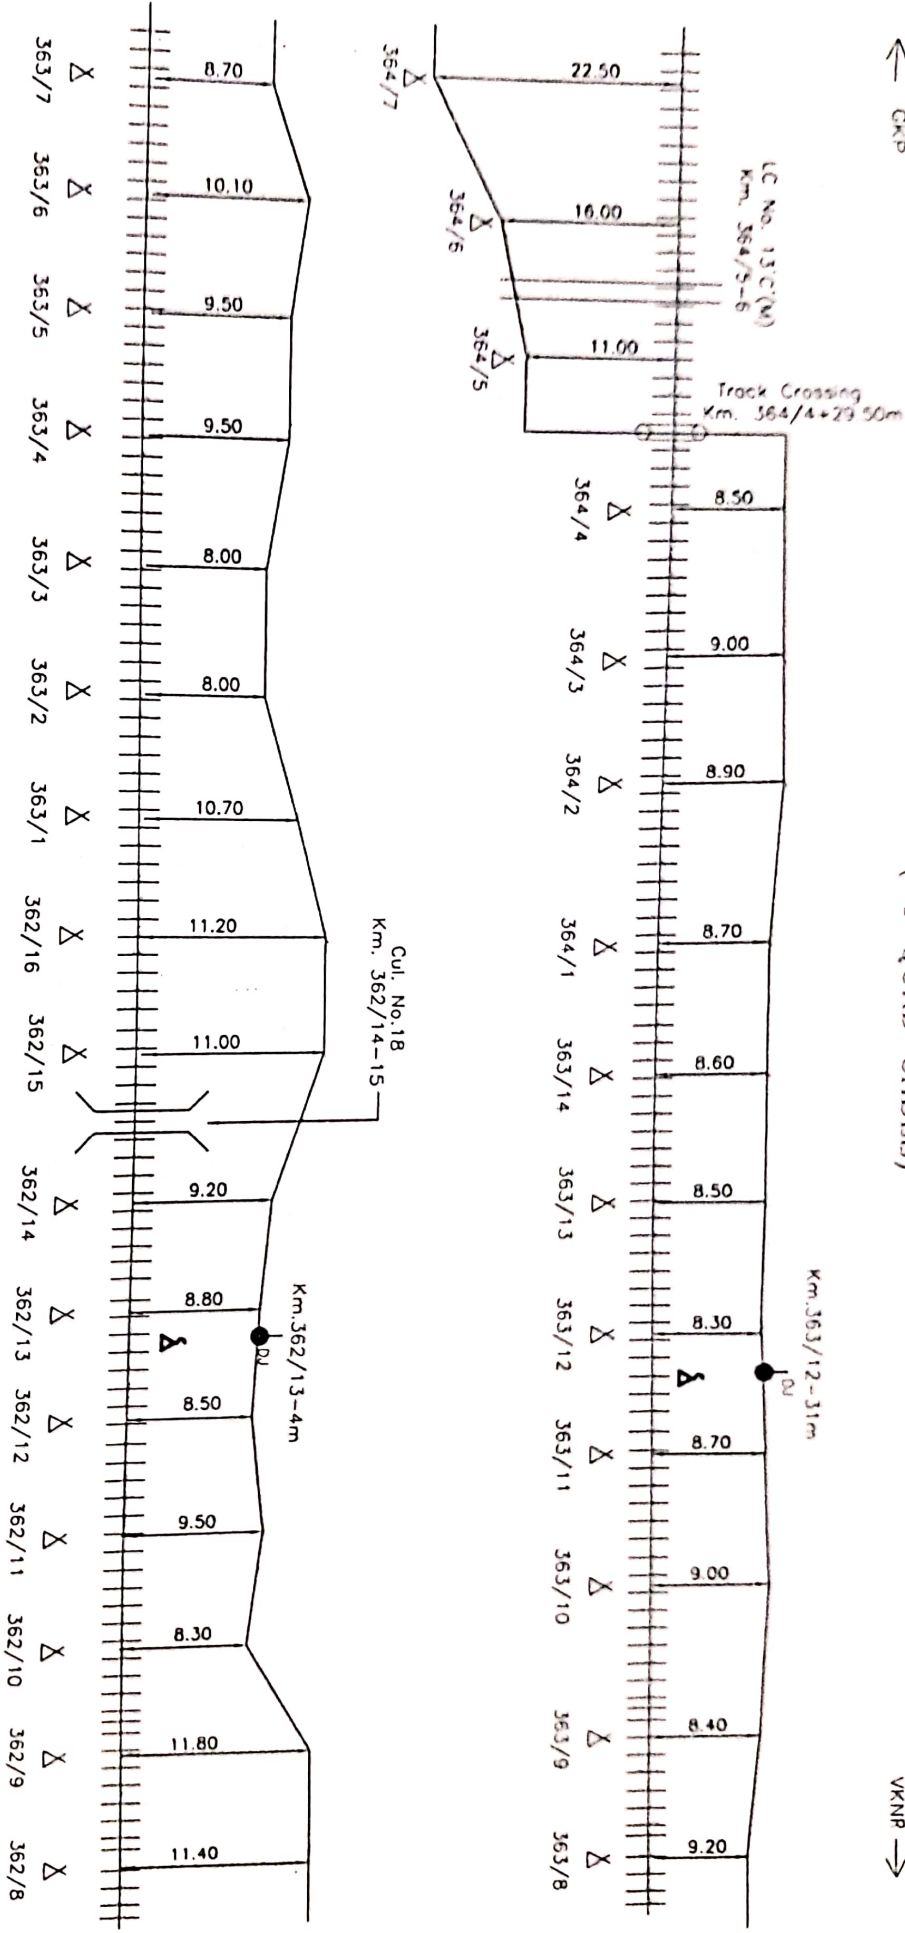

Contractor
SE/TELE/CON/GKP
ADSTE/CON/EAST/GKP
DY.CSTE/CON/EAST/GKP

Customer Name
N. E. RAILWAY
Prepared By : M/S ANUP KUMAR, DURGABARI ROAD, NEAR PAKKI BAGH GATE, GORAKHPUR

Location
GORAKHPUR - PANIYAHWA



Not to Scale
All reading in mts

ROUTE PLAN FOR BODARWAR - KAPTANGANJ SECTION (6 QUAD CABLE)

← CKP

VKNR →

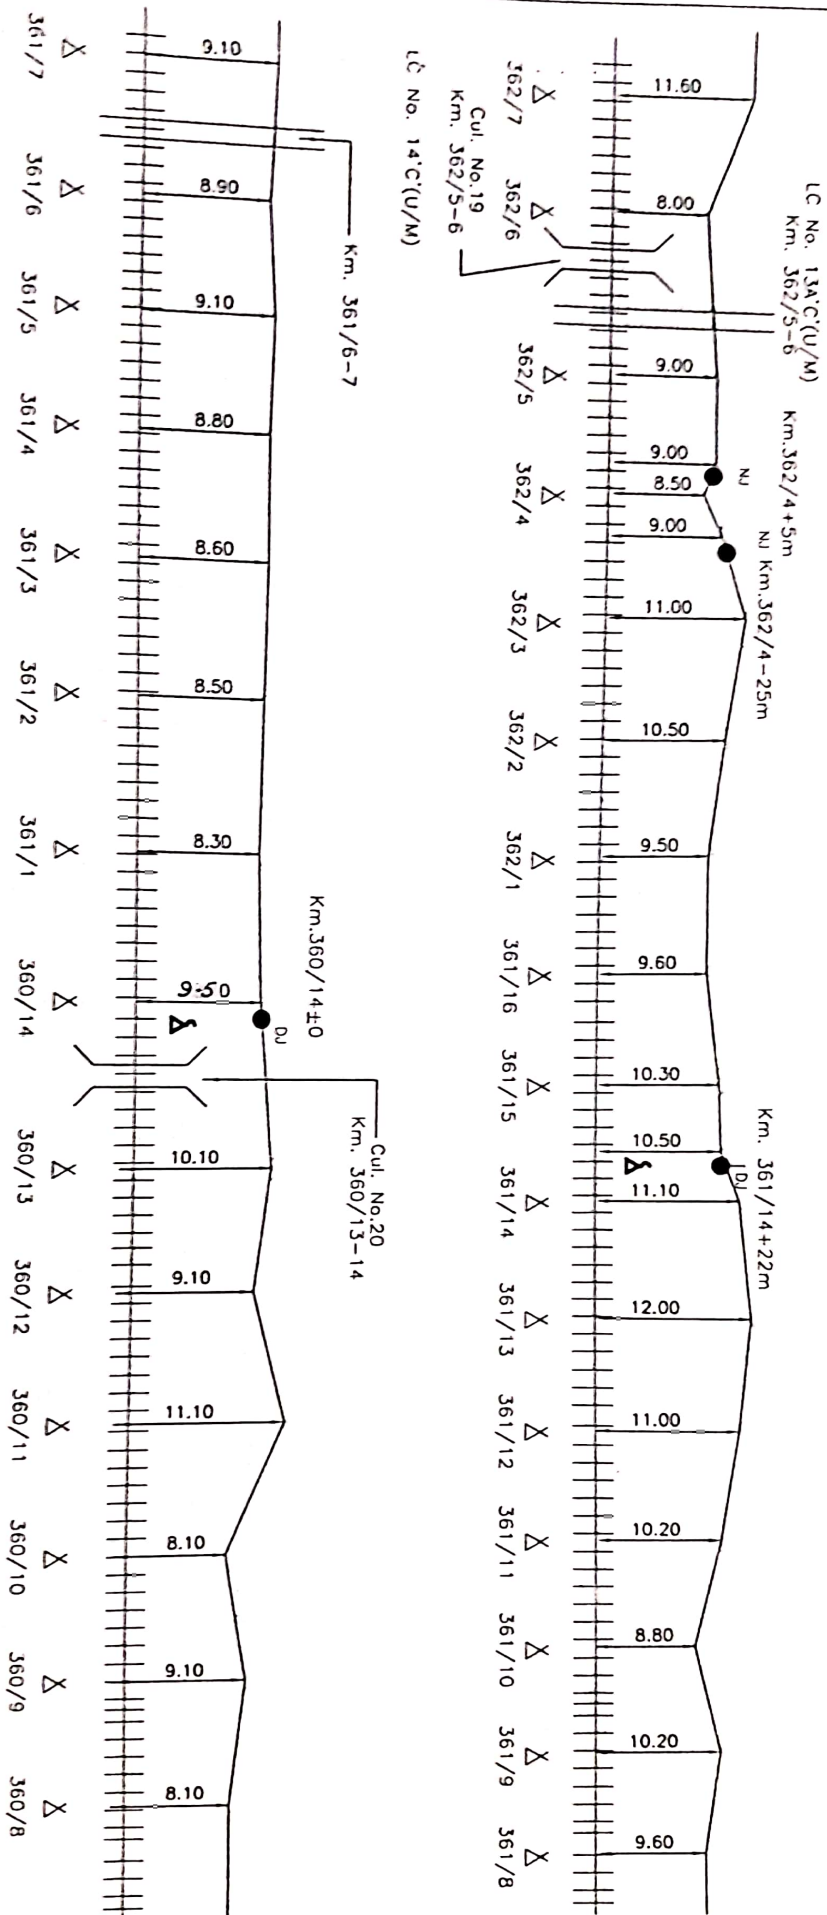

CONTRACTOR
Anup Kumar

SE/TELE/CON/CKP
Sebastian
12/2/13

A DISTE/CON/EAST/CKP

DY.CSTE/CON/EAST/CKP

Customer Name
Prepared By :

M/S ANUP KUMAR, DURGADARI ROAD, NEAR PAKKI BAGH GATE, GORAKHPUR


N. E. RAILWAY

Location :
GORAKHPUR -
PANIYAIHWA

Not to Scale
All reading in mts

1. JOINT MARKER	0	DU	DUCT JOINT MARKER	25	L.C. GATE PHONE	DU	DERIVATION JOINT	SHEET NO.	1/5	CREATED BY	AK	Location : GORAKHPUR - PANIYAIHWA
RAILWAY CROSSING	44	HH	RAILWAY TRACK	X	POLE	Δ	EMERGENCY POST	CREATED ON		OFFERED BY	AK	
BRIDGE/CULVERT	0	0	G.I PIPE	X	RAILWAY OVER BRIDGE	●	NORMAL JOINT	REVISION NO		APPROVED BY	ME/RY	
DUCT PIPE	00000	HDPE	HDPE	34	RAILWAY UNDER BRIDGE	—	6 QUAD CABLE	MODIFIED ON		Ref no - NE/		

ROUTE PLAN FOR BODARWAR - KAPTANGANJ SECTION (6 QUAD CABLE)

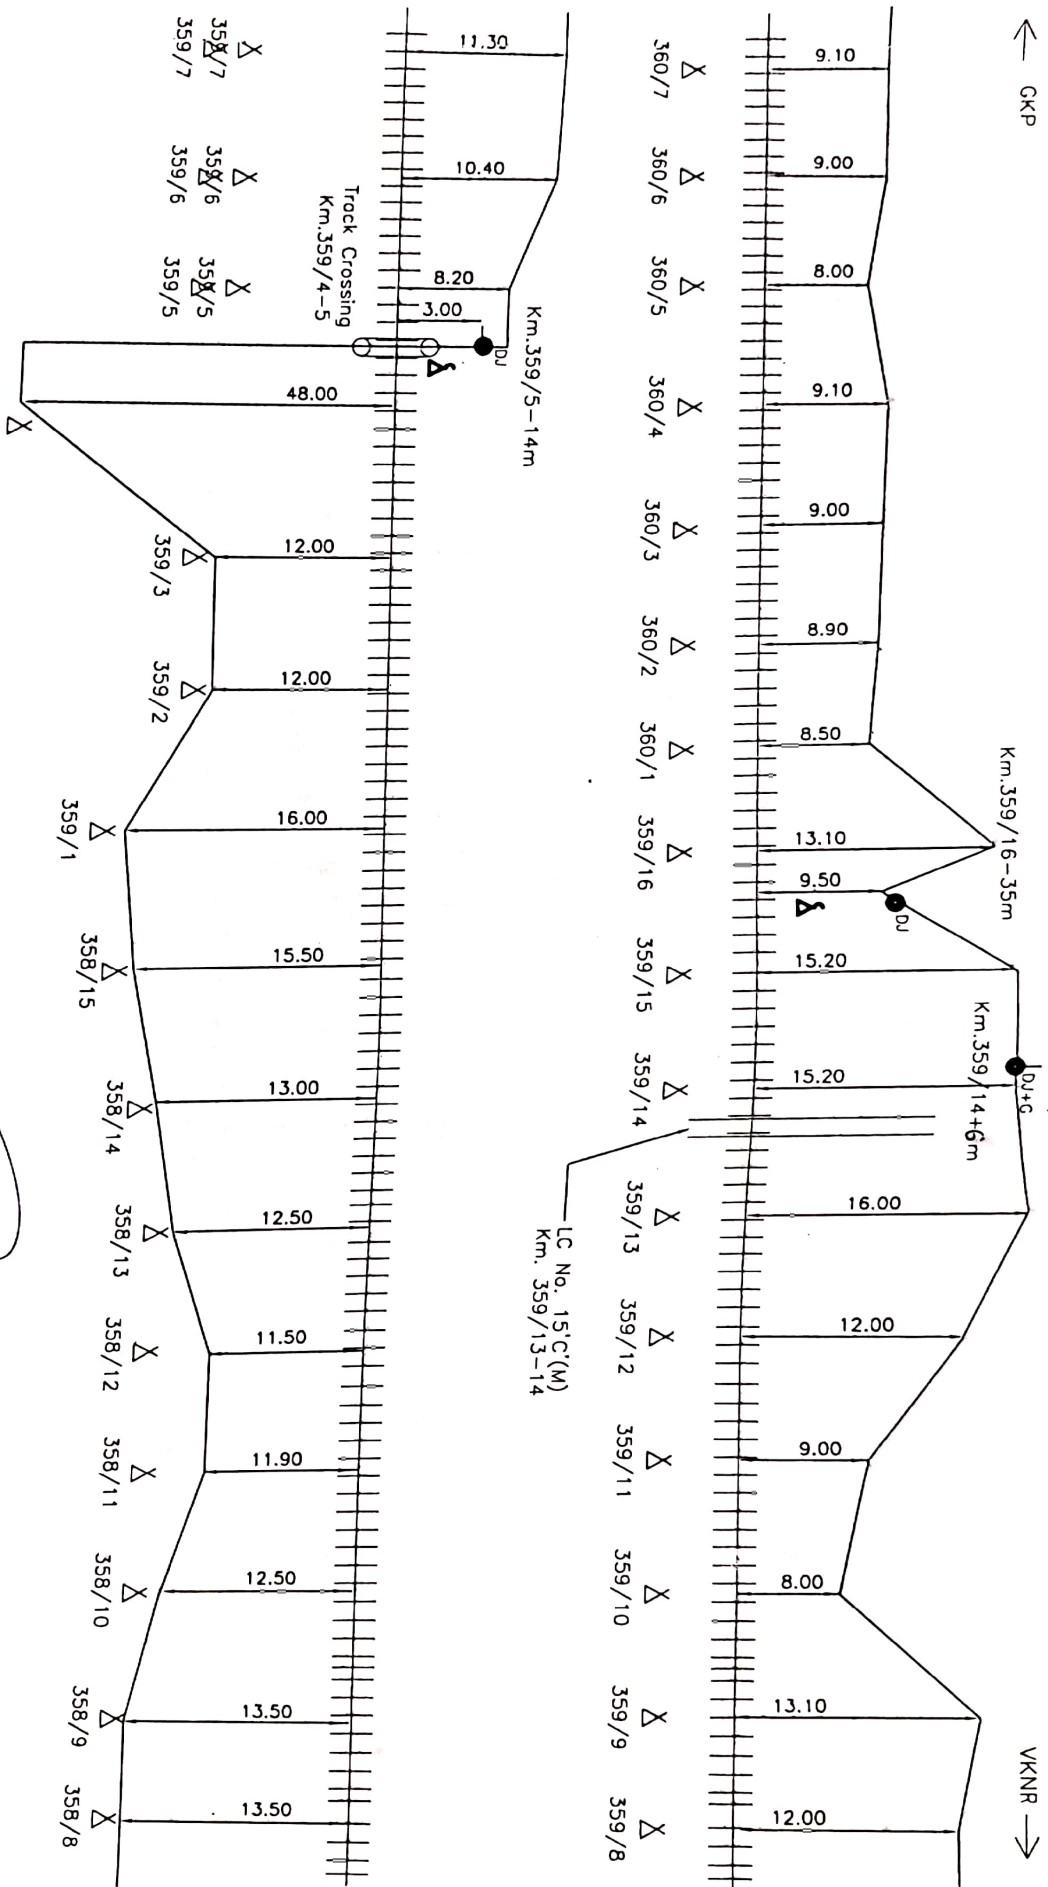

Signature
CONTRACTOR

359/4
Signature
SE/TELE/CON/GKP

ADSTE/CON/EAST/GKP

DY CSTE/CON/EAST/GKP

Signature
16/09/13

Not to Scale
All reading in mts

1-JOINT MARKER	DU	DUCT JOINT MARKER	DU	L.C. GATE PHONE	DU	DERIVATION JOINT	DU	Customer Name	N. E. RAILWAY
RAILWAY CROSSING	HH	RAILWAY TRACK		POLE		EMERGENCY POST		Prepared By :	M/S ANUP KUMAR, DURGABARI ROAD NEAR PARKI BAGH GATE, GORAKHPUR
BRICK/CONCRETE		G.I. PIPE		RAILWAY OVER BRIDGE		NORMAL JOINT		CREATED ON	17
DUCT PIPE		HDPE		RAILWAY UNDER BRIDGE				OFFERED BY	AK
								APPR BY	AK
								REVISION NO.	
								MODIFIED ON	
								Ref no - NE/	
								Location :-	GORAKHPUR, PANIYAHWA

(6 QUAD CABLE)





Customer Name		N. E. RAILWAY	
Prepared By		M/S ANUP KUMAR DURGABADI ROAD, NEAR PAKKI BAGH GATE, GORAKHPUR	
		Location GORAKHPUR PANYALWA	

← GKP

ROUTE PLAN FOR KAPTANGANJ - CHUGHULI SECTION (6 QUAD CABLE)

→ VKNR

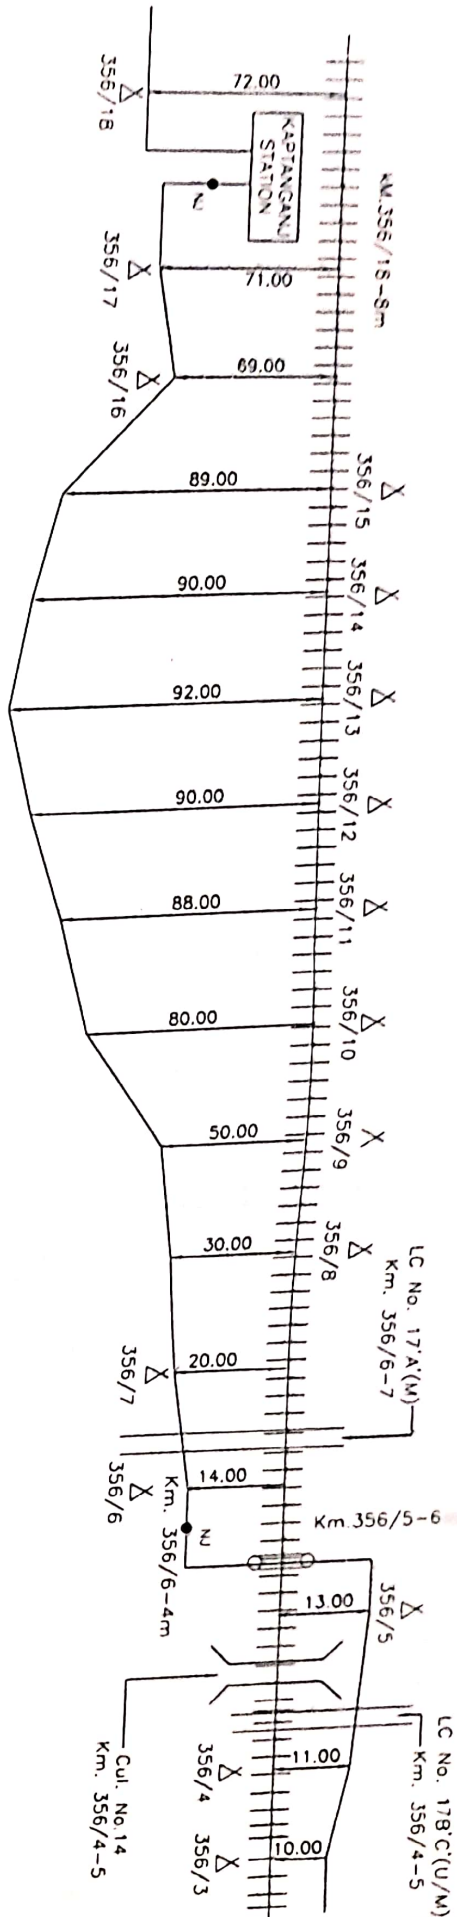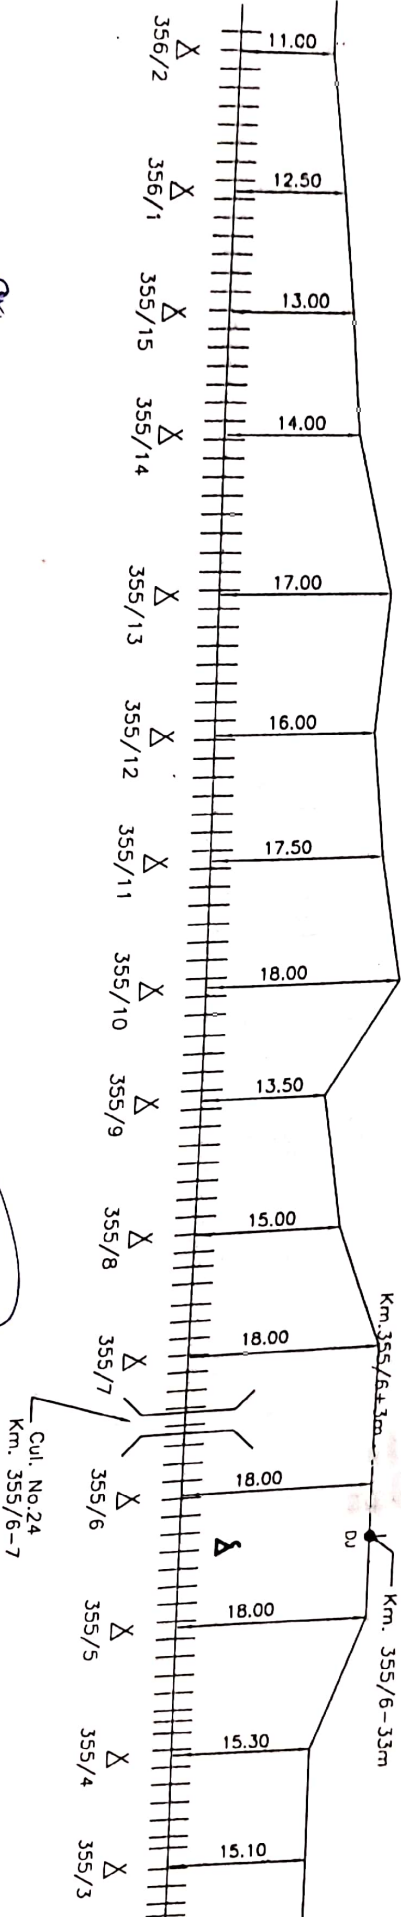

CONTRACTOR *Amphikumar*

SE/TELE/CON/GKP *Sebagha*

ADSTE/CON/EAST/GKP *12/3/13*

DY/STE/CON/EAST/GKP *18/09/13*

Customer Name

N. E. RAILWAY

Prepared By : M/S ANUP KUMAR, DURGABARI ROAD, NEAR PAKKI BAGH GATE, GORAKHPUR


Location : -- GORAKHPUR - PANIVAHWA

Symbol	Description	Symbol	Description	Symbol	Description	Symbol	Description	Symbol	Description
+	T-JOINT MARKER	0	DUCT JOINT MARKER	+	L.C. GATE PHONE	+	DERIVATION JOINT	+	CREATED BY
+	RAILWAY CROSSING	+	RAILWAY TRACK	+	POLE	+	EMERGENCY POST	+	OFFERED BY
+	BRIDGE/CULVERT	+	C.I. PIPE	+	RAILWAY OVER BRIDGE	+	NORMAL JOINT	+	APPR BY
+	DUCT PIPE	+	HOPE	+	RAILWAY UNDER BRIDGE	+	6 QUAD CABLE	+	N.E. RLY
+		+		+		+		+	MODIFIED ON
+		+		+		+		+	Ref no - NE/

Not to Scale
All reading in m/s



ROUTE PLAN FOR KAPTANGANJ - GHUGHULI SECTION (6 QUAD CABLE)

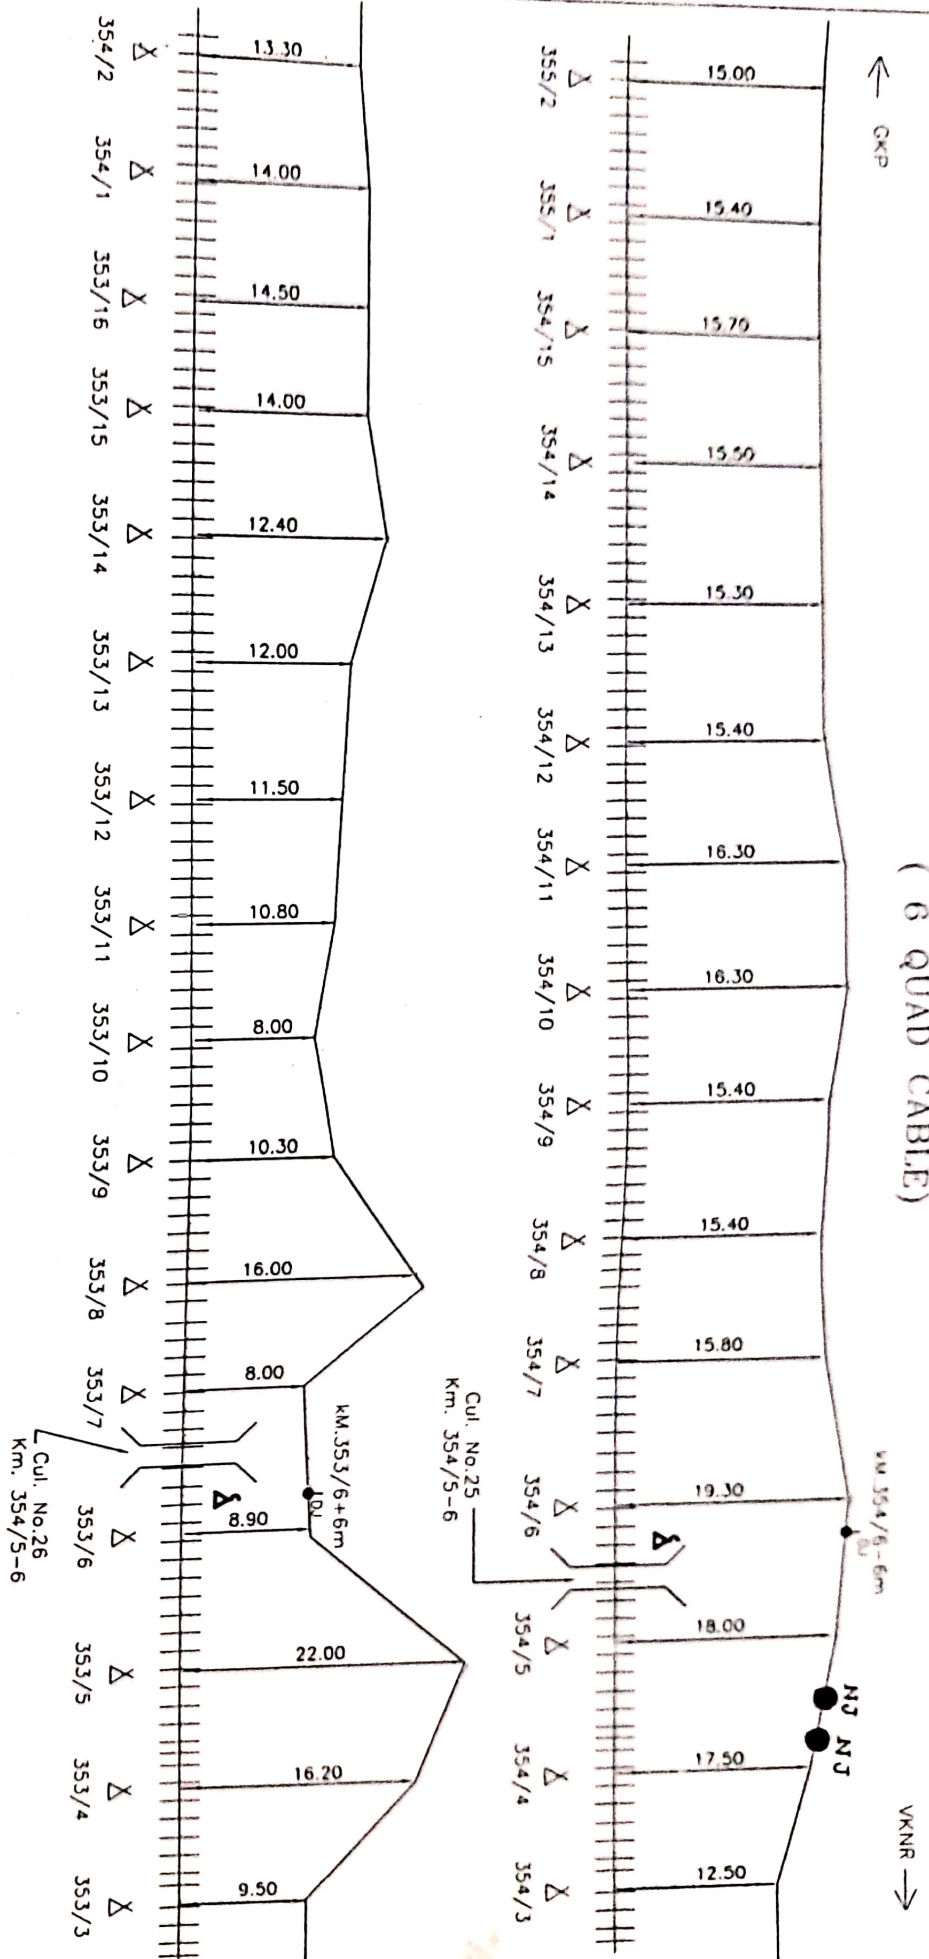

1-JOINT MARKER	0 DU	DUCT JOINT MARKER	LC. GATE PHONE	DERIVATION JOINT	SHEET NO.	20	CREATED BY	AK	LOCATION	GORAKHPUR - PANITYAHWA
RAILWAY CROSSING	##	RAILWAY TRACK	POLE	EMERGENCY POST	CREATED ON		OFFERED BY	AK		
BRIDGE/CULVERT	□	G.I. PIPE	RAILWAY OVER BRIDGE	N.J.	REVISION NO.		APPR BY	NE RLY		
DUCT PIPE	□	HDPE	RAILWAY UNDER BRIDGE	6 QUAD CABLE	MODIFIED ON		Ref no. - NE/			

CONTRACTOR

SE/TELE/CON/GKP

AUSTE/CON/EAST/GKP

DR.CSTE/CON/EAST/GKP

Customer Name
Prepared By :
M/S ANUP KUMAR, DURGABARI ROAD, NEAR PAKKI BACH GATE, GORAKHPUR

N. E. RAILWAY



Not to Scale
All reading in mts



ROUTE PLAN FOR KAPTANGANJ - GHUGHULI SECTION (6 QUAD CABLE)

← GKP


VKNR →

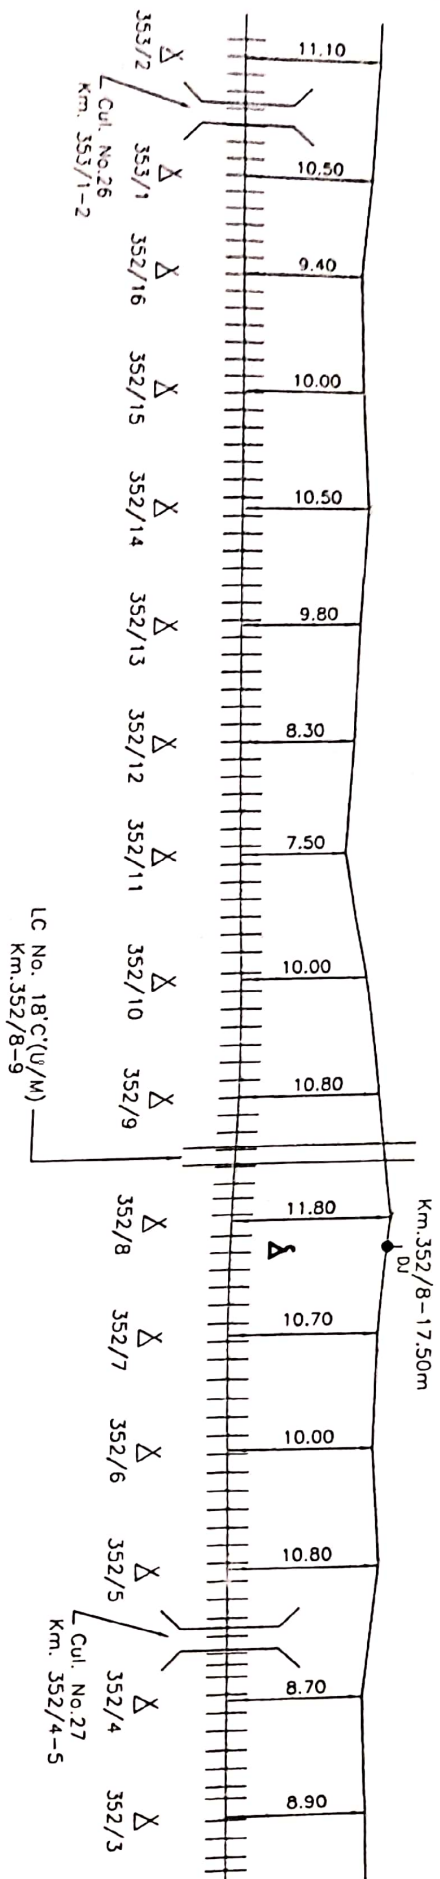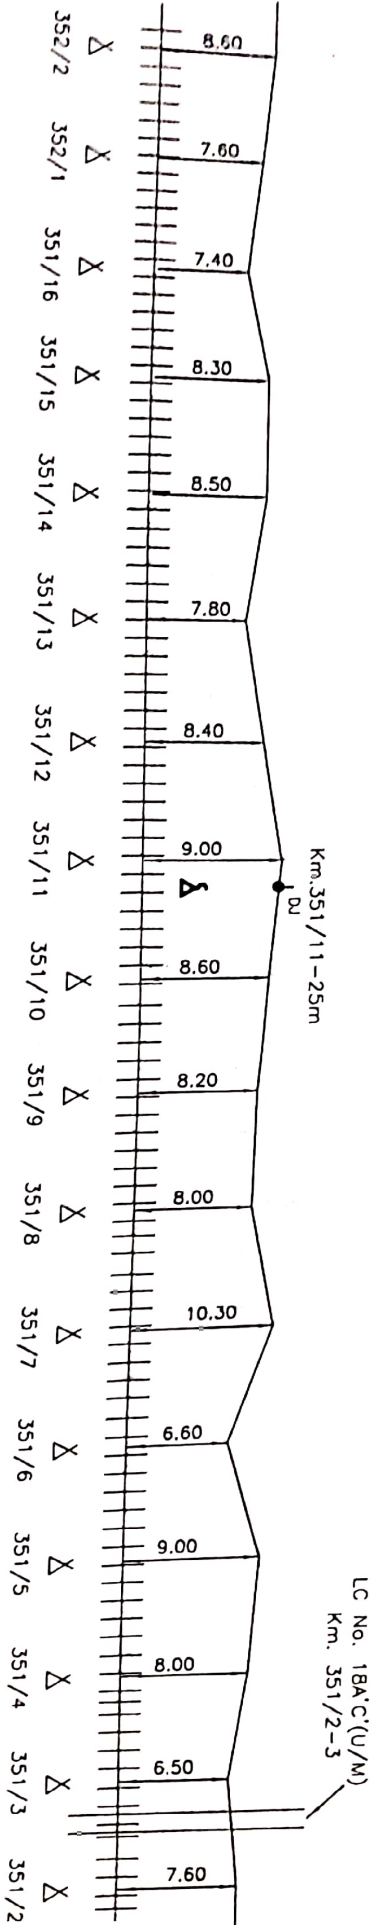

CONTRACTOR		SE/TELE/CON/GKP		ADSTE/CON/EAST/GKP		DY/ASTE/CON/EAST/GKP		Customer Name		N. E. RAILWAY	
1. JOINT WARNER	0 DU	DUCT JOINT MARKER	Σ	L.C. GATE PHONE	— DU	DERIVATION JOINT	Prepared By :	M/S ANUP KUMAR, DURGABARI ROAD, NEAR PAKKI BAGH GATE, GORAKHPUR	CREATED BY	AK	Location : --
RAILWAY CROSSING	HH	RAILWAY TRACK		POLE	Δ	EMERGENCY POST	CREATED ON		OFFERED BY	AK	GORAKHPUR -
RANGE/CULVERT	□	C.I. PIPE	Δ	RAILWAY OVER BRIDGE	● NU	NORMAL JOINT	REVISION NO		APPR BY	N. E. RLY	PAINIYAHWA
DUCT PIPE	□	HDPE	≠	RAILWAY UNDER BRIDGE		6 QUAD CABLE	MODIFIED ON		Ed no - NE/		



Not to Scale
All reading in mts

VKMP →

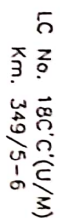

Not to Scale
All reading in mts

ROUTE PLAN FOR KAPTANGANJ - GHUGHULI SECTION (6 QUAD CABLE)

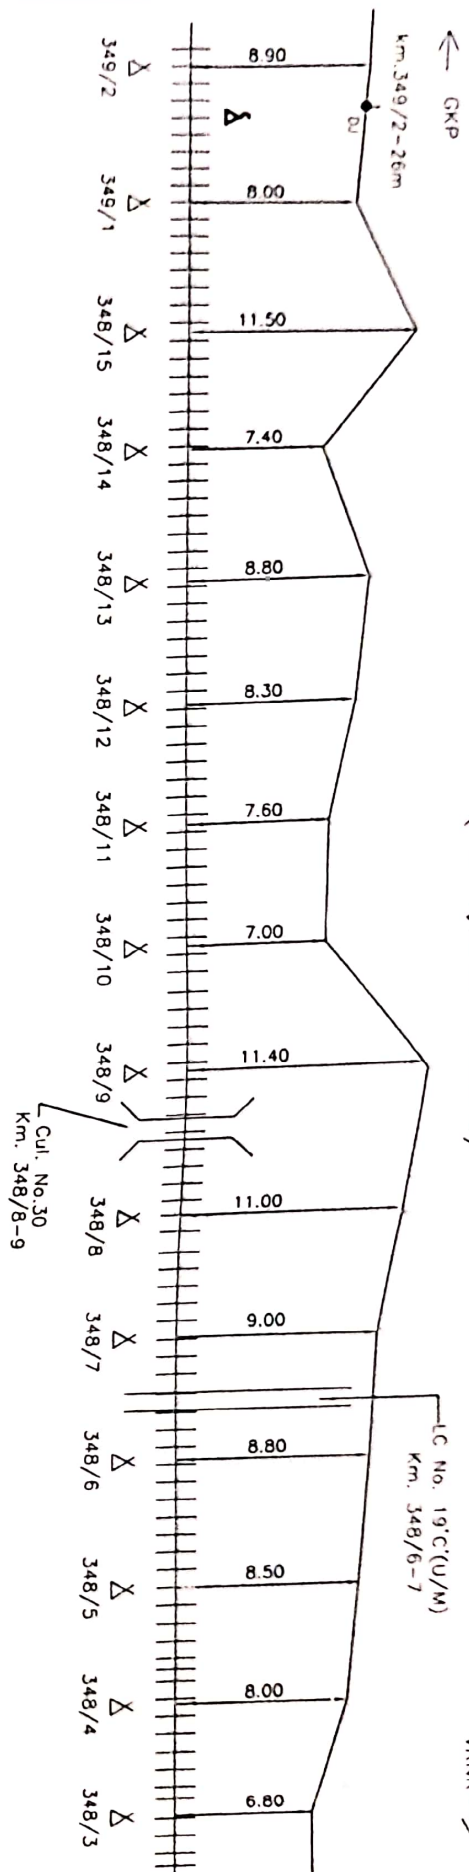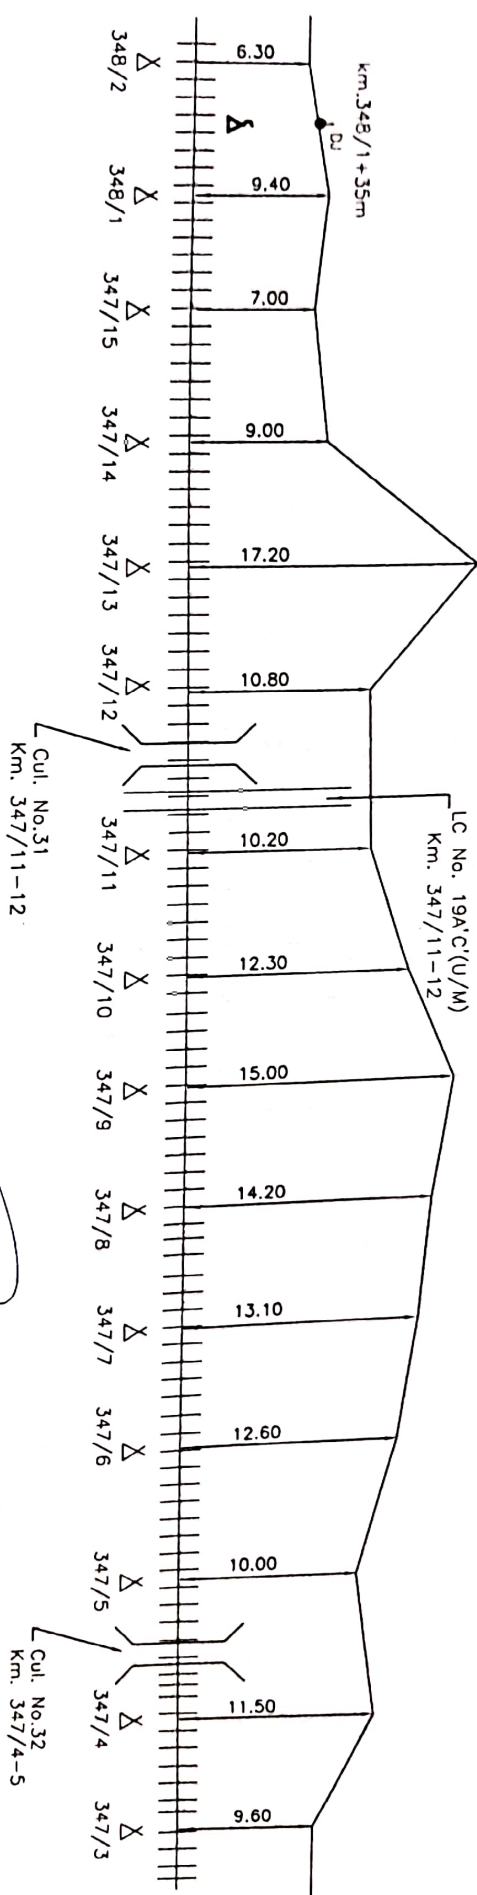

Amr Kumar
CONTRACTOR

Sehgal
SE/TELE/CON/GKP

14/09/13
ADSTE/CON/EAST/GKP

14/09/13
DY.CSTE/CON/EAST/GKP

1-JOINT MARKER	0 DU	DUCT JOINT MARKER	20	L.C. GATE PHONE	DU	DERIVATION JOINT	23	CREATED BY	AK	Location :-
RAILWAY CROSSING	HH	RAILWAY TRACK	X	POLE	X	EMERGENCY POST	AK	OFFERED BY	AK	GORAKHPUR -
BRIDGE/CULVERT	GD	G.I. PIPE	X	RAILWAY OVER BRIDGE	NJ	NORMAL JOINT	AK	APPR. BY	N.E.R.V	PANIYAHWA
DUCT PIPE	HDPE	RAILWAY UNDER BRIDGE	X	6 QUAD CABLE				MODIFIED ON		

Customer Name: M/S ANUP KUMAR, DURGADEVI ROAD, NEAR PAKKI BAGH GATE, GORAKHPUR

Prepared By: N. E. RAILWAY

Sheet No. 23






Not to Scale

All reading in mts


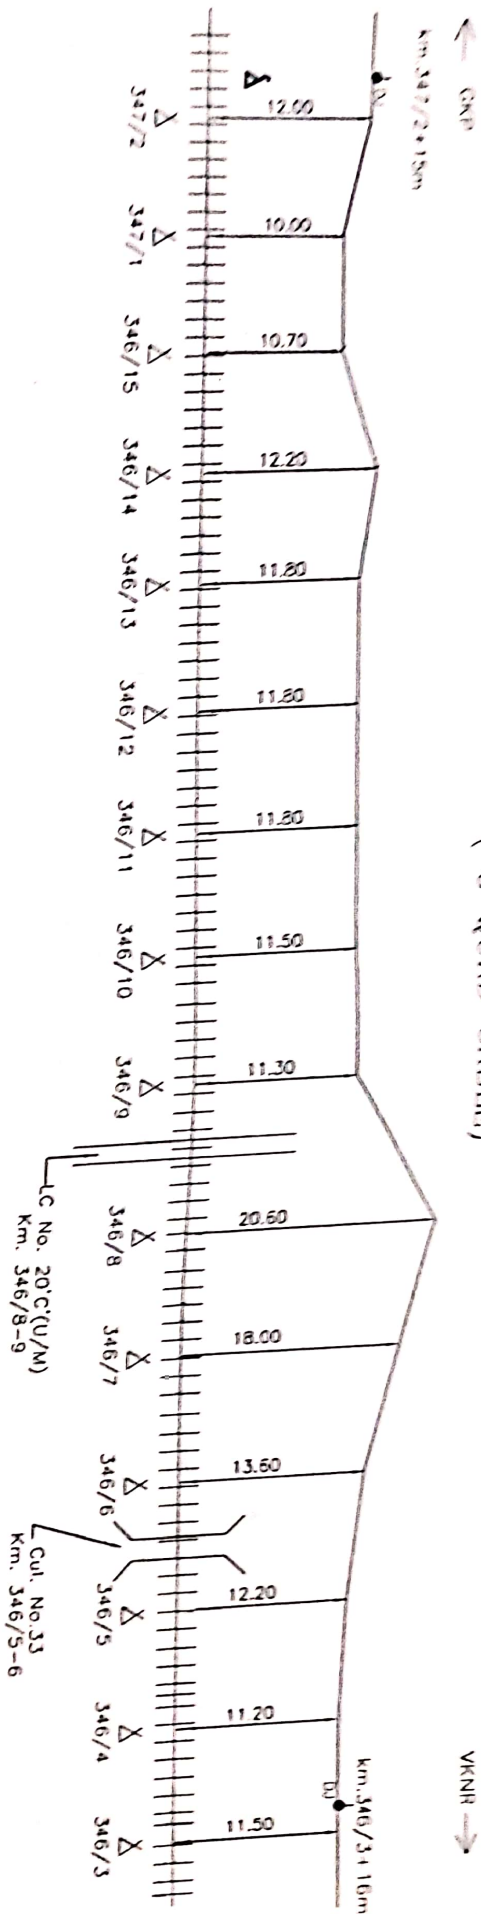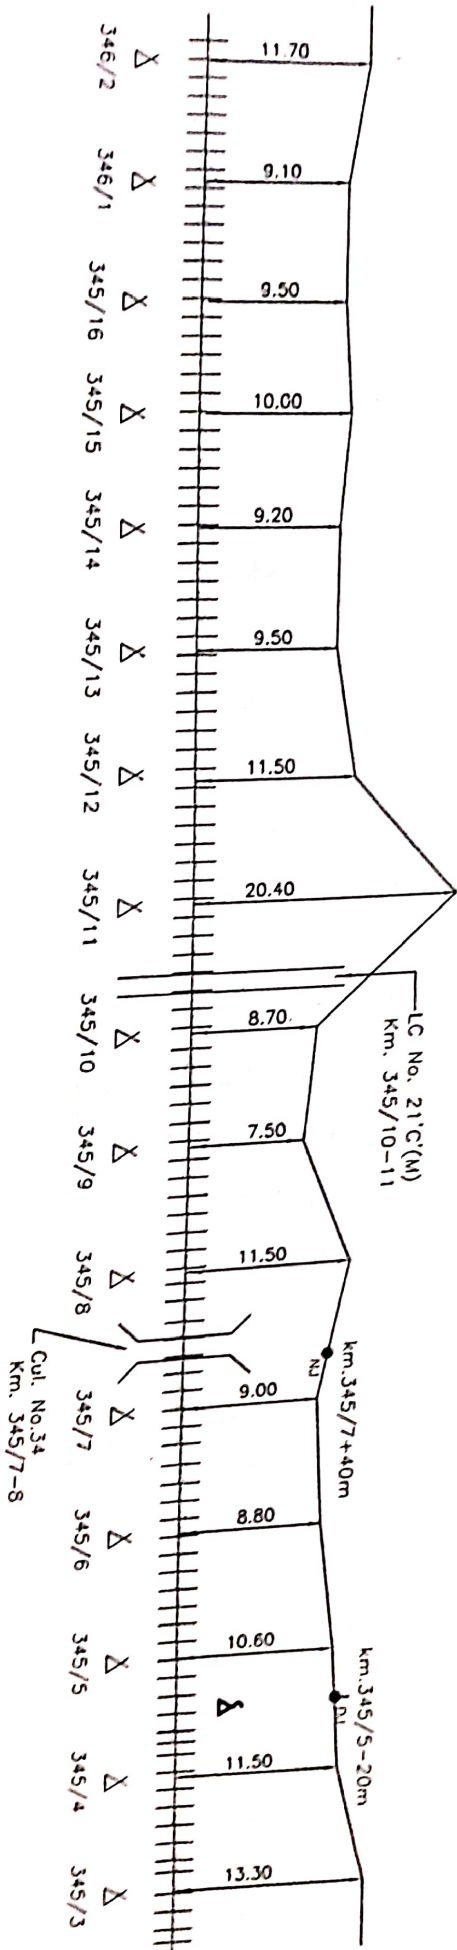

CONTRACTOR		ADSTE/CON/EAST/GKP		DY/STE/CON/EAST/GKP	
SE/TELE/CON/GKP		ADSTE/CON/EAST/GKP		DY/STE/CON/EAST/GKP	
JOINT MARKER	DU	JOINT MARKER	DU	DERIVATION JOINT	DU
RAILWAY CROSSING	TH	RAILWAY TRACK	TH	EMERGENCY POST	DU
BRIDGE/OVERT	DU	RAILWAY OVER BRIDGE	DU	NOCTUAL JOINT	DU
DUCT PIPE	HOPE	RAILWAY UNDER BRIDGE	DU	6 QUAD CABLE	HOPE



Customer Name	N. E. RAILWAY				
Prepared By :	M/S ANUP KUMAR, DURGAHARI ROAD, NEAR PAKKI BACH GATE, GORAKHPUR, PANTIAHWA				
SHEET NO.	24	CREATED BY	AK	OFFERED BY	AK
CREATED ON		APPROVED BY	AK	APPROVED ON	
MODIFIED ON		94/12-15/			

Not to Scale
All reading in mts

ROUTE PLAN FOR KAPTANGANJ - GHUGHUL SECTION (6 QUAD CABLE)

← GND

VKMR →

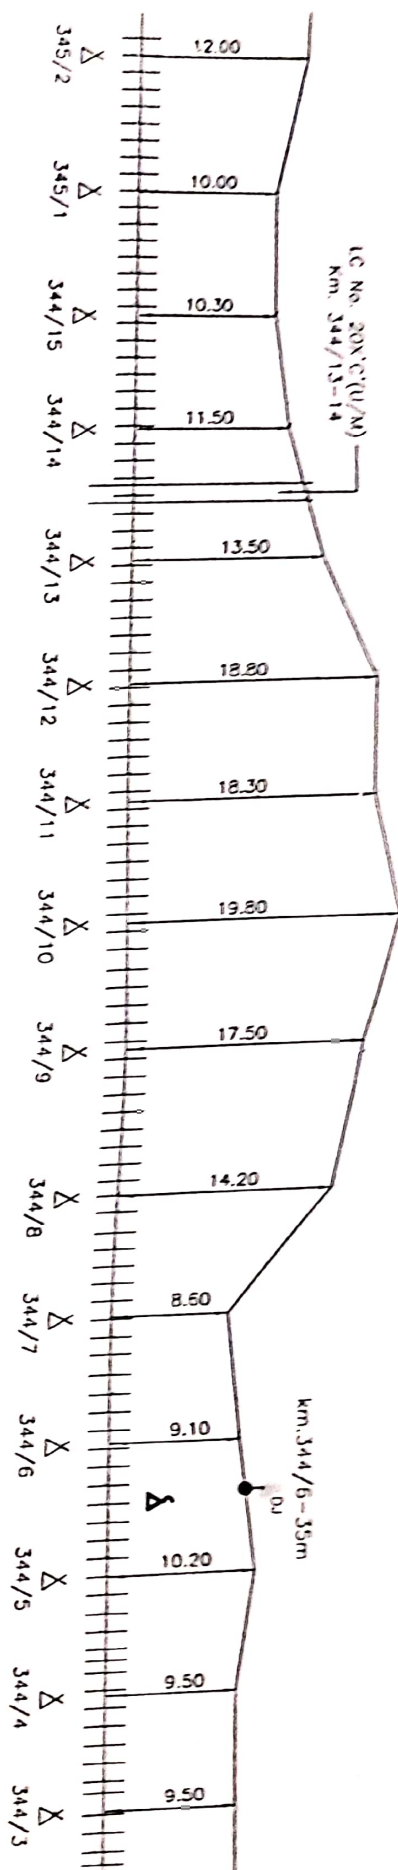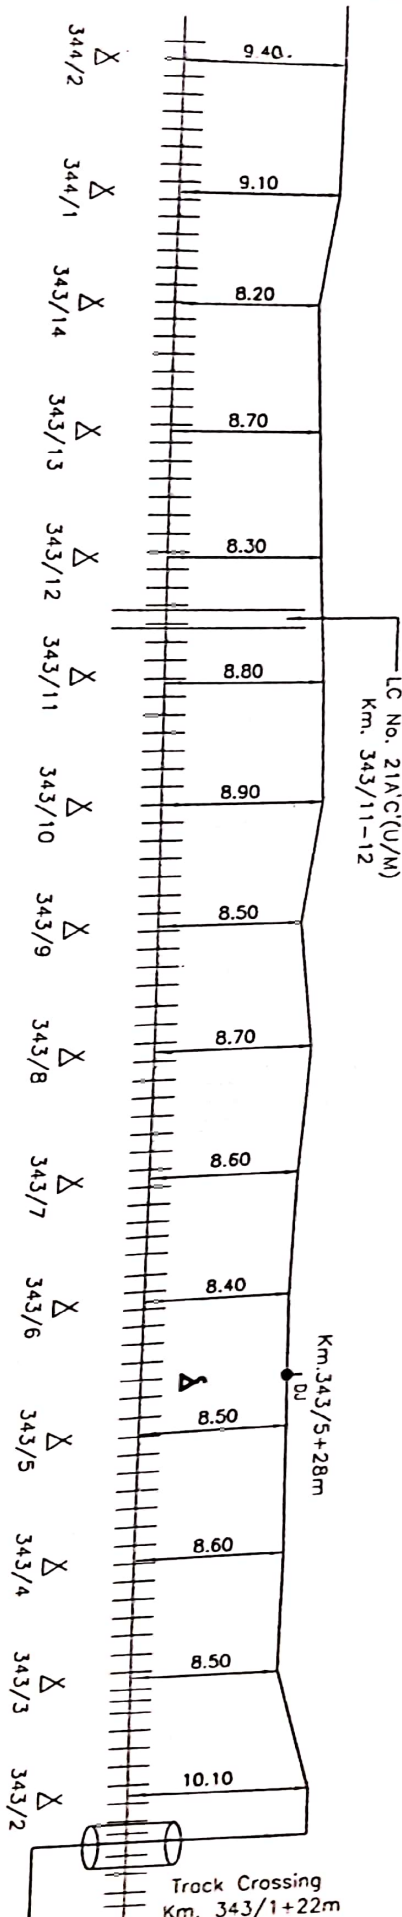



CONTRACTOR		SE/TELE/CON/GKP		ADSTIE/CON/EAST/GKP		DY.CSTE/CON/EAST/GKP		Customer Name		N. E. RAILWAY	
RAILWAY CROSSING		RAILWAY TRACK		RAILWAY UNDER BRIDGE		RAILWAY OVER BRIDGE		Prepared By :		M/S ANUP KUMAR, DURGABARI ROAD NEAR PAKI BAGH CATE, GORAKHPUR	
DUCT PIPE		DUCT JOINT MARKER		RAILWAY GATE PHONE		RAILWAY OVER BRIDGE		SHEET NO.		25	
DUCT PIPE		RAILWAY UNDER BRIDGE		RAILWAY OVER BRIDGE		RAILWAY OVER BRIDGE		CREATED ON		OFFERED BY	

Not to Scale
All reading in mts



CKD ↑

↓
VKZR

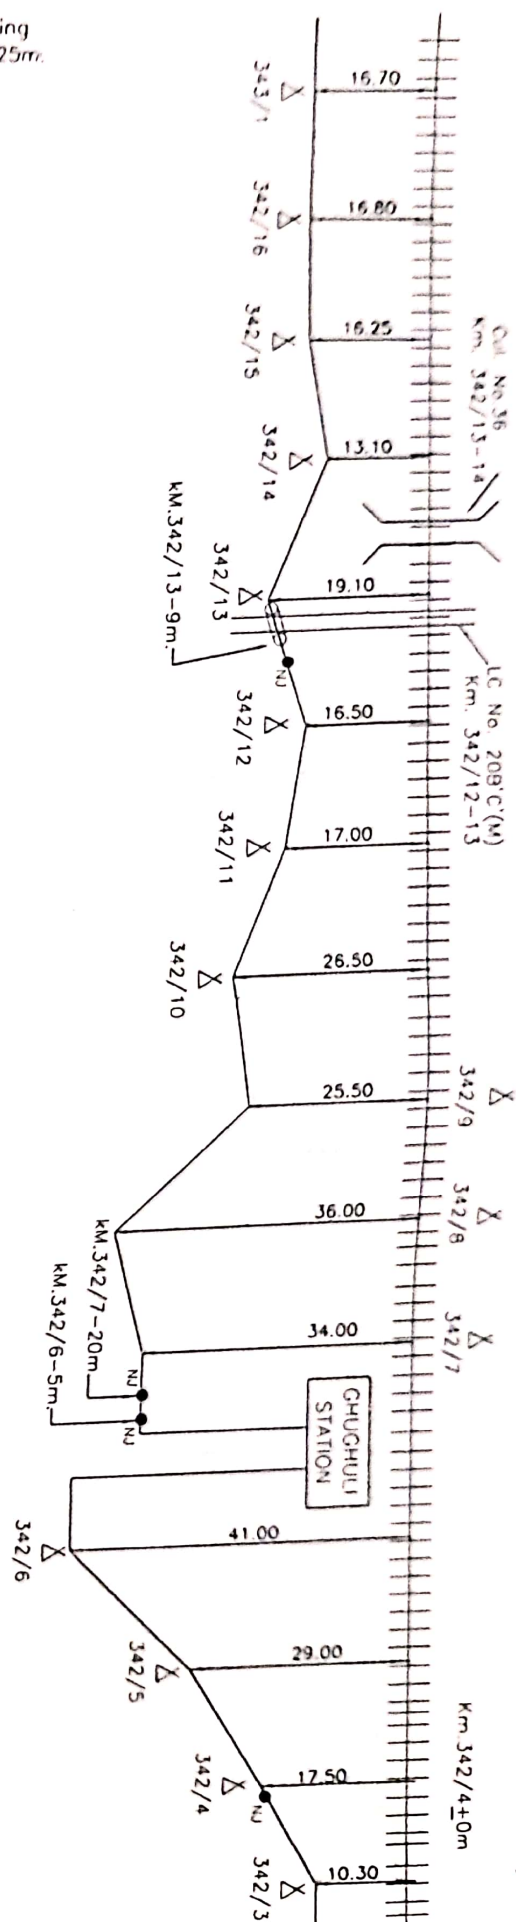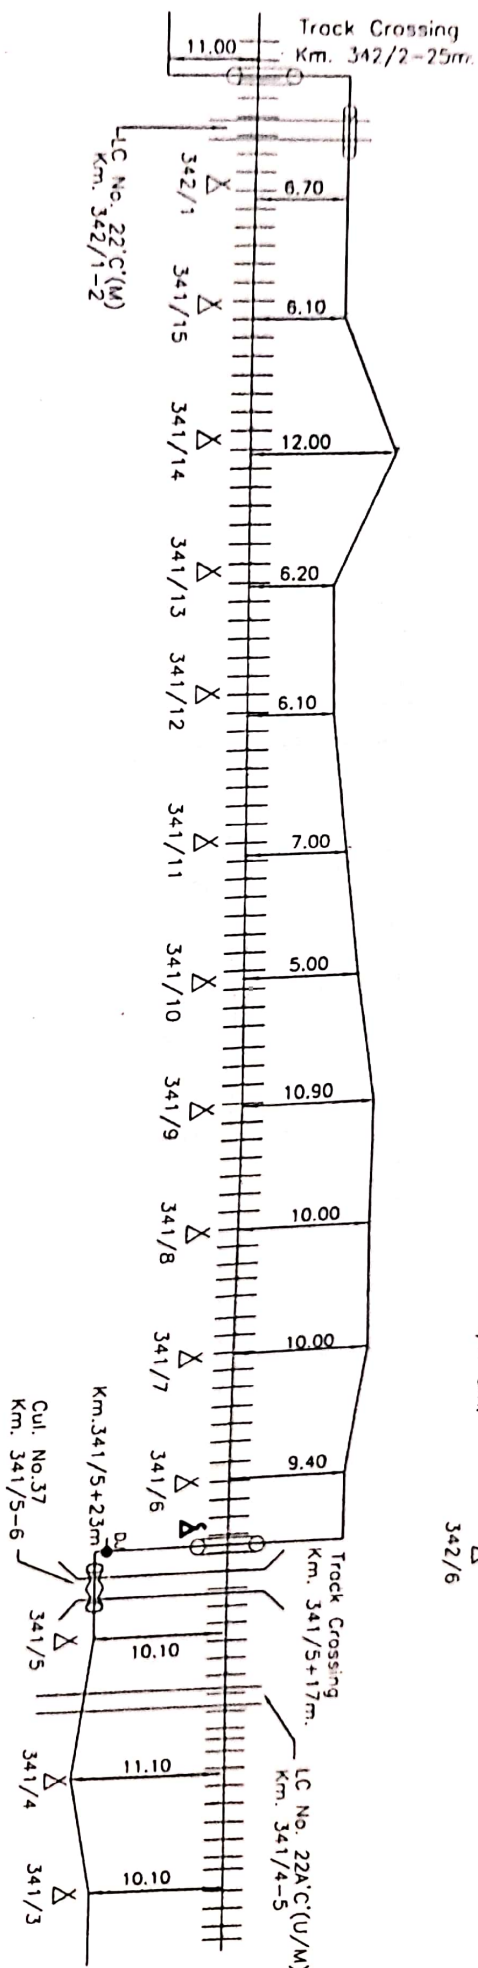

342/2

CONTRACTOR

del-cyba.
12/3/13
SE/TELE/CON/GK

ADSTE/CON/EAST/GKP

DR. CSTE/CON/EAST/GKP

Customer Name

N. E. RAILWAY
M/S ANUP KUMAR, DURGABARI ROAD, NEAR PAKKI BAGH GATE,
GORAKHPUR

Not to Scale
All reading in mts


[illegible]

ROUTE PLAN FOR GHUGHULI - SISWABAZAR SECTION (6 QUAD CABLE)


GKD ←

YKNR →

Cul. No. 38
Km. 340/5-6

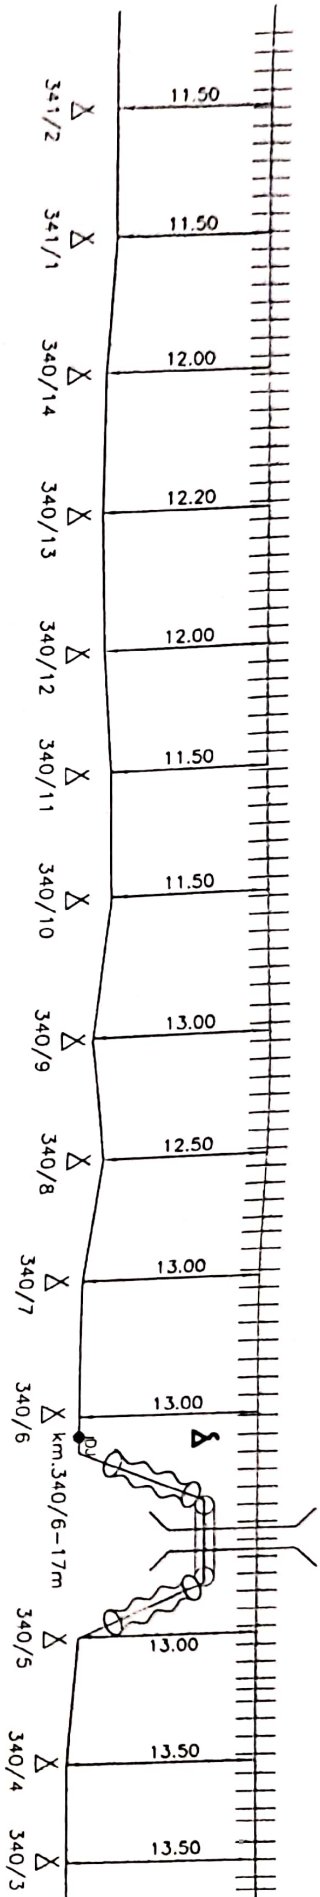

km. 339/6+36m

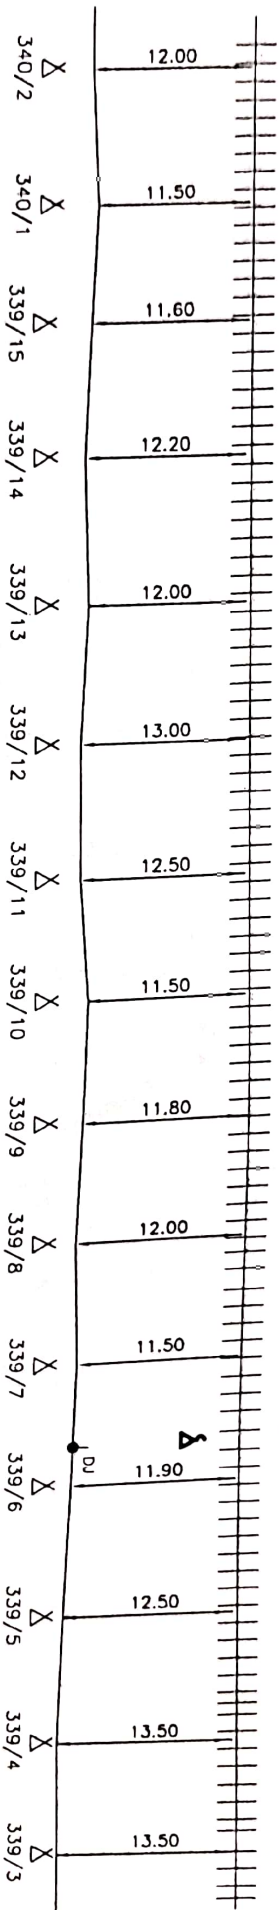

CONTRACTOR

SE/TELE/CON/GKP

ADST/CON/EAST/GKP

DY. CSTE/CON/EAST/GKP

18/09/13

1-JOINT MARKER	0 D	DUCT JOINT MARKER	2	L.C. GATE PHONE	1 D	DERIVATION JOINT
RAILWAY CROSSING	+	RAILWAY TRACK		POLE		EMERGENCY POST
BRIDGE/CULVERT	O	G.I. PIPE		RAILWAY OVER BRIDGE		NORMAL JOINT
DUCT PIPE	W			RAILWAY UNDER BRIDGE		6 QUAD CABLE


Customer Name	N. E. RAILWAY			
Prepared By :	M/S ANUP KUMAR, DURGABARI ROAD, NEAR PAKKI BACH GATE, GORAKHPUR			
SHEET NO.	27	CREATED BY	AK	Location :- GORAKHPUR - PANTIAHWA
CREATED ON		OFFERED BY	AK	
REVISION NO.		APPR. BY	N. E. RLY	
MODIFIED ON		Ref. no. -	NE/	

Not to Scale
All reading in mts

← GKP

ROUTE PLAN FOR GHUGHULI - SISWABAZAR SECTION (6 QUAD CABLE)

VKNR →

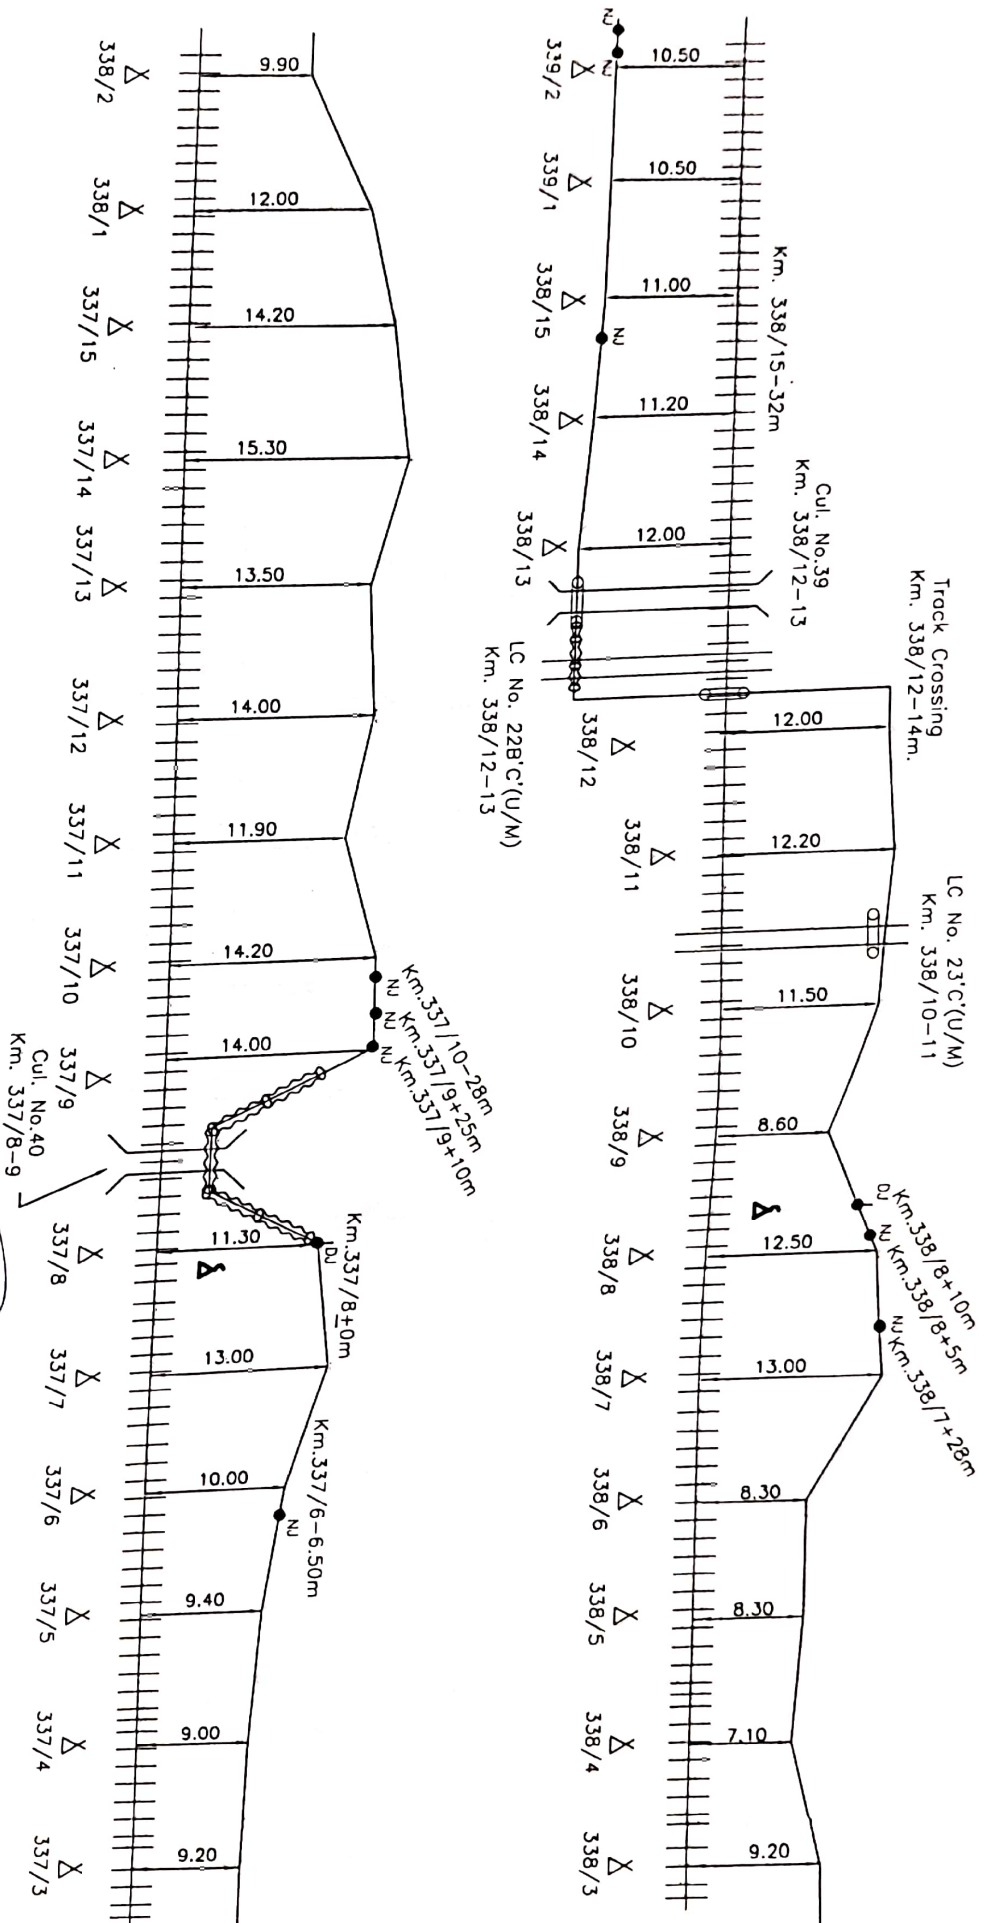

Signature

Signature

SE/TELE/CON/337/13

ADJSTE/CON/EAST/GKP

DY.CSTE/CON/EAST/GKP

Customer Name

N. E. RAILWAY
W/S ANUP KUMAR, DURGADEVI ROAD, NEAR PAKKI BAGH GATE, GORAKHPUR

Location : ---
GORAKHPUR -
PANIYAHWA

Prepared By :

CREATED BY : AK

OFFERED BY : AK

SHEET NO. : 28

CREATED BY : AK

OFFERED BY : AK

CREATED ON :

OFFERED BY : AK

OFFERED BY : AK

REVISION NO. :

APPR. BY : N.E. RLY

APPR. BY : N.E. RLY

MODIFIED ON :










ROUTE PLAN FOR GHUGHULI - SISWABAZAR SECTION (6 QUAD CABLE)

GKP

VKNR

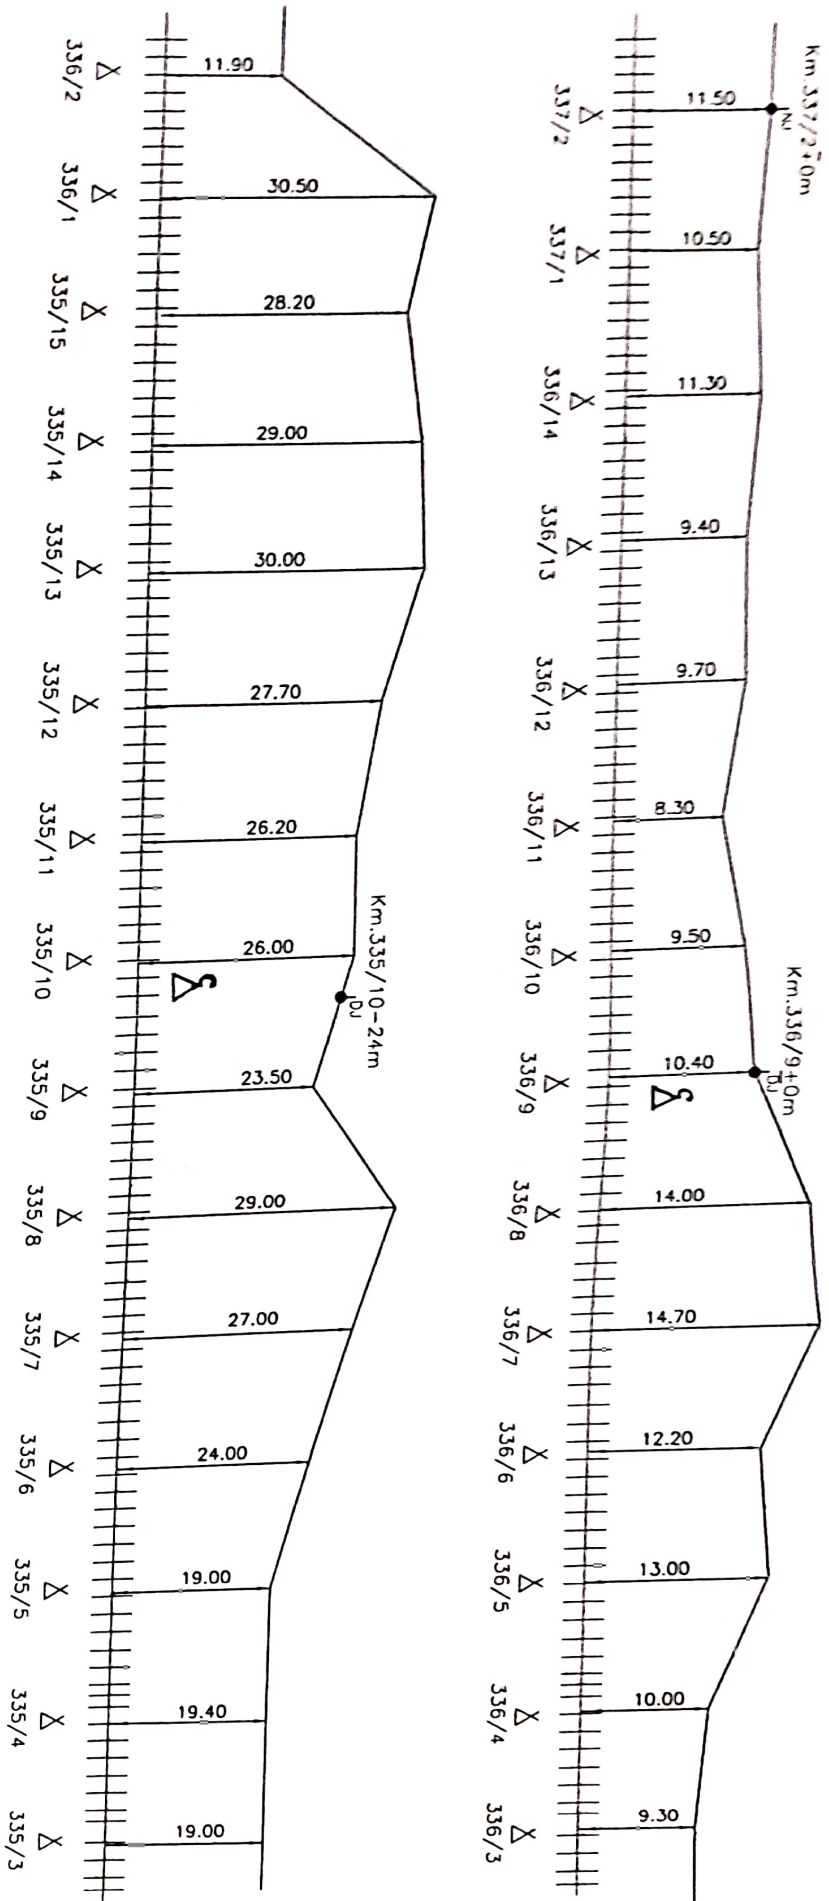

Contractor

SE/TELE/CON/GKP

ADSTE/CON/EAST/GKP

DY.CSTE/CON/EAST/GKP

Customer Name: N. E. RAILWAY
Prepared By: M/S ANUP KUMAR, DURGABARI ROAD, NEAR PAKI BAGH GATE, GORAKHPUR

1. JOINT MARKER	0 DU	DUCT JOINT MARKER	Σ	L.C. GATE PHONE	1 DU	DERIVATION JOINT	29	CREATED BY	AK	Location :-	GORAKHPUR - PANIVAHWA
RAILWAY CROSSING	++	RAILWAY TRACK	Δ	POLE	Δ	EMERGENCY POST		OFFERED BY	AK		
BRIDGE/CULVERT	□	G.I. PIPE	Δ	RAILWAY OVER BRIDGE	Δ	NORMAL JOINT		APPR BY	N E RLY		
Duct size	400mm	400mm	Δ	RAILWAY UNDER BRIDGE	Δ	6 QUAD CABLE		Ref no - NE/			


Not to Scale
All reading in mts

ROUTE PLAN FOR CHUGHULI - SISWABAZAR SECTION (6 QUAD CABLE)


← GKP

VKNR →

LC No. 24A'C'(U/M)
Km. 334/8-9

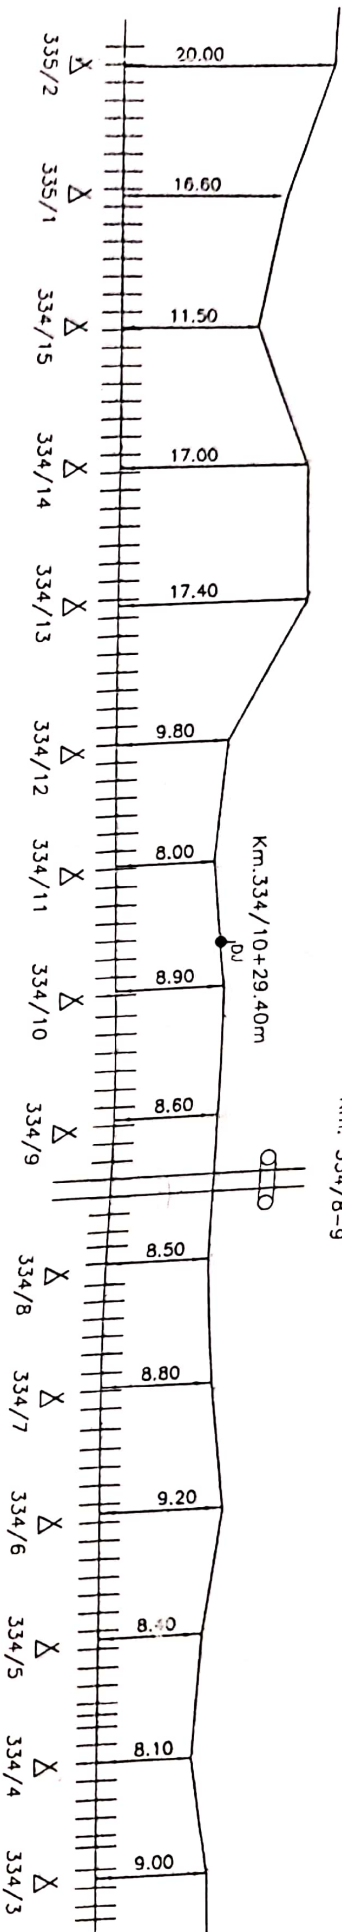

LC No. 25'C'(U/M)
Km. 334/0-1

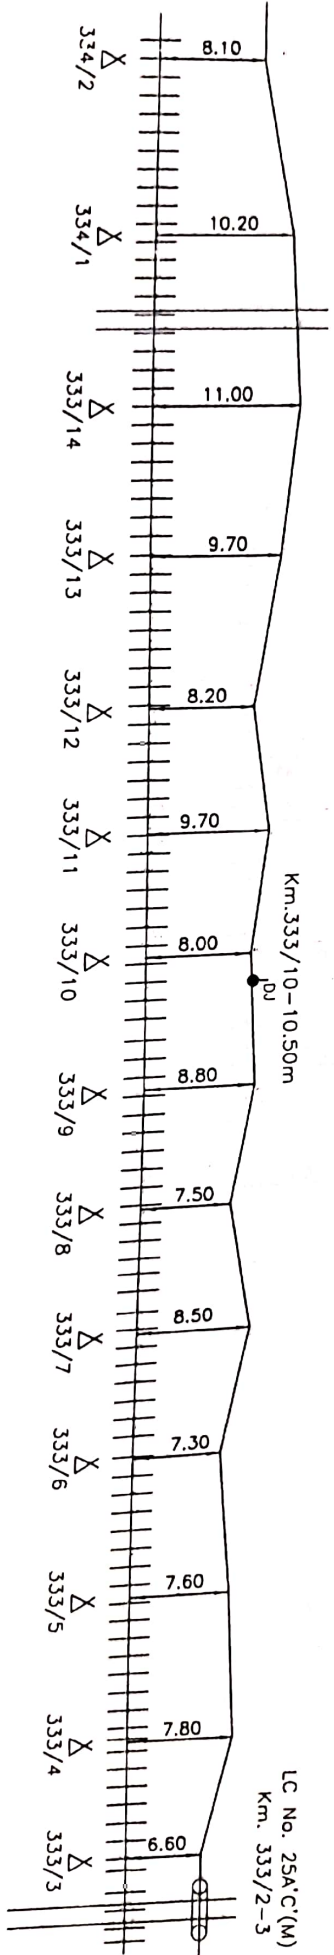

LC No. 25A'C'(M)
Km. 333/2-3

Signature
CONTRACTOR

Signature
SE/TELE/CON/GKP

Signature
ADSTE/CON/EAST/GKP

Signature
DY.CSTE/CON/EAST/GKP


1. T-JOINT MARKER	0 DU	DUCT JOINT MARKER	Σ	Σ	1 DU	DERIVATION JOINT	SHEET NO. 30	CREATED BY AK	Location :-
2. RAILWAY CROSSING	HH	RAILWAY TRACK	Δ	Δ	Δ	EMERGENCY POST	CREATED ON	OFFERED BY AK	GORAKHPUR -
3. BRIDGE/CULVERT	□	G.I. PIPE	Δ	Δ	Δ	RAILWAY OVER BRIDGE	R/SION NO	APPR. BY KERRY	PANIYAHWA
4. DUCT PIPE	□	HDPE	Δ	Δ	Δ	RAILWAY UNDER BRIDGE	MODIFIED ON	By no. - NE/	

Not to Scale
All reading in mts

↑
GAP


ROUTE PLAN FOR GHUGHULI - SISWABAZAR SECTION
(6 QUAD CABLE)

$V_{KNR} \rightarrow$

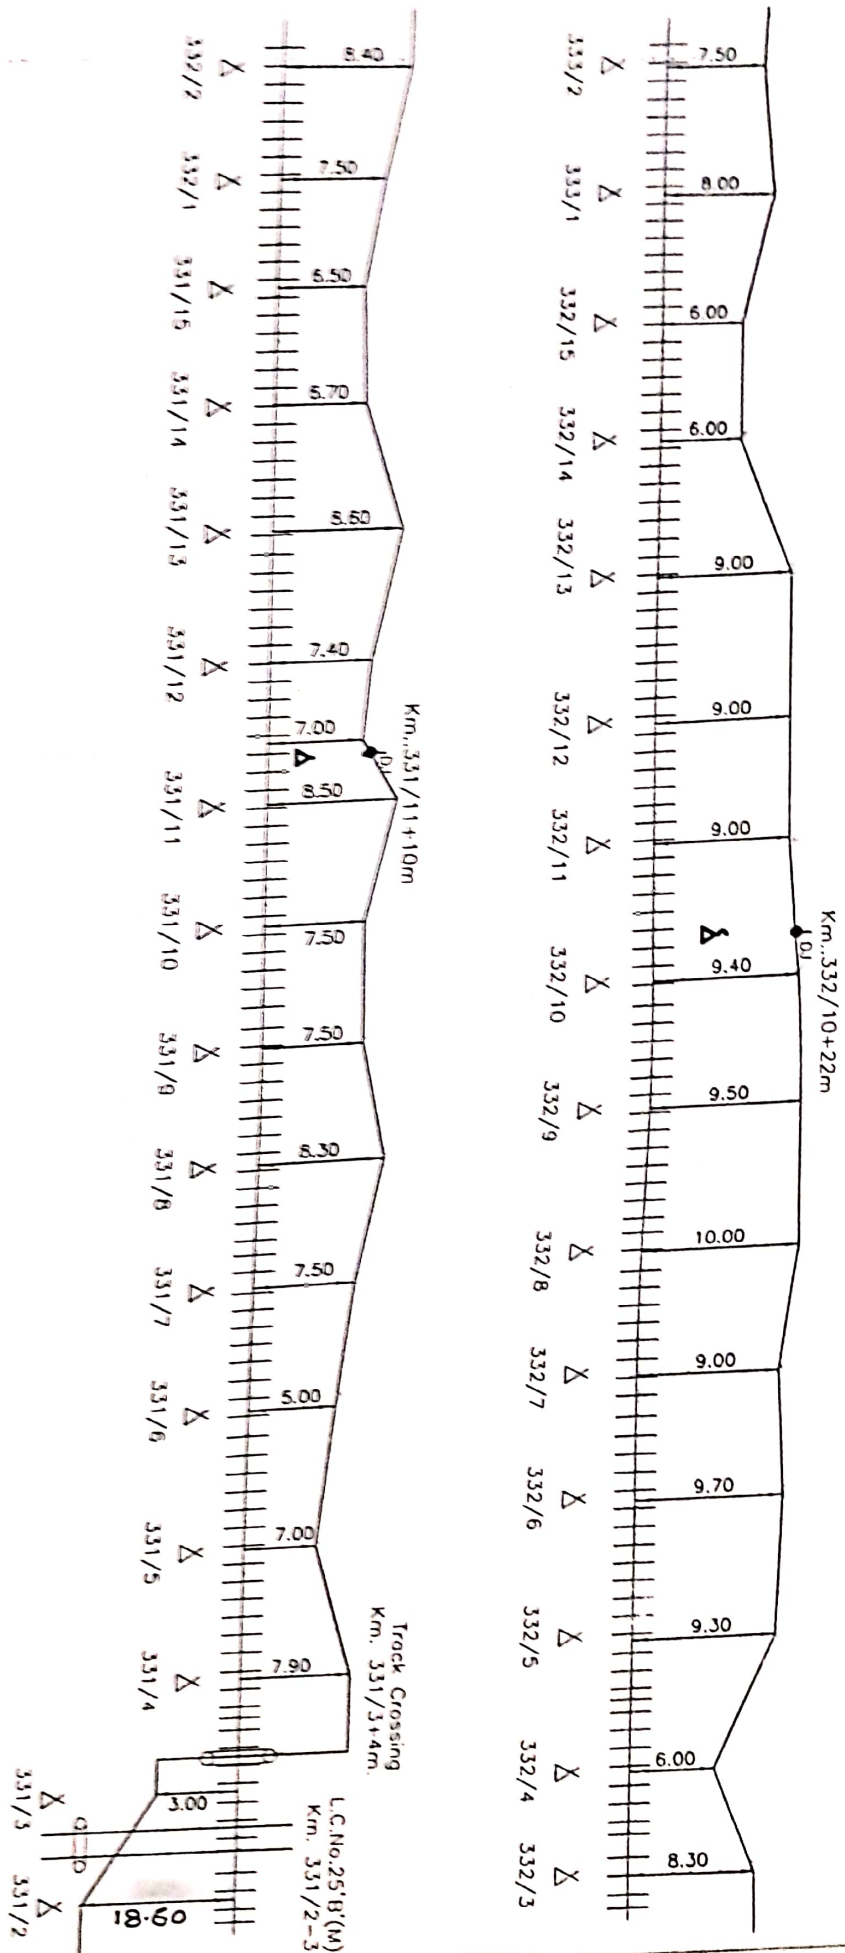


VKNR ↓

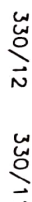

~~ADSTE/CON/EAST/GKP~~

DR. CSTE/CON/EAST/GKP

Not to Scale
All reading in mts



← GND

ROUTE PLAN FOR SISWABAZAR - KHADDA SECTION (6 QUAD CABLE)


VKNR →

LC No. 27'C(U/M)
Km. 328/15

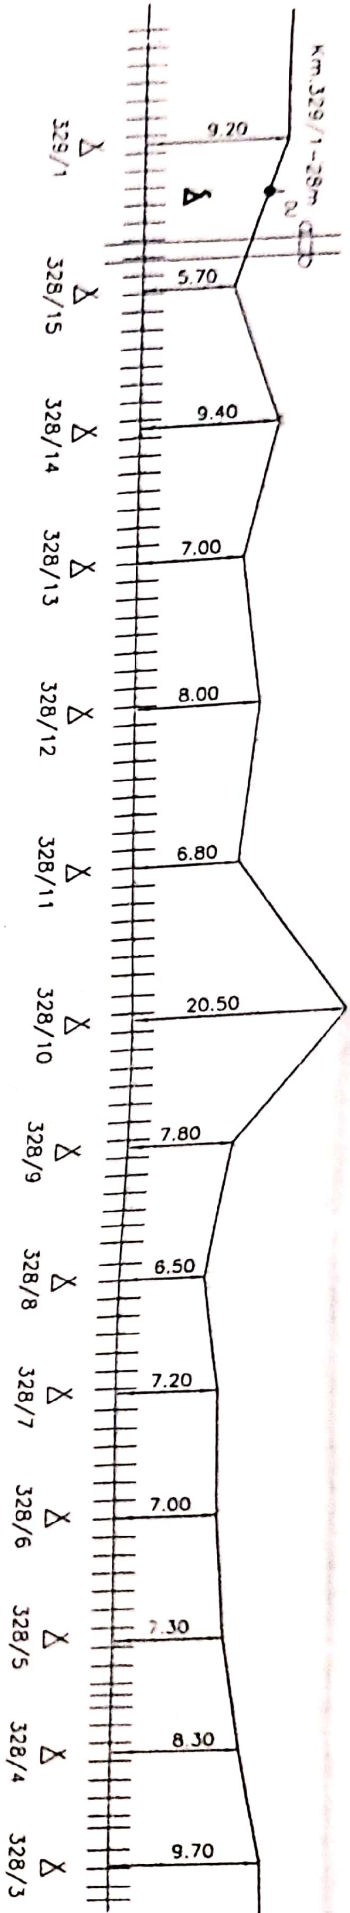

Km. 328/2-23m

LC No. 28'C(U/M)
Km. 327/7-8

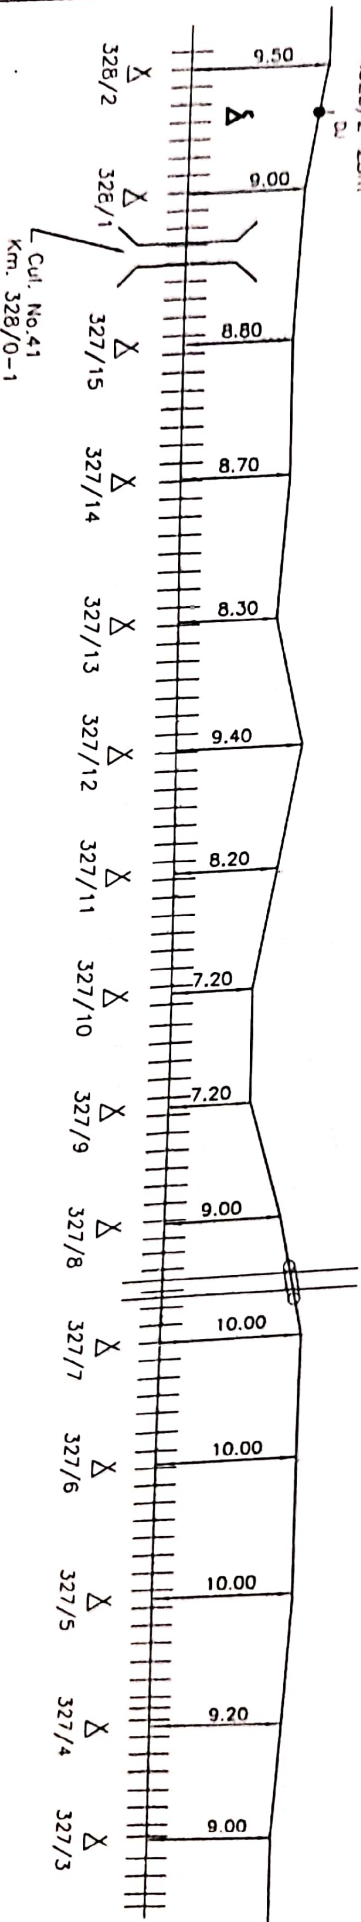

Anup Kumar

Selgappa

19/09/13

19/09/13

Not to Scale
All reading in mts


CONTRACTOR	SE/TELE/CON/GKP	ADSTE/CON/EAST/GKP	DR.CSTE/CON/EAST/GKP
1-JOINT MARKER	DU	L.C. GATE PHONE	DU
RAILWAY CROSSING	++	POLE	Δ
BRIDGE/CULVERT	□	RAILWAY OVER BRIDGE	●
DUCT PIPE		RAILWAY UNDER BRIDGE	—
	HDP		6 QUAD CABLE

Customer Name	N. E. RAILWAY
Prepared By :	M/S ANUP KUMAR, DURGABARI ROAD NEAR PAKKI BAGH GATE, GORAKHPUR
SHEET NO.	33
CREATED ON	CREATED BY AK
REVISION NO	OFFERED BY AK
MODIFIED ON	APPR. BY N E RLY
Ref no :- NE/	

Location :-	GORAKHPUR - PANIHAWA
-------------	----------------------

↑
28

↓


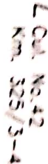



← GKP

ROUTE PLAN FOR SISWABAZAR - KHADDA SECTION (6 QUAD CABLE)

VKNR →

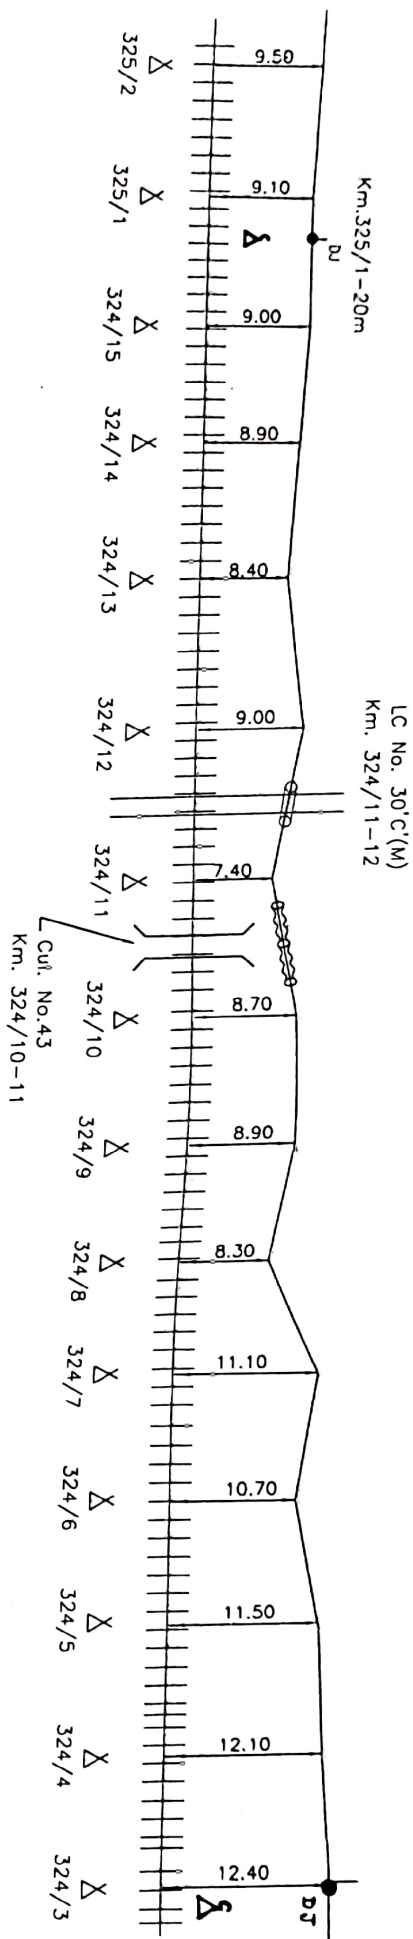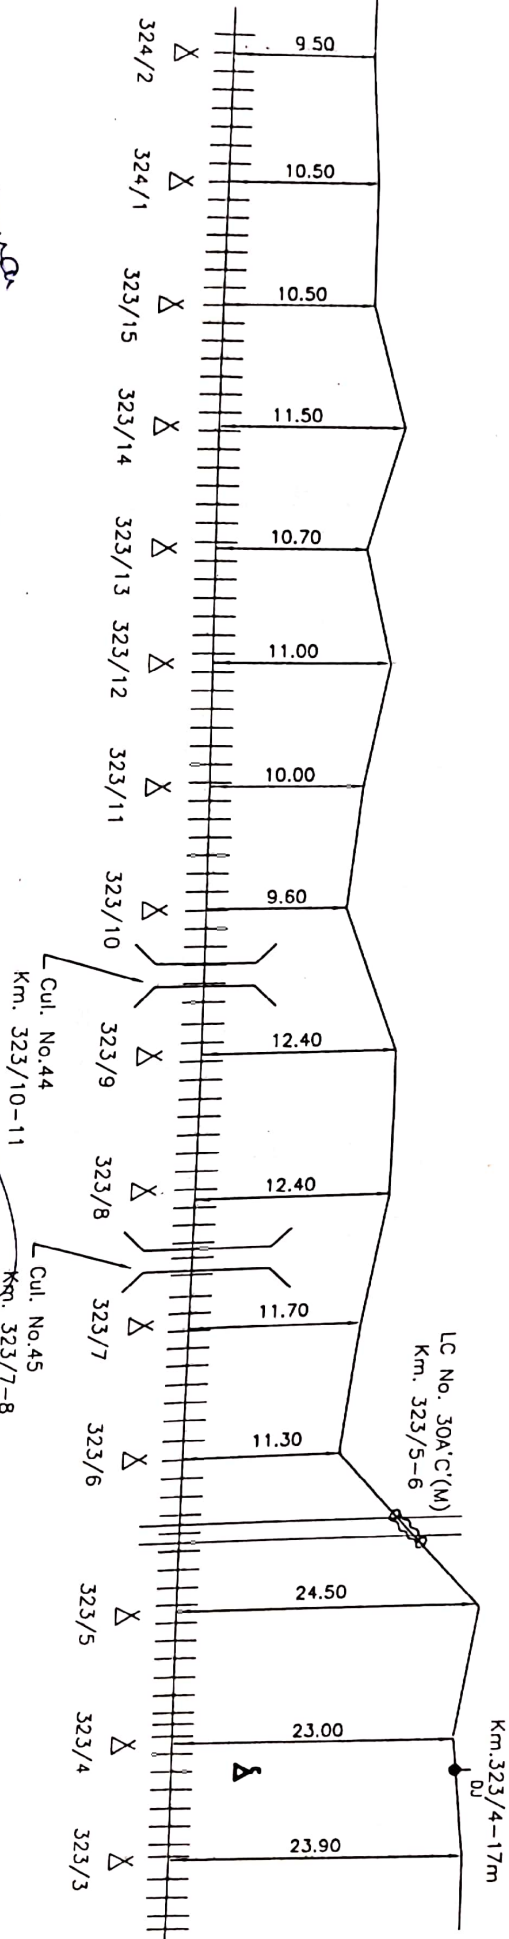

Contractor

SE/TELE/CON/GKP

ADJST/CON/EAST/GKP

DY. SITE/CON/EAST/GKP


Not to Scale
All reading in mts

1-JOINT MARKER	0 DU	DUCT JOINT MARKER	23	L.C. GATE PHONE	DU	DERIVATION JOINT	SHEET NO. 35	CREATED BY AK	Location : -- GORAKHPUR - PANITYAHWA
RAILWAY CROSSING	11	RAILWAY TRACK	Δ	POLE	Δ	EMERGENCY POST	CREATED ON	OFFERED BY AK	
BRIDGE/CULVERT	11	C.I. PIPE	Δ	RAILWAY OVER BRIDGE	Δ	NORMAL JOINT	REVISION NO	APPR BY N.E.R.	
DUCT PIPE	11	HDPPE	≡≡	RAILWAY UNDER BRIDGE	≡≡	6 QUAD CABLE	MODIFIED ON	Ref no - NE/	

ROUTE PLAN FOR SISWABAZAR - KHADDA SECTION (6 QUAD CABLE)

← GKP

VKNR →

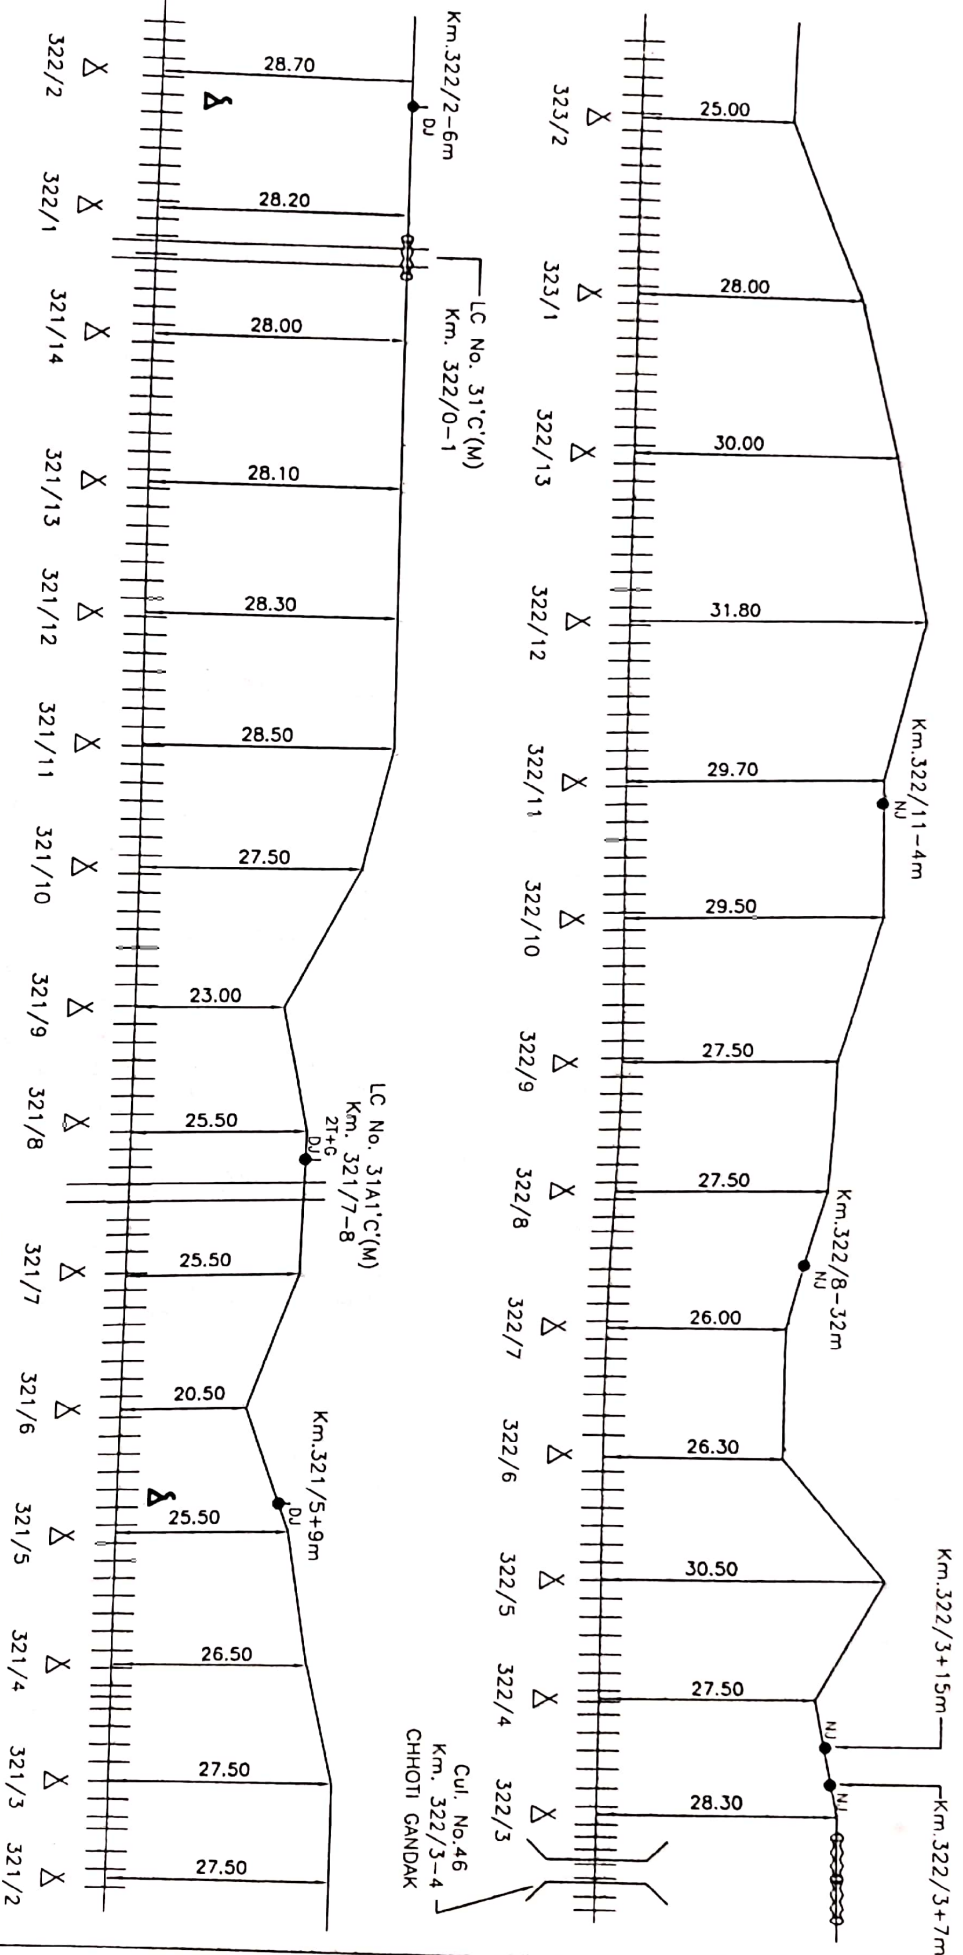

Amphur

Sebastian

12/3/13

ADSTE/CON/EAST/GKP

DR.CSTE/CON/EAST/GKP


Not to Scale

All reading in mts

Customer Name	Prepared By :	W/S ANUP KUMAR, DURGABARI ROAD, NEAR PAKKI BACH GATE, GORAKHPUR
SHEET NO. 36	CREATED BY AK	OFFERED BY AK
CREATED ON	APPR. BY N.E.RLY	REVISION NO.
MODIFIED ON	Qd. No. - NE/	

Location :- GORAKHPUR - PANIYAHWA

ROUTE PLAN FOR SISWABAZAR - KHADDA SECTION (6 QUAD CABLE)

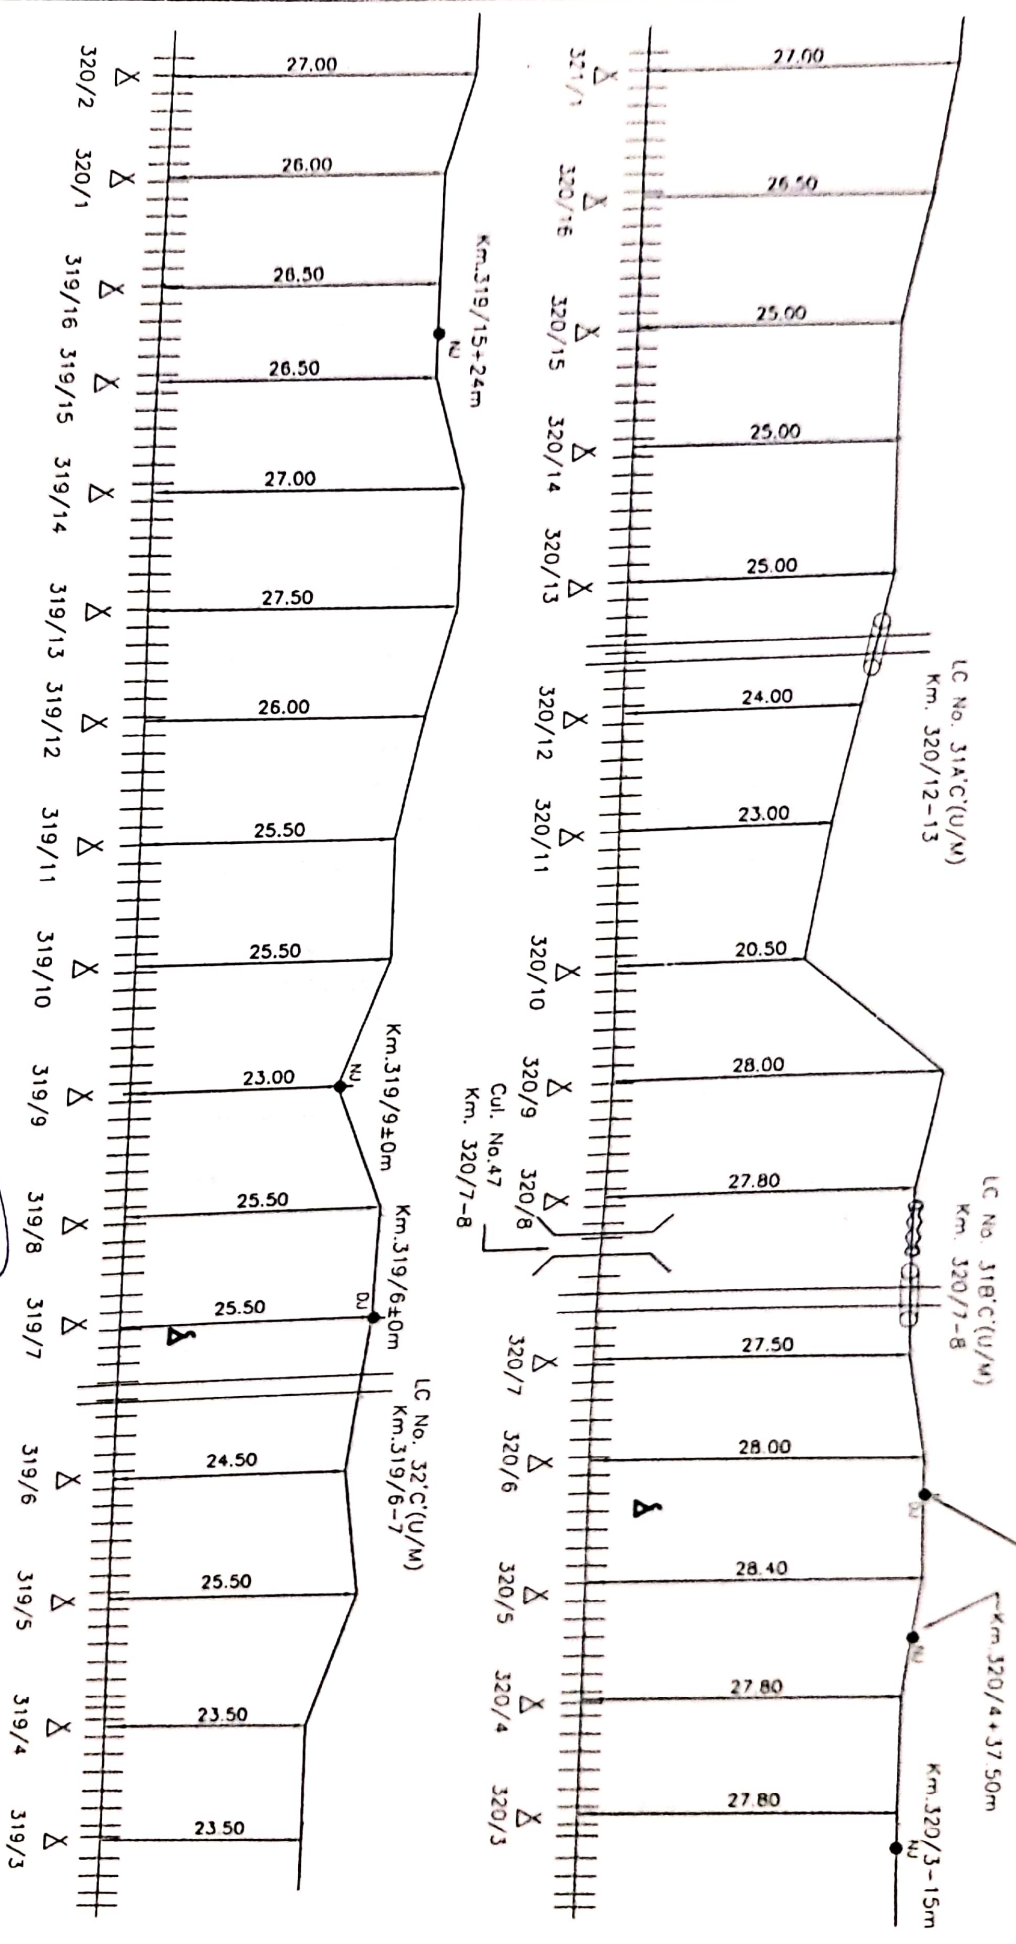


CONTRACTOR		SE/TELE/CON/GKP		ADSITE/CON/EAST/GKP		DY/CSIE/CON/EAST/GKP	
1-JOINT MARKER	0 DU	DUCT JOINT MARKER	0 DU	L.C. GATE PHONE	0 DU	DERIVATION JOINT	0 DU
RAILWAY CROSSING	##	RAILWAY TRACK	##	POLE	##	EMERGENCY POST	##
BRIDGE/CULVERT	□	G.I. PIPE	□	RAILWAY OVER BRIDGE	□	NORMAL JOINT	□
DUCT PIPE	□	HOPE	□	RAILWAY UNDER BRIDGE	□	6 QUAD CABLE	□

Customer Name		N. E. RAILWAY	
Prepared By :	M/S ANUP KUMAR, DURGABARI ROAD, NEAR PAKKI BAGH GATE, GORAKHPUR		
SHEET NO.	37	CREATED BY	AK
CREATED ON		OFFERED BY	AK
REVISION NO.		APPROVED BY	AK
Location :-		GORAKHPUR - PANITYAHWA	

← GKP

ROUTE PLAN FOR SISWABAZAR - KHADDA SECTION (6 QUAD CABLE)

VKNR →

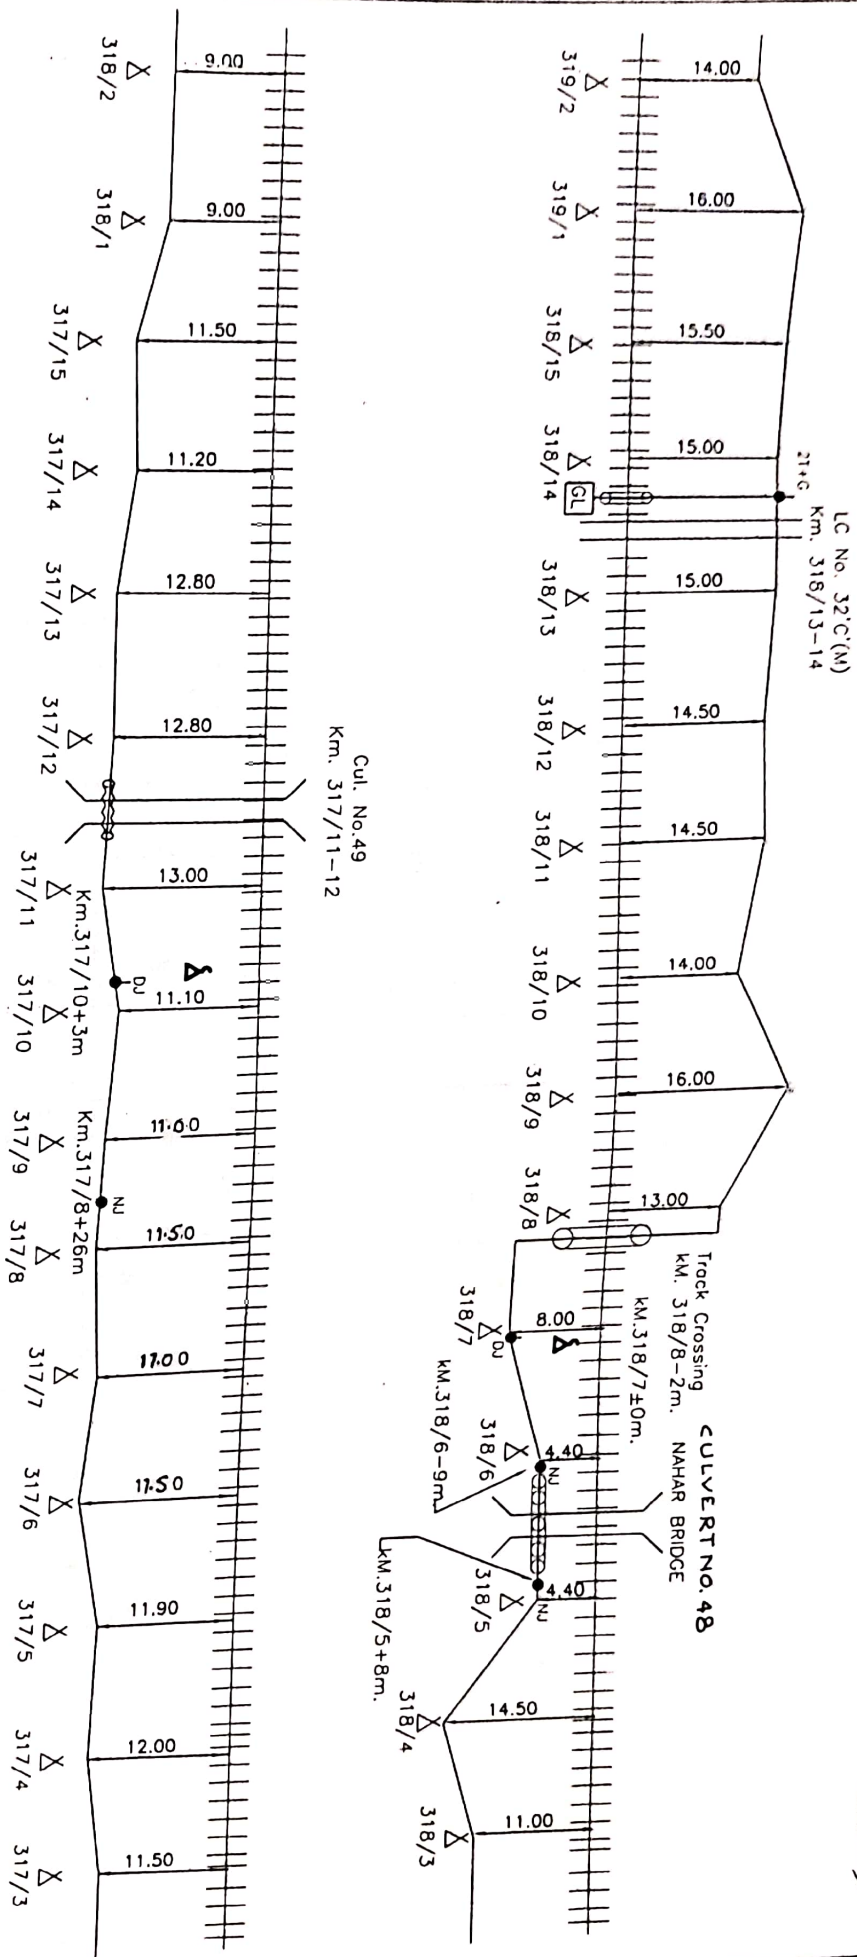

Cul. No. 49
Km. 317/11-12

Track Crossing
Km. 318/8-2m.
NAHAR BRIDGE
CULVERT NO. 48
Km. 318/7+0m.

Km. 318/5+8m.

CONTRACTOR
Deep Kumar

SE/TELE/CON/GKP
Se. S. S. S.

A.DSTE/CON/EAST/GKP

DY.CSTE/CON/EAST/GKP

Not to Scale
All reading in mts

1- JOINT MARKER	0 DJ	DUCT JOINT MARKER	23	L.C. GATE PHONE	1	DERIVATION JOINT	38	CREATED BY	AK	Location : --
RAILWAY CROSSING	++	RAILWAY TRACK	Δ	POLE	Δ	EMERGENCY POST	CREATED ON	OFFERED BY	AK	GORAKHPUR -
BRIDGE/CULVERT	□	G.I. PIPE	Δ	RAILWAY OVER BRIDGE	Δ	NORMAL JOINT	REVISION NO	APPR. BY	N.E.R.V.	PANIYAHWA
DUCT PIPE	□	HDPF	Δ	RAILWAY UNDER BRIDGE	Δ	6 QUAD CABLE	MODIFIED ON			

Customer Name
Prepared By : M/S ANUP KUMAR, DURGABARI ROAD, NEAR PAKKI BACH GATE, GORAKHPUR

N. E. RAILWAY

Location : --

GORAKHPUR -

PANIYAHWA



APPR. BY

N.E.R.V.

← GKP

ROUTE PLAN FOR SISWABAZAR - KHADDA - PANYAHWA SECTION (6 QUAD CABLE)

VKNR →

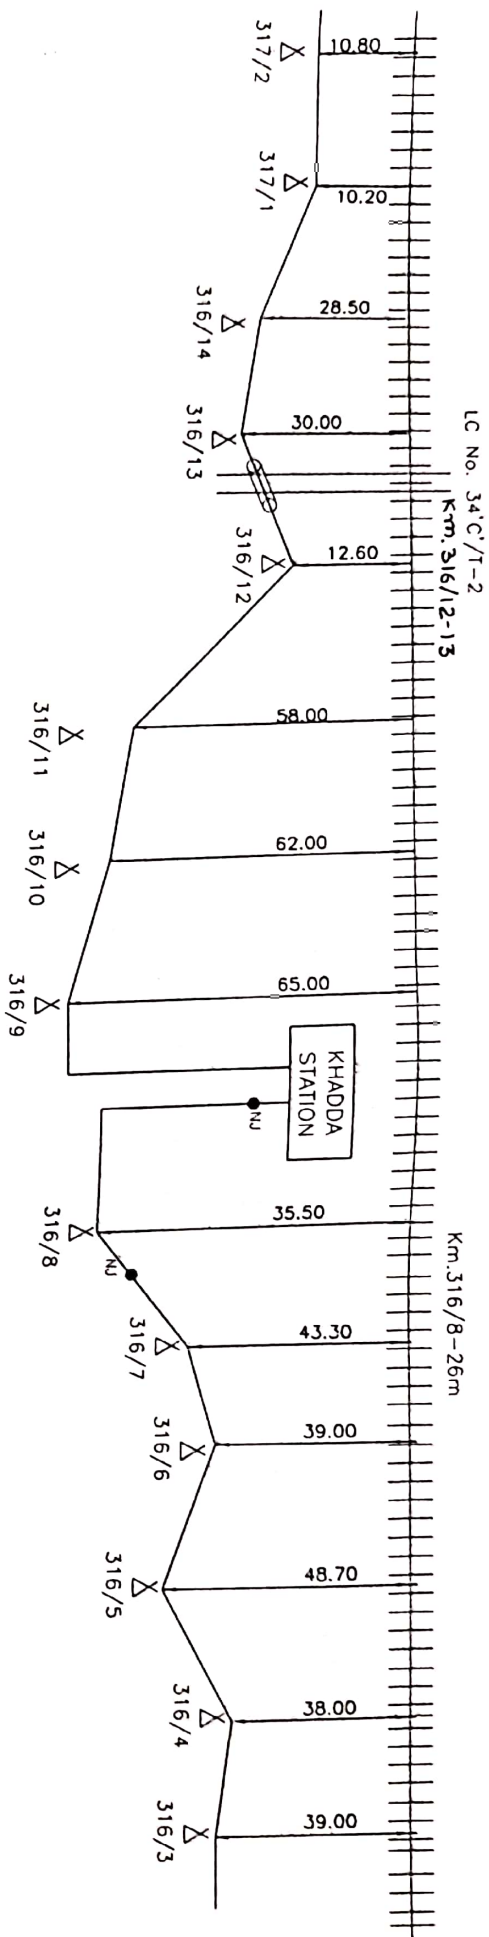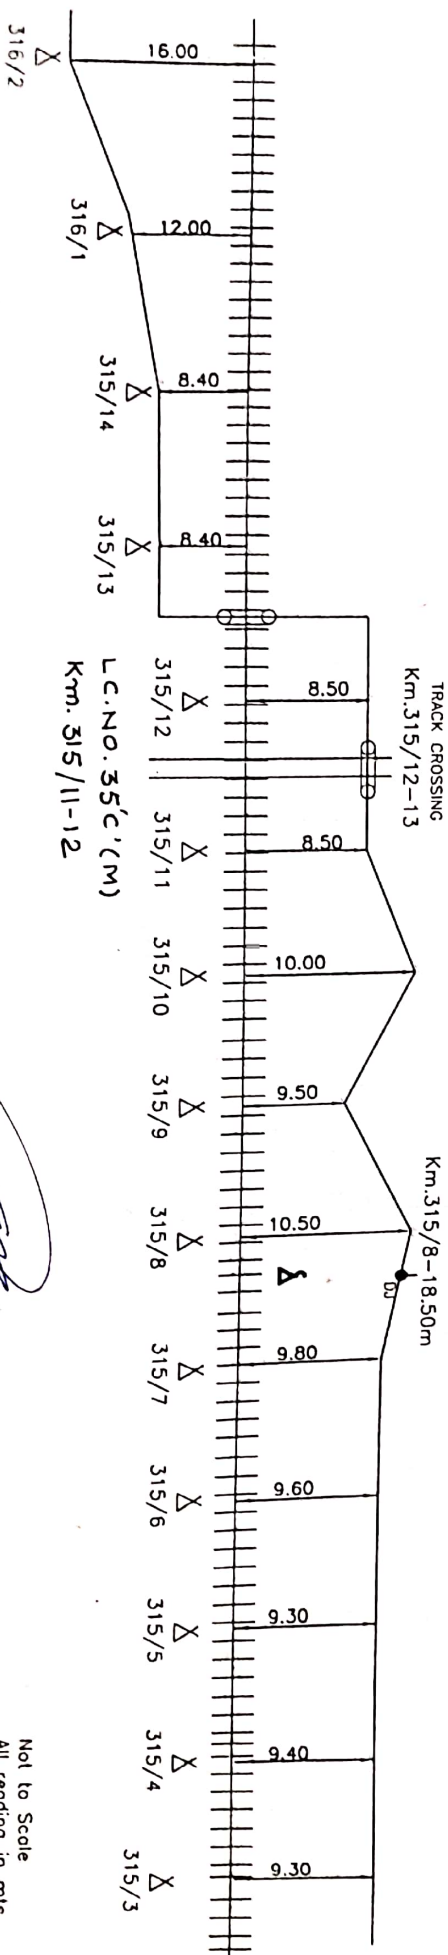

CONTRACTOR

SE/TELE/CON/GKP

ADSTE/CON/EAST/GKP

DY/STE/CON/EAST/GKP

N. E. RAILWAY

Customer Name: M/S ANUP KUMAR, DURGABATI ROAD NEAR PAKKI BAGH GATE, GORAKHPUR

Prepared By: M/S ANUP KUMAR, DURGABATI ROAD NEAR PAKKI BAGH GATE, GORAKHPUR

SHEET NO. 39

CREATED ON: 14/07/13

OFFERED BY: AK

APPR BY: ME/RY

REVISION NO.

NOTED ON: 14/07/13

DY/STE/CON/EAST/GKP

ADSTE/CON/EAST/GKP

SE/TELE/CON/GKP

CONTRACTOR






























Sebaton

1347813
SE/TELE/CON/GKP

~~MSIE/CON/EAST/GKP~~ 7.13

11/6/97
DY.CSTE/CON/EAST/GKP


10/3/13

Not to Score
All reading in mls

← GKP

ROUTE PLAN FOR KHADDA - PANIYAHWA SECTION (6 QUAD CABLE)

VKNR →

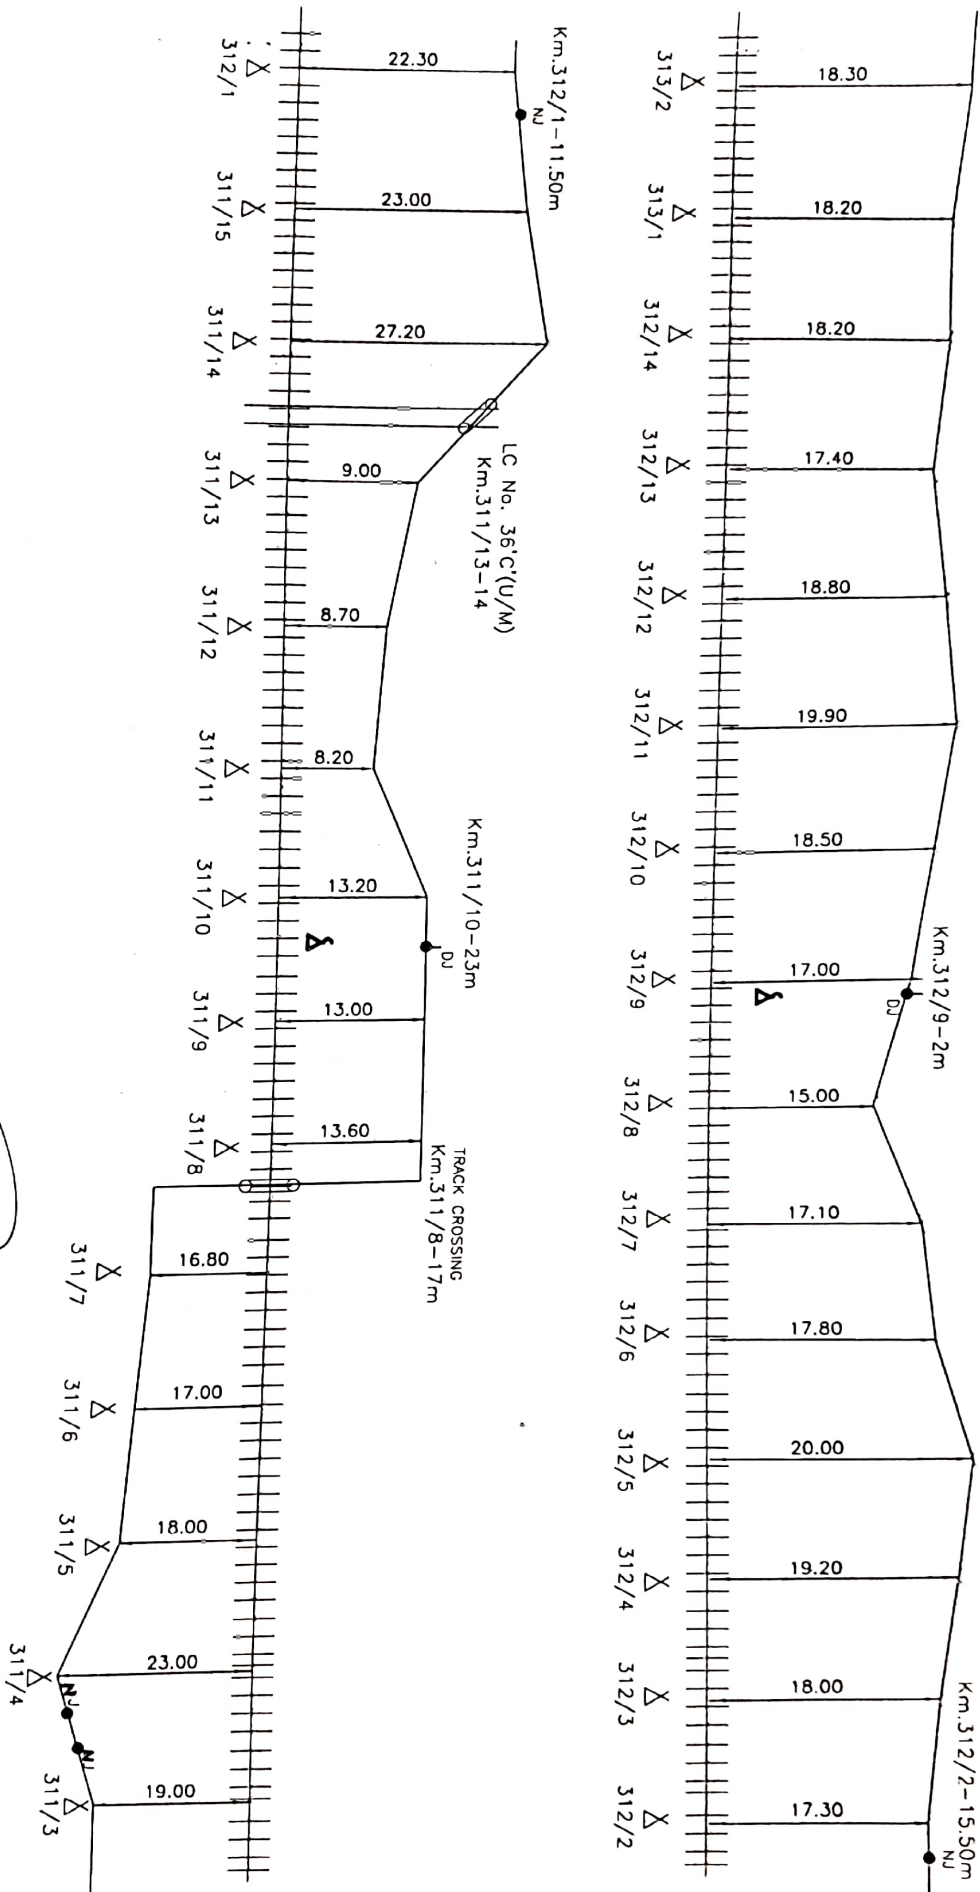

Prakash Kumar
CONTRACTOR

Sebastian
SE/TELE/CON/GKP

Pot 13
ADSTE/CON/EAST/GKP

18/03/13
DY. CSTE/CON/EAST/GKP

1- JOINT MARKER	DU	DUCT JOINT MARKER	ADSTE/CON/EAST/GKP	DY. CSTE/CON/EAST/GKP	Customer Name	N. E. RAILWAY
RAILWAY CROSSING	HH	RAILWAY TRACK			Prepared By :	M/S ANUP KUMAR, DURGABARI ROAD NEAR PAKKI BAGH GATE, GORAKHPUR
BRIDGE/CULVERT	DD	C.I. PIPE			SHEET NO.	41
DUCT PIPE	CC	PIPE			CREATED ON	AK
					OFFERED BY	AK
					APPR. BY	NEELV
					MODIFIED ON	
						Location : -- GORAKHPUR - PANIYAHWA

Not to Scale
All reading in mts




ROUTE PLAN FOR KHADDA - PANIYAHWA - VALMIKI NAGAR SECTION (6 QUAD CABLE)

GKP ←

LC No. 36X'C(U/M)
Km. 310/12-13



→ VKNR

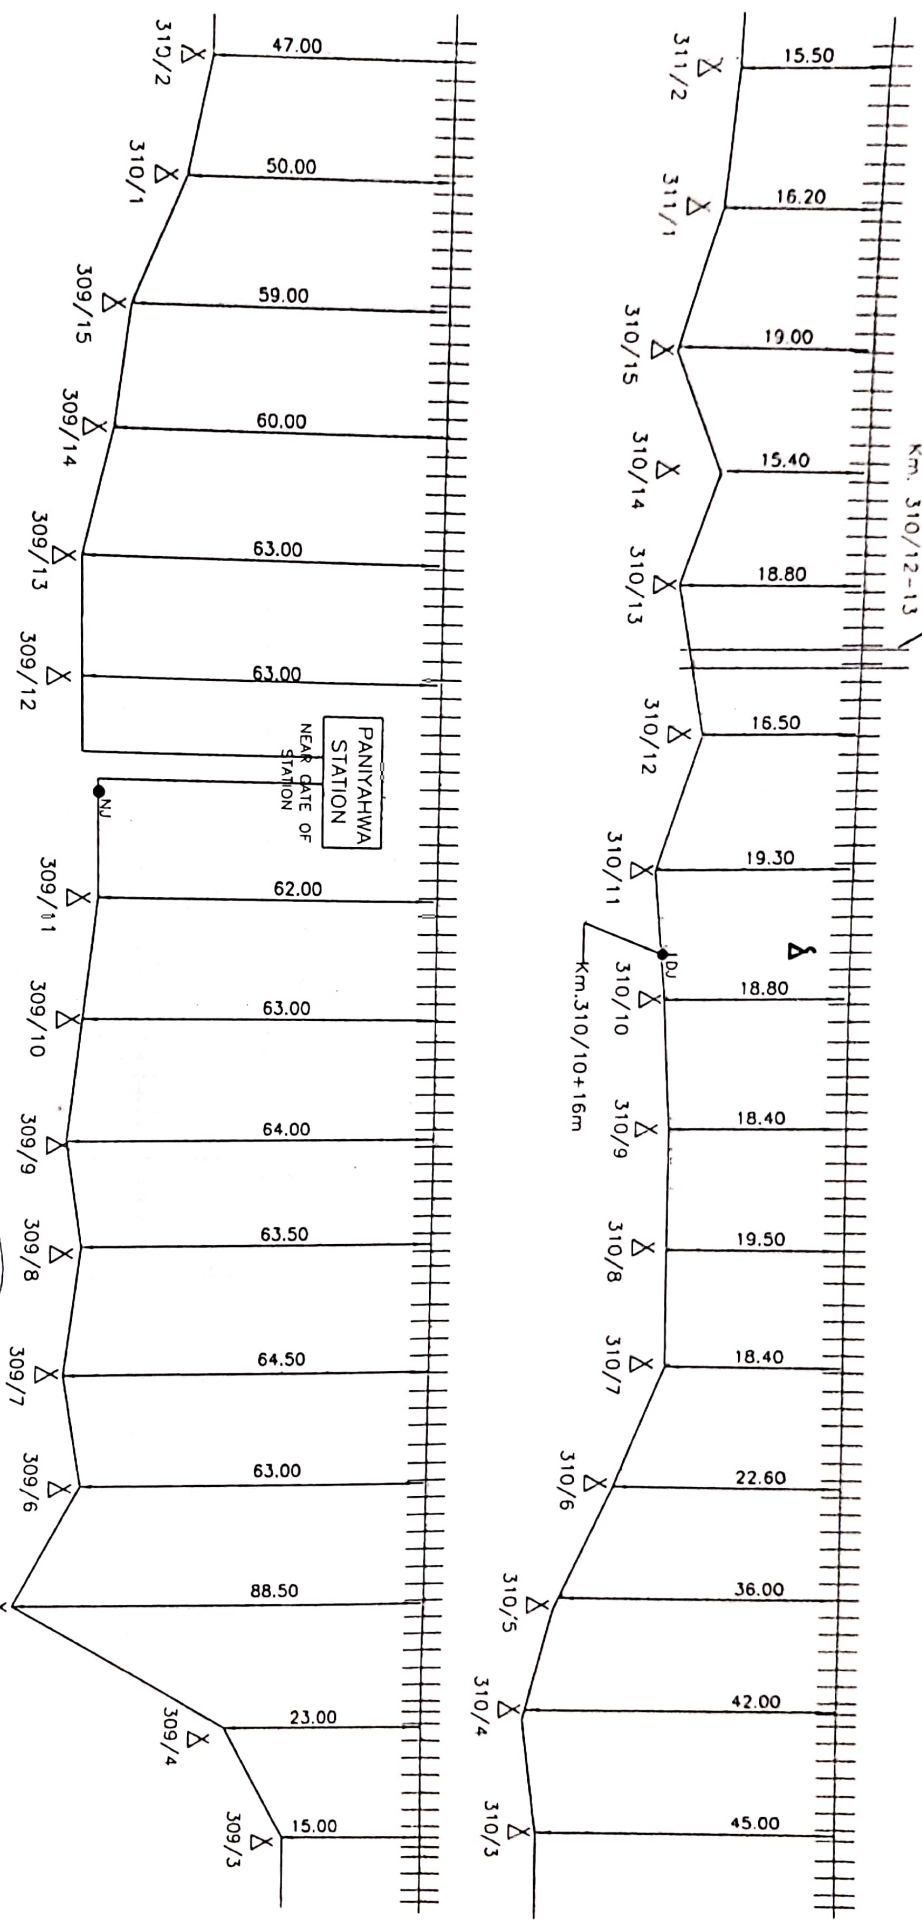

Not to Scale
All reading in mts

CONTRACTOR		SE/TELE/CON/GKP		ADSTE/CON/EAST/GKP		DY.CSTE/CON/EAST/GKP		Customer Name		M/S ANUP KUMAR DURGABARI ROAD NEAR PAKKI BAGH GATE.		Location : -- GORAKHPUR - PANIYAHWA	
T-JOINT MARKER		DUCT JOINT MARKER		L.C. GATE PHONE		DERIVATION JOINT		SHEET NO.		42		CREATED BY	
RAILWAY CROSSING		RAILWAY TRACK		POLE		EMERGENCY POST		CREATED ON				OFFERED BY	
BRIDGE/CULVERT		C.I. PIPE		RAILWAY OVER BRIDGE		NORMAL JOINT		REVISION NO.				APPR BY	
DUCT PIPE		UNDER		RAILWAY UNDER BRIDGE		6 QUAD CABLE		WORKED ON				N E RLY	

VKNR ↓

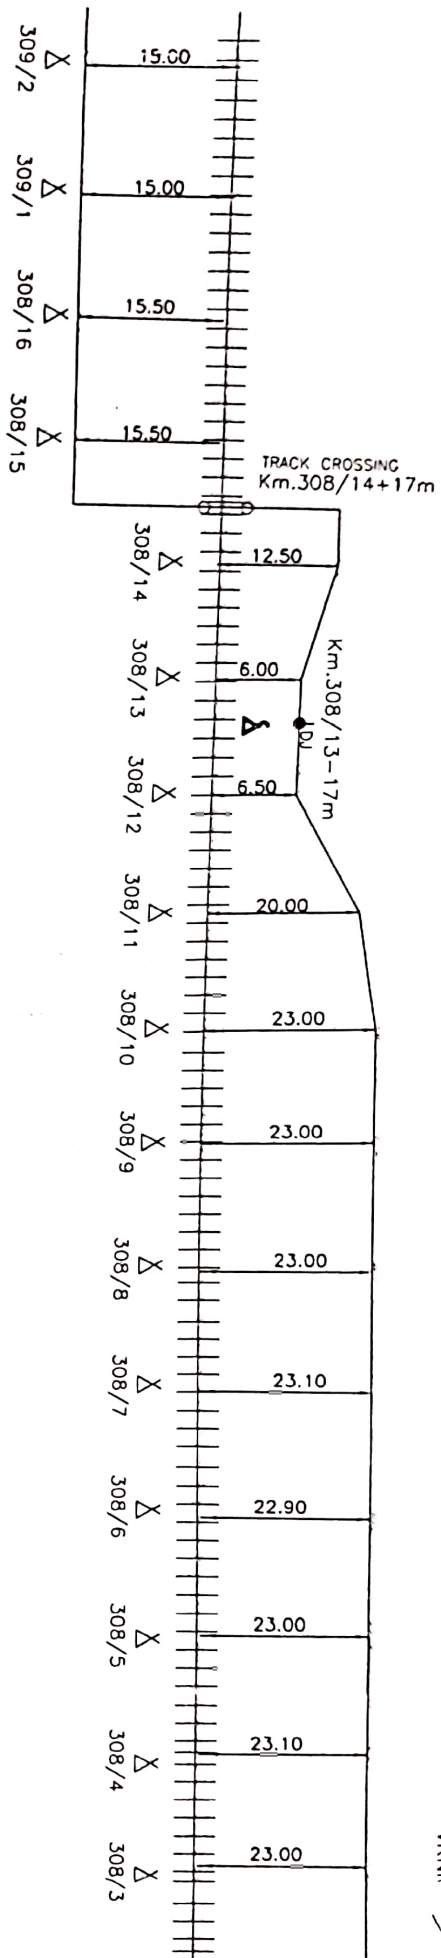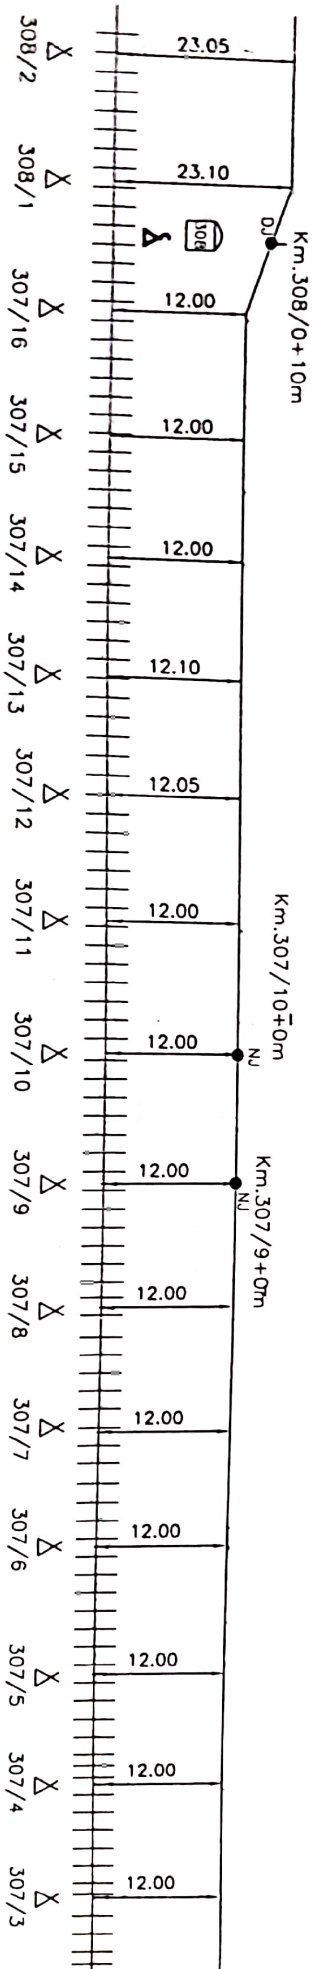

All reading in mls



10/07/13
DY.CSTE/CON/EAST/GKP

1. JOINT MARKER	0 DU	DUCT JOINT MARKER			L.C. GATE PHONE	DERIVATION JOINT	SHEET NO.	43	CREATED BY	AK	Location :- GORAKHPUR - PAINYAHWA
H RAILWAY CROSSING	HH	RAILWAY TRACK	Λ		POLE	EMERGENCY POST	CREATED ON		OFFERED BY	AK	
C BRICK / CULVERT	CD	G.I PIPE	⋈		RAILWAY OVER BRIDGE	NORMAL JOINT	REVISION NO		APPR BY	N E RLY	
DUCT MARKER	DD	DUCT	≡		RAILWAY UNDER BRIDGE	6 QUAD CABLE	MODIFIED ON		Ref no :-	NE/	

← GKP

ROUTE PLAN FOR PANIYAHWA - VALMIKI NAGAR SECTION (6 QUAD CABLE)


VKNR →

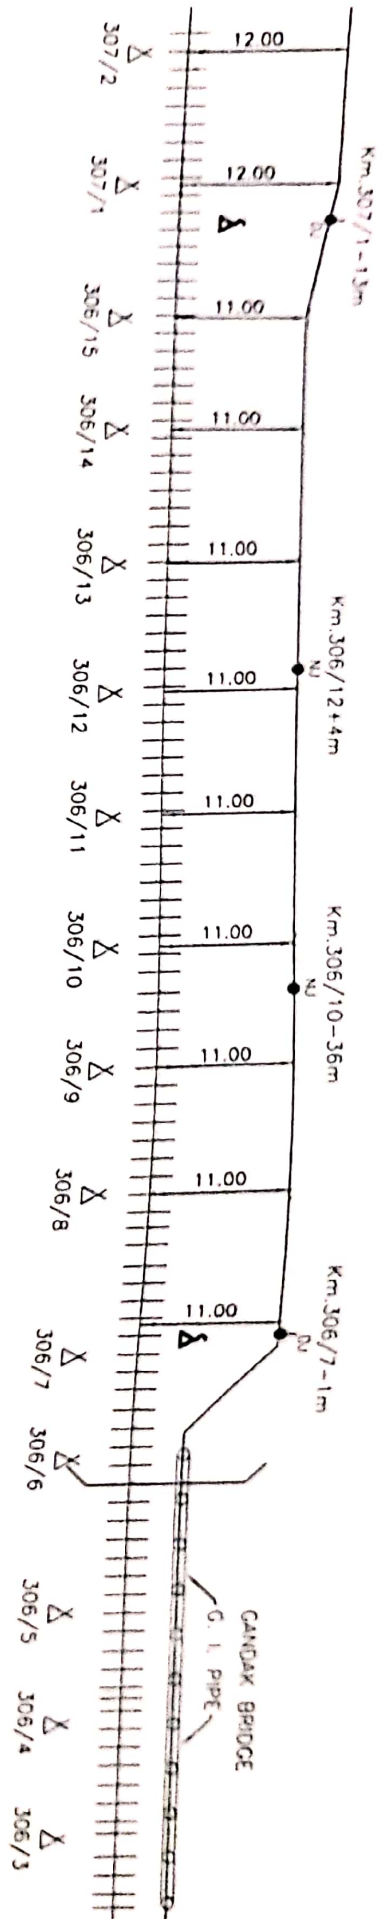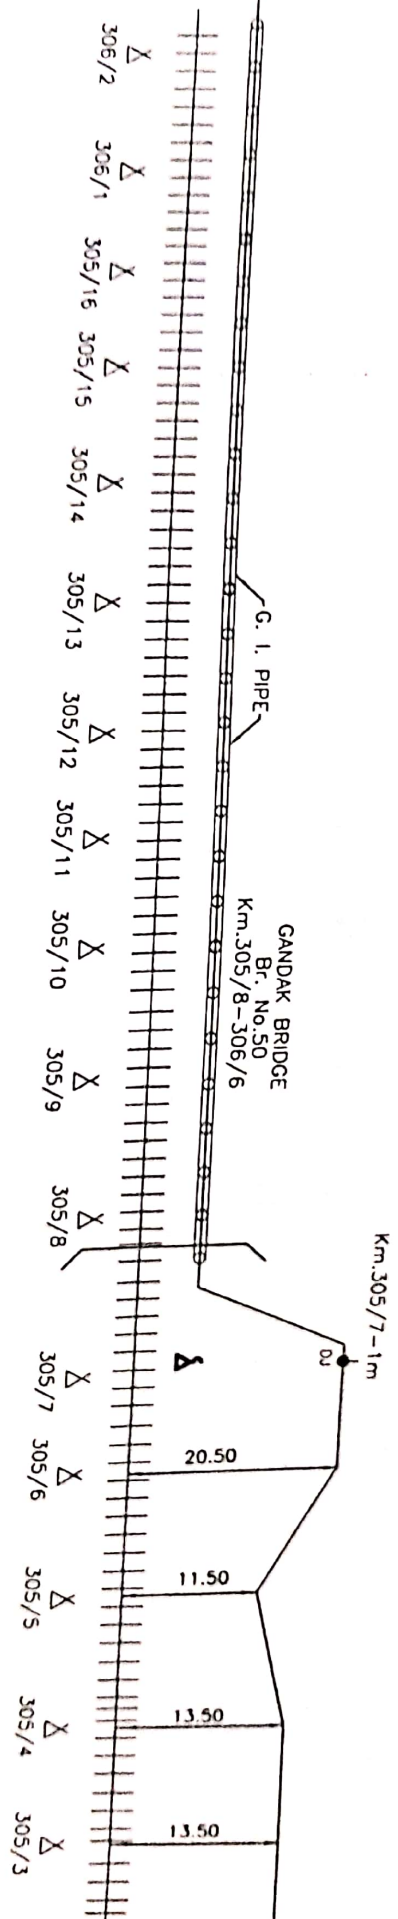

CONTRACTOR		SE/TELE/CON/GKP		ADSTE/CON/EAST/GKP		DY.CSITE/CON/EAST/GKP	
RAILWAY CROSSING		RAILWAY TRACK		RAILWAY OVER BRIDGE		RAILWAY UNDER BRIDGE	
BRIDGE/CULVERT		C.I. PIPE		RAILWAY OVER BRIDGE		RAILWAY UNDER BRIDGE	
DUCT JOINT MARKER		DUCT JOINT MARKER		L.C. GATE PHONE		DERIVATION JOINT	
EMERGENCY POST		NORMAL JOINT		CREATED ON		OFFERED BY	
REVISION NO		APPROVED BY		N. E. RAILWAY		GORAKHPUR	
Customer Name		W/S ANUP KUMAR DURGABAI ROAD NEAR PAKKI BAGH GATE.		Location :-		GORAKHPUR - PANIYAHWA	
Prepared By :		44		CREATED BY		AK	
SHEET NO		44		OFFERED BY		AK	
REVISION NO		APPROVED BY		N. E. RAILWAY		GORAKHPUR	

Not to Scale
All reading in mts

↑
GGG

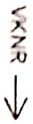

Arup
CONTRACTOR

Schäfer

SE/TELE/CON/GKP

17.7.13

16091

16/07/13

Not to Scale
All reading in mts



Customer Name	N. E. RAILWAY
Prepared By :	M/S ANUP KUMAR, DURGABARI ROAD, NEAR PAKKI BACH GATE GORAKHPUR

Location :--

ROUTE PLAN FOR PANIYAHWA - VALMIKI NAGAR SECTION (6 QUAD CABLE)

← GKP

VKNR →

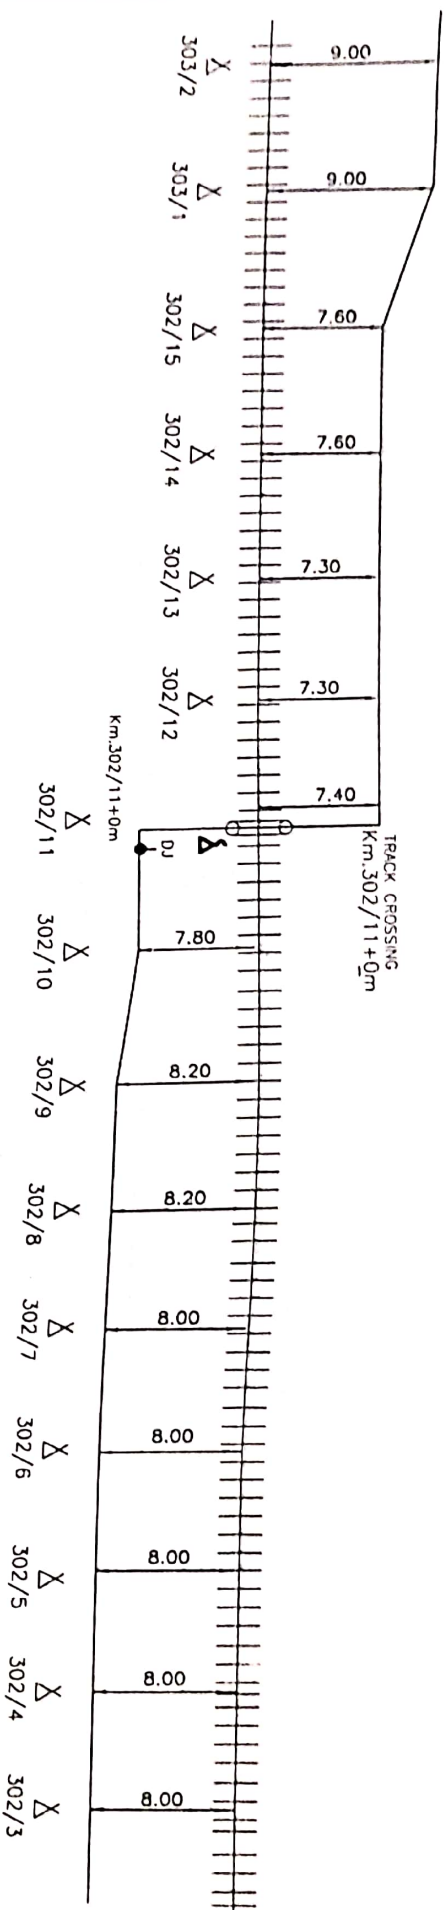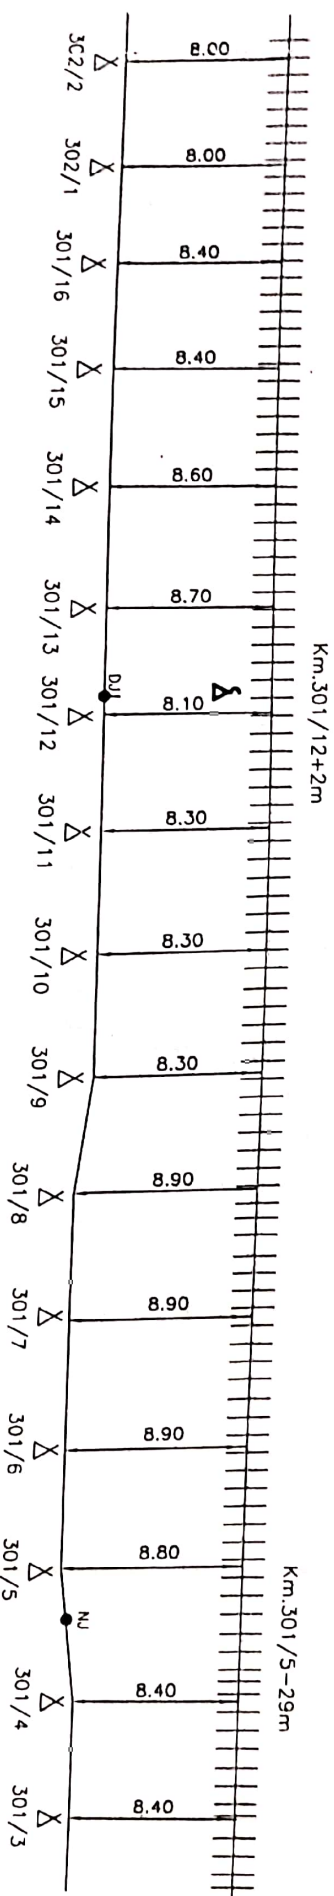

Contractor: Anup Kumar
SE/TELE/CON/GKP: 13/3/13
ADSITE/CON/EAST/GKP: 13/3/13
DY.CSTE/CON/EAST/GKP: 13/3/13

Customer Name		N. E. RAILWAY	
Prepared By :	M/S ANUP KUMAR, DURGABARI ROAD, NEAR PAKKI BAGH GATE, GORAKHPUR	CREATED BY :	AK
SHEET NO. :	46	OFFERED BY :	AK
CREATED ON :		APPE BY :	N. E. RLY
MODIFIED ON :		REVISION NO. :	

Location : --- GORAKHPUR - PANIYAHWA

Not to Scale
All reading in mts

CONTRACTOR		SE/TELE/CON/GKP		ADSITE/CON/EAST/GKP		DY.CSTE/CON/EAST/GKP	
1. T-JOINT MARKER	0	DU	RAILWAY TRACK	2. L.C. GATE PHONE	DU	DERIVATION JOINT	
2. BRIDGE/CULVERT	0	C.I. PIPE		3. POLE	DU	EMERGENCY POST	
3. DUCT PIPE	0	HDPE		4. RAILWAY OVER BRIDGE	DU	NORMAL JOINT	
				5. RAILWAY UNDER BRIDGE			



6 QUAD CABLE



← GKP

ROUTE PLAN FOR PANIYAHWA - VALMIKI NAGAR SECTION (6 QUAD CABLE)

→ VKNR

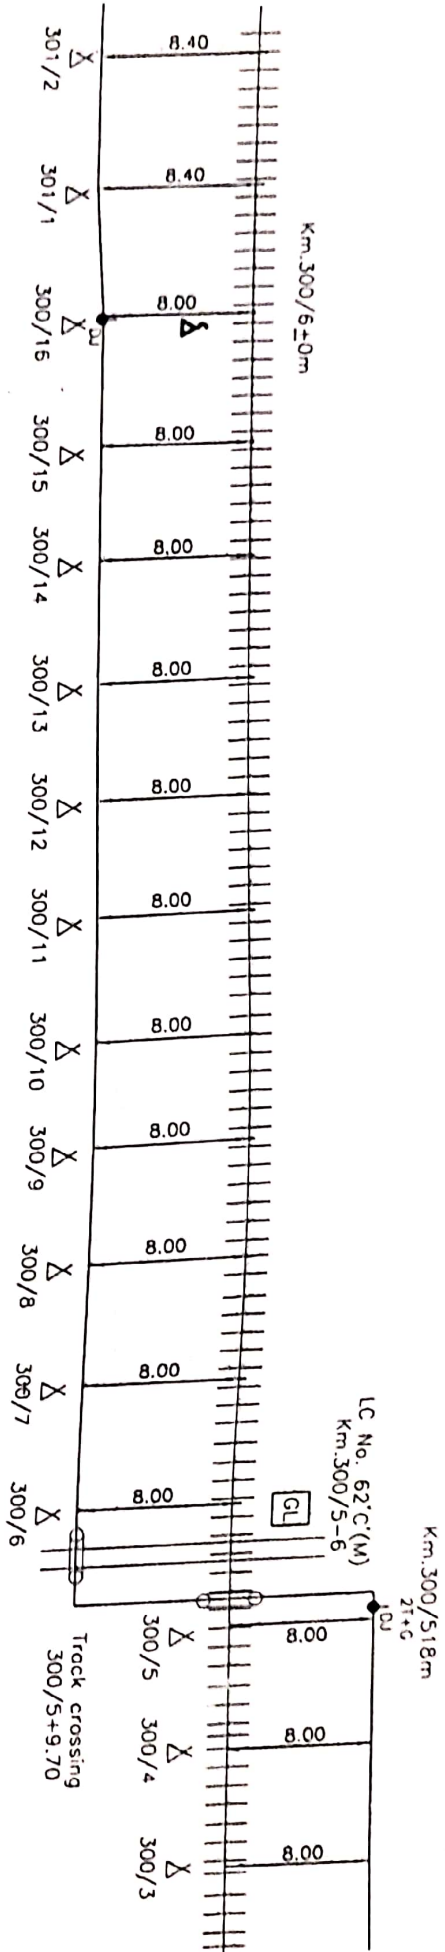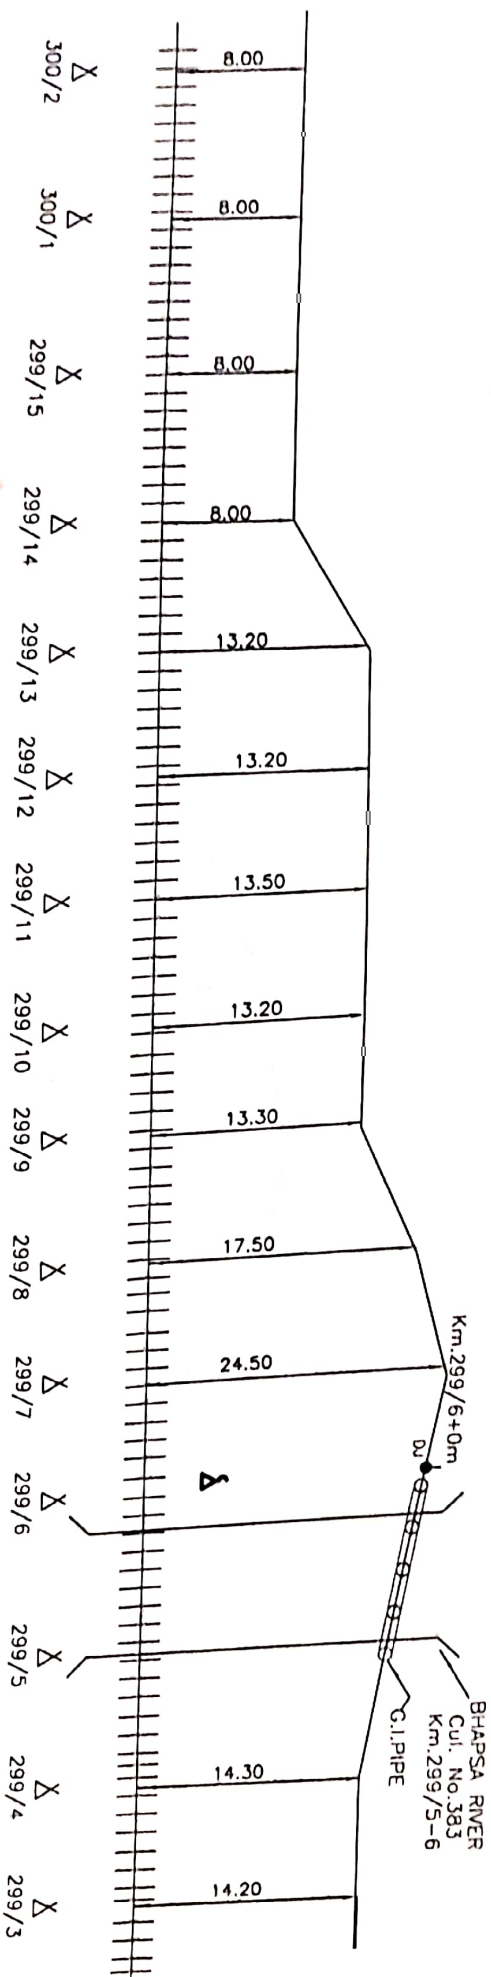

Arup Kumar
CONTRACTOR

Sebastian
SE/TELE/CON/GKP

13/7/13
ADSTE/CON/EAST/GKP

18/9/13
DY.CSTE/CON/EAST/GKP

N. E. RAILWAY

Customer Name: M/S ANUP KUMAR, DURGAHARI ROAD NEAR PAKKI BACH GATE, GORAKHPUR - PANIYAHWA

Prepared By: 47

CREATED ON: OFFERED BY: AK

REVISION NO: APPR BY: N.E.R.V.

MODIFIED ON: Ref no - NE/

Location: --- GORAKHPUR - PANIYAHWA



Not to Scale
All reading in mts

1-JOINT MARKER	0 DU	DUCT JOINT MARKER	▽	LC. GATE PHONE	1 DU	DERIVATION JOINT	SHEET NO. 47	CREATED BY	AK	Location: ---
RAILWAY CROSSING	++	RAILWAY TRACK		POLE	Δ	EMERGENCY POST	CREATED ON	OFFERED BY	AK	GORAKHPUR -
BRIDGE/CULVERT	□	G.I. PIPE	Δ	RAILWAY OVER BRIDGE	Δ	NORMAL JOINT	REVISION NO	APPR BY	N.E.R.V.	PANIYAHWA
DUCT pipe		HOPE	≡≡≡	RAILWAY UNDER BRIDGE	—	6 QUAD CABLE	MODIFIED ON			

← GKP

ROUTE PLAN FOR PANIYAHWA - VALMIKI NAGAR SECTION (6 QUAD CABLE)

VKNR →

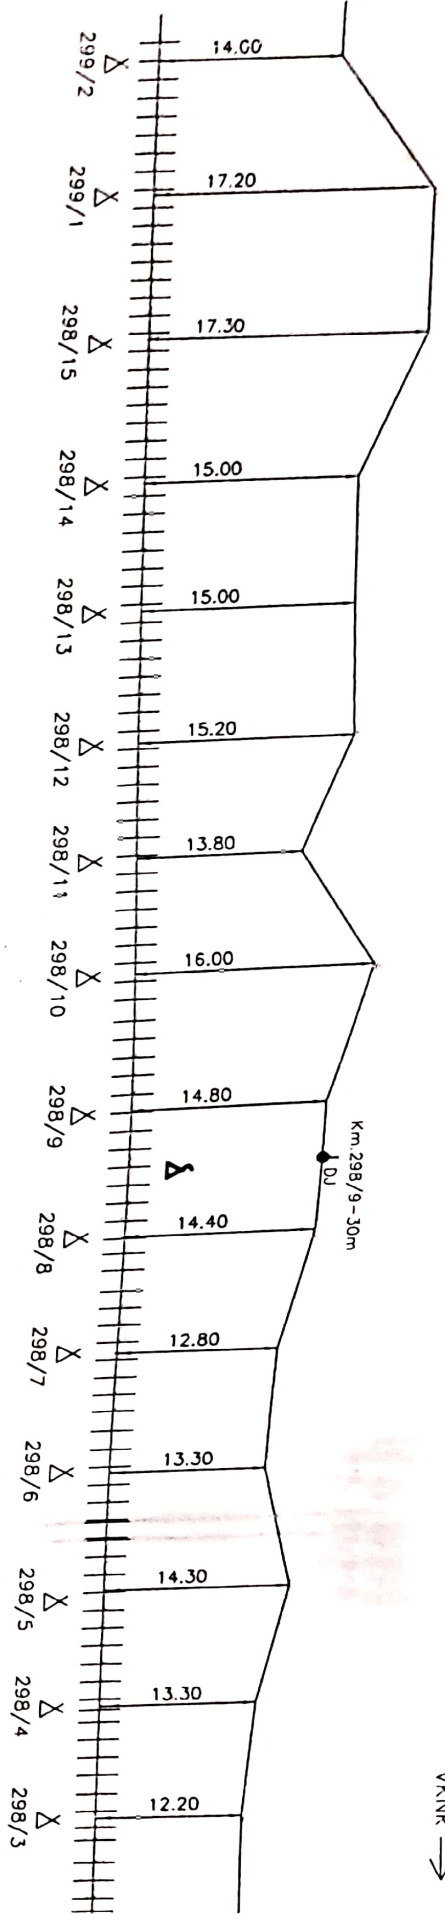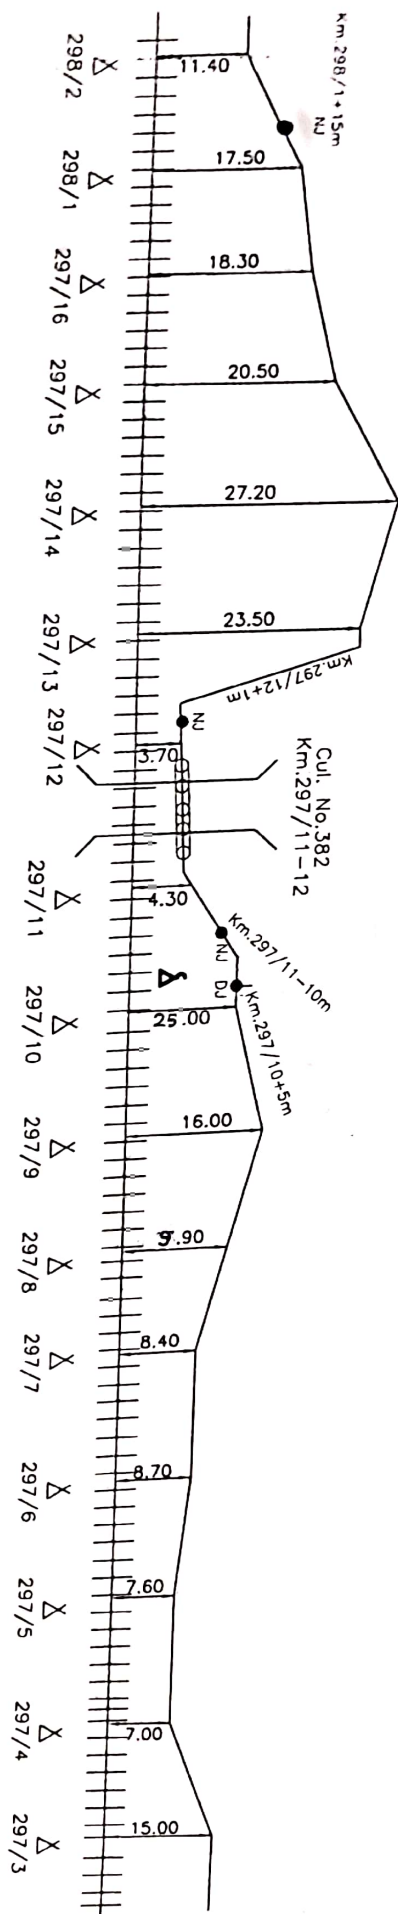

Contractor
SE/TELE/CON/GKP
ADSTE/CON/EAST/GKP
DY.CSTE/CON/EAST/GKP

Sub
19/5/13


Not to Scale
All reading in mts

Customer Name		N. E. RAILWAY		Location	
Prepared By :		M/S ANUP KUMAR DURGABARI ROAD NEAR PAKKI BAGH GATE, GORAKHPUR		GORAKHPUR - PANIYAHWA	
SHEET NO.	48	CREATED BY	AK	OFFERED BY	AK
CREATED ON		APPROVED BY	N E RLY		
REVISION NO.					
UNORDERED ON		6 QUAD C/BLE			

1-JOINT MARKER		DUCT JOINT MARKER		L.C. GATE PHONE		DERIVATION JOINT		EMERGENCY POST		NORMAL JOINT	



 


