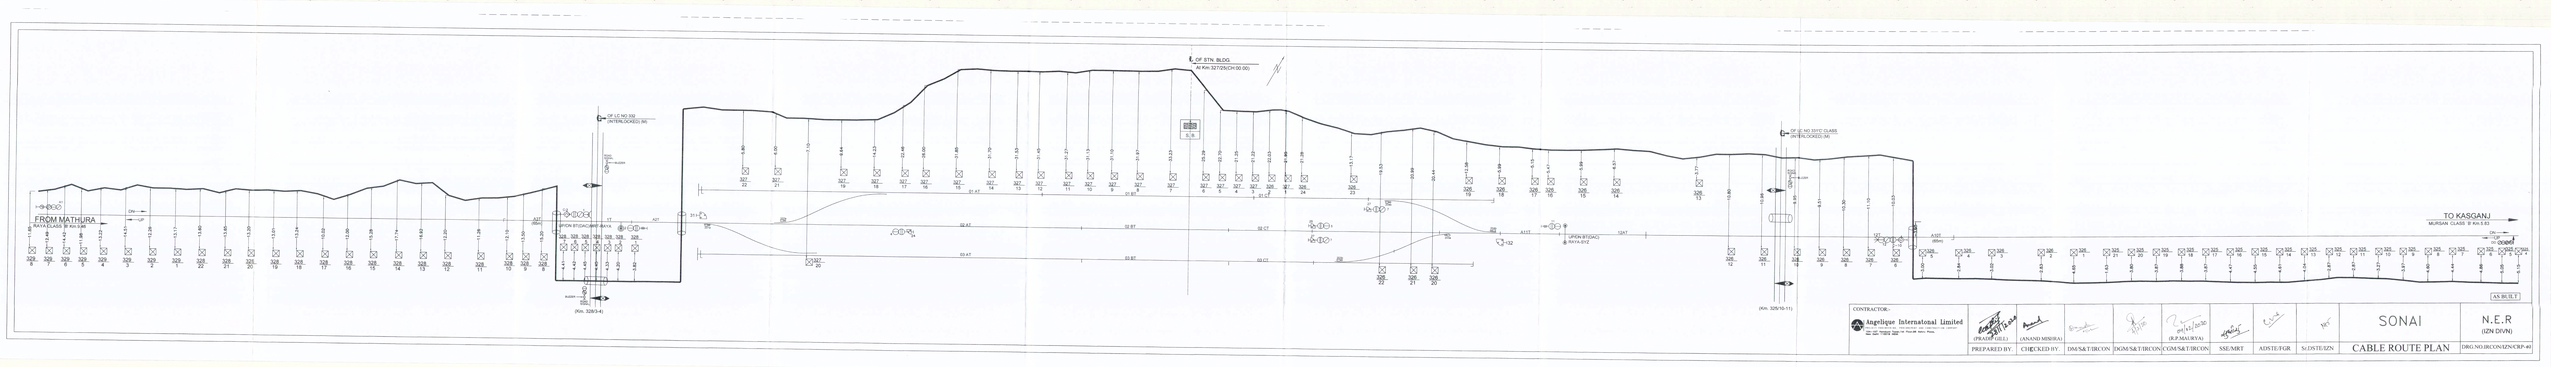

AS BUILT

CONTRACTOR :-
Angelique International Limited

(PRADIP LELL)	(ANAND MISHRA)							SONAI	N.E.R (IZN DIVN)
PREPARED BY.	CHECKED BY.	DM/S&T/IRCON	DGM/S&T/IRCON	COM/S&T/IRCON	SSE/MRT	ADSTE/TGR	Sr.DSTE/IZN	CABLE ROUTE PLAN	DRG.NO.IRCON/IZN/CRP-40