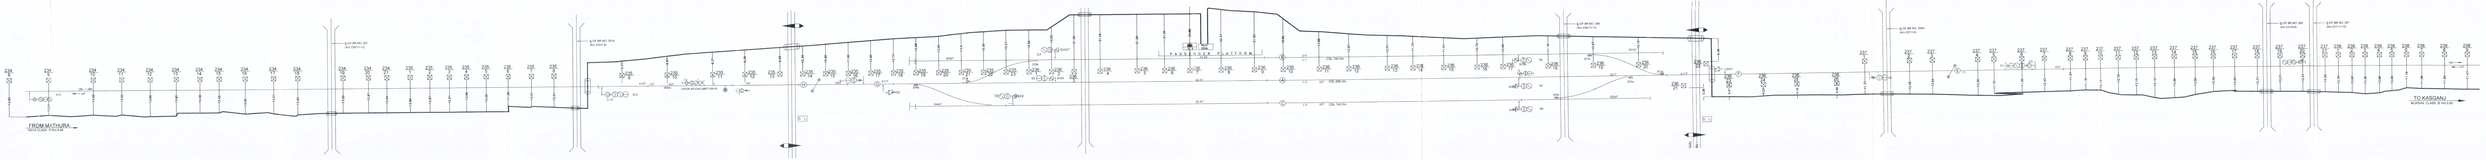

AS BUILT

CONTRACTOR: Angelique International Limited (An ISO 9001:2008 Company) Regd. Office: 2nd Floor, Plot No. 2, Sector - 19, Dwarka, New Delhi - 110 075 Corp. Off.: Plot No. 3, Sector - 19, Dwarka, New Delhi - 110 075	(PRADEEP GILL)	(ANAND MISHRA)			(R.P.MAURYA)			Sr DSTE/SZN	BADHARIKALAN	N.E.R (IZN DIVN)
	PREPARED BY:	CHECKED BY:	DM/S&T/IRCON	DGM/S&T/IRCON	CGM/S&T/IRCON	SSE/MRT	ADSTE/GR	Sr DSTE/SZN	CABLE ROUTE PLAN	DRG.NO.IRCON/IZN/CRP/-