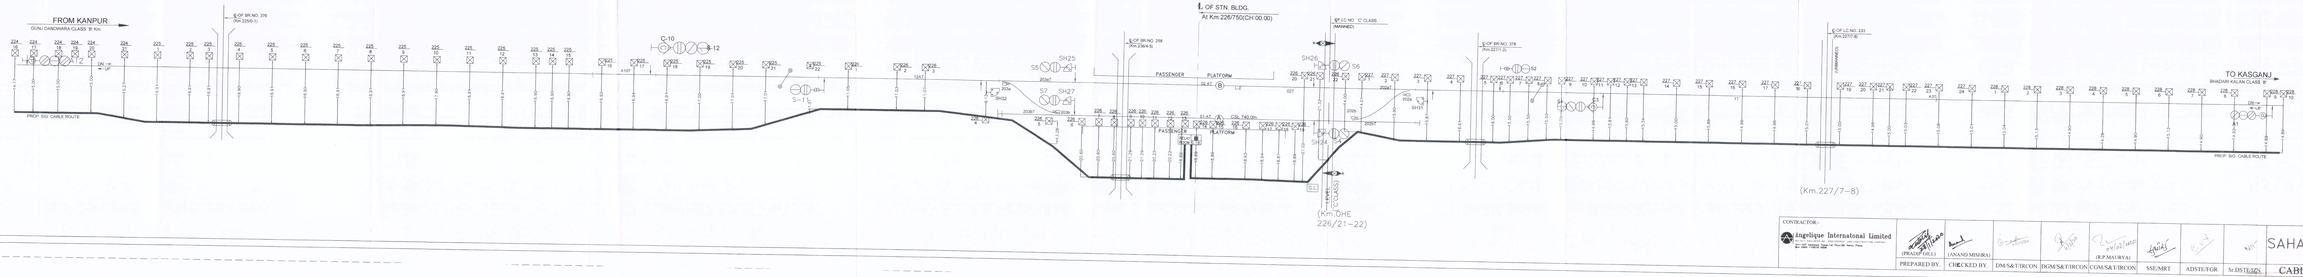

AS BUILT

CONTRACTOR:-

Angelique Internatonal Limited

PREPARED BY.	CHECKED BY.	DM/S&T/IRCON	DGM/S&T/IRCON	CGM/S&T/IRCON	SSE/MRT	ADSTE/FGR	Sr.DSTE/GKP
(PRADIP GILL)	(ANAND MISHRA)			(R.P.MAURYA)			

SAHAWAR TOWN

CABLE ROUTE PLAN

N.E.R
(IZN DIVN)

DRG.NO.IRCON/IZN/CRP-□